

PERMIT

SEWAGE DISPOSAL SYSTEM

MARYLAND STATE DEPARTMENT OF HEALTH

HOWARD COUNTY

ELLICOTT CITY

INDEXED

DISTRICT

DATE 10/25/69

P 14905

A 09616

11/4/69
A. Toner

Walter A. Shank IS PERMITTED TO INSTALL ☒ ALTER

ADDRESS Walt Ann Drive, Ellicott City, Md. PHONE 531-3651

A SEWAGE DISPOSAL SYSTEM LOCATED AT

SUBDIVISION Telegraphia Glen ROAD Walt Ann Drive LOT 18

PROPERTY OWNER same as above

ADDRESS

SPECIFICATIONS - 3 bedrooms

DRAIN FIELD DEPTH FEET, BOTTOM AREA SQ. FT.

SEEPAGE PITS ABSORBENT SIDEWALL AREA SQ. FT.

SEPTIC TANK CAPACITY 750 GALLONS

FOR GARBAGE GRINDER, INCREASE DISPOSAL AREA 22% & TANK CAPACITY 50%.

OTHER Dry well 11 ft. in dia. by 7 ft. deep below the inlet located 200 ft. from the front property line and 76 ft. off the left side property line as shown when facing the lot from Holly Quarter Drive. Locate inlet 6 ft. below original grade.

NOTE: ALL PIPE FROM HOUSE TO SEPTIC TANK MUST BE CAST IRON.

PERMIT VOID AFTER THREE YEARS.

PLANS APPROVED BY J. Morrison DATE 5/27/69

FILL SEPTIC TANK AND DISTRIBUTION BOX WITH WATER BEFORE CALLING FOR AN INSPECTION. COVER NO WORK UNTIL INSPECTED AND APPROVED.

NEITHER THE HOWARD COUNTY COMMISSIONERS NOR THE HEALTH DEPARTMENT IS RESPONSIBLE FOR THE SUCCESSFUL OPERATION OF ANY SYSTEM.

NOTIFY THE HEALTH DEPARTMENT 48 HOURS BEFORE EXCAVATIONS ARE TO BE BACK FILLED.

A 09616

DATE SYSTEM APPROVED 11/9/59 INSPECTOR S. Jones

REMARKS

ASSURMENT AREA 456 SQ. FT.

SEWAGE PITS, MANHOLE MANHOLE 12112 FT. DEPTH BELOW INLET 96 FT.

NUMBER OF TRENCHES 1 INITIAL BOTTOM AREA 96 FT.

GRAVEL DEPTH 1 IN. TOTAL LENGTH 1 FT.


TILE FIELD, DEPTH 1 FT. TRENCH WIDTH 1 FT.

DISTRIBUTION BOX, LEVEL 1

SEPTIC TANK, LEVEL OK 7500

PERMIT CARD OK 7500

CELESTIALS OK

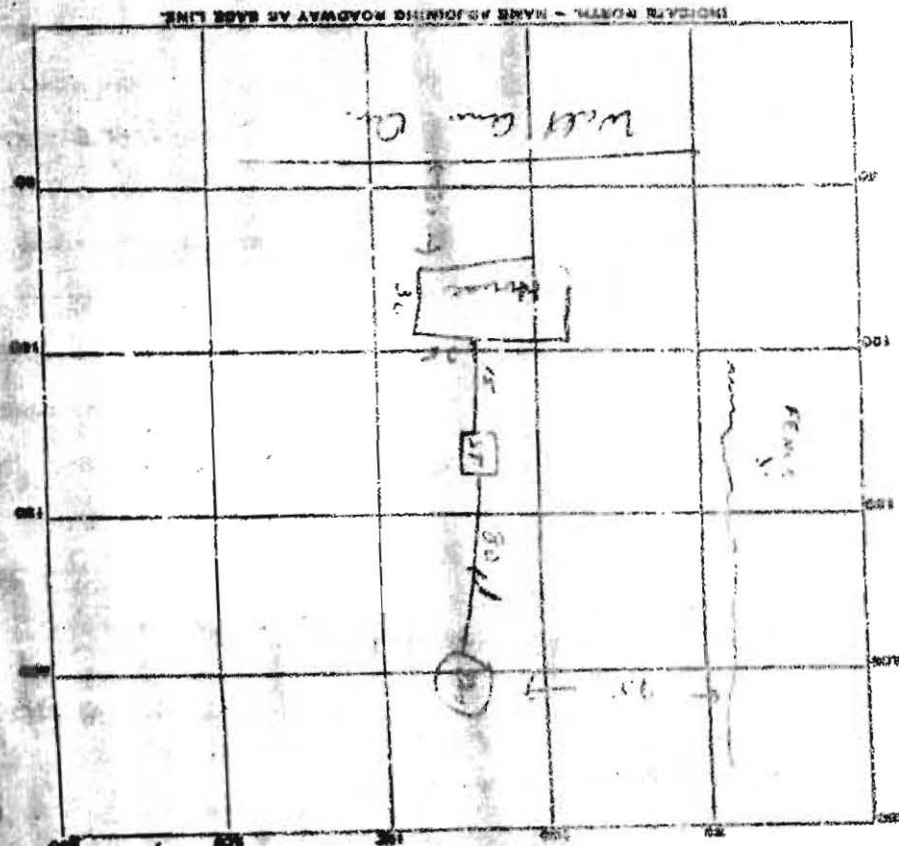

456
12112
96
1
1
1
OK 7500
OK

SOIL AUGER FINDING

TESTED BY *John D. Smith*

REMARKS *Soil sample taken from 1st*

ALSO PRESENT *Soil sample taken from 1st*

LOT NO. *16*

DATE	TEST NO.	DEPTH	START	STOP	START	STOP	TEST - IN STOP	TIME
7-24-65	1	1.5m	11:32	11:38	11:18	11:46	8m	
	2	1.5m	11:34	11:38	11:38	11:44	6m	
	3	5'	11:41	11:43	11:43	11:46	3m	
	4	1.5m	11:43	11:47	11:47	11:53	6m	

on floor
from 5757

