

APPLICATION

SEWAGE DISPOSAL TESTING

MARYLAND STATE DEPARTMENT OF HEALTH

HOWARD COUNTY

ELLICOTT CITY

A 09610

P

3 bedrooms

DISTRICT 3

DATE 2/8/65

Dry well 11 ft. in dia. by 10 ft. deep, below the inlet located 22 ft. from the front property line and 38 ft. off the left side property line as seen when facing the lot from Folly Quarter Drive. Inlet 4 ft. below original grade. 750 gal. septic tank.

4 bedrooms

Same as above with specifications: Dry well 12 ft. in dia. by 12 ft. deep below the inlet. 1000 gal. septic tank.

TO: THE COUNTY HEALTH OFFICER
ELLICOTT CITY, MARYLAND

I, HEREBY, APPLY FOR THE NECESSARY TESTS IN ORDER TO CONSTRUCT (OR RECONSTRUCT) A SEWAGE DISPOSAL SYSTEM.

PROPERTY OWNER Walter A. Shank

ADDRESS Avoca Ave., Ellicott City, Md. PHONE HO 5-3464

PROPERTY LOCATION:

SUBDIVISION XXXXXXXXXXXXX Shepherd Glen LOT NO. 6

ROAD AND DESCRIPTION Walt-Ann Drive
XXXXXXXXXXXXX & Sky Way

OCCUPANT _____ PHONE _____

PERSON TO CONSTRUCT SYSTEM _____

ADDRESS _____ PHONE _____

SIZE OF LOT 1.08 acres TYPE BLDG. 3 or 4

NUMBER OF BEDROOMS

IF NOT SINGLE RESIDENCE DESCRIBE _____

SIGNATURE OF APPLICANT /s/ Walter A. Shank

APPROVED BY [Signature] FOR [Signature] DATE 5-27-65

(KIND OF SYSTEM)


REJECTED BY _____ FOR _____ DATE _____

(KIND OF SYSTEM)

HOLD PENDING FURTHER TESTS _____ DATE _____

REASONS FOR REJECTION OR HOLDING _____

THIS IS NOT A PERMIT

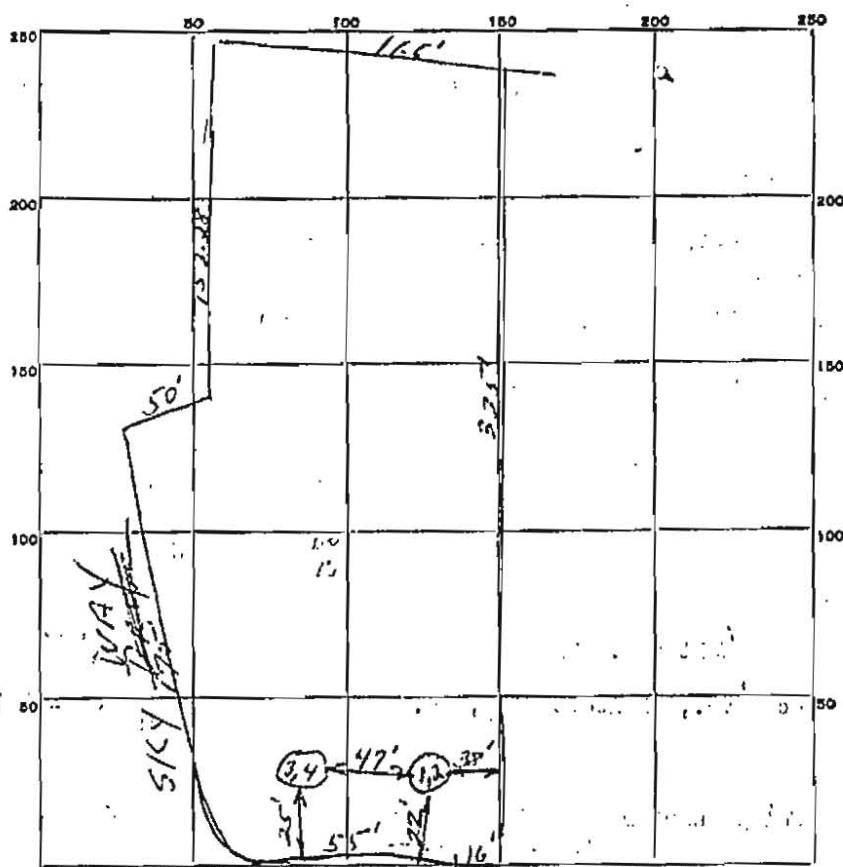

Folly Qtr. Drive.

[illegible]

Asst. Perc. Tonia
8, 5 Miles

SOIL AUGER FINDING.

TESTED BY

REMARKS.

ALSO PRESENT.

LOT NO. 1a