

10/19/65
[Signature]

10/18/65 - Approved - R.F.

PERMIT

SEWAGE DISPOSAL SYSTEM

P 10697

A 09610

MARYLAND STATE DEPARTMENT OF HEALTH

HOWARD COUNTY

ELLICOTT CITY

INDEXED *Incomplete* 10/18/65 - R.F.

DISTRICT 3

DATE 8/4/65

Walter A. Shank IS PERMITTED TO INSTALL X ALTER

ADDRESS Rt. 2 - Ellicott City, Md. PHONE 286-3410

A SEWAGE DISPOSAL SYSTEM LOCATED AT _____

SUBDIVISION Shepards Glen 3901 ROAD Walt-Ann Drive & Sky Way LOT 6

PROPERTY OWNER _____

ADDRESS _____

SPECIFICATIONS - 3 bedrooms

DRAIN FIELD _____ DEPTH _____ FEET, BOTTOM AREA _____ SQ. FT.

SEEPAGE PITS _____ ABSORBENT SIDE-WALL AREA _____ SQ. FT.

SEPTIC TANK CAPACITY 750 GALLONS

FOR GARBAGE GRINDER, INCREASE DISPOSAL AREA 22% & TANK CAPACITY 50%.

OTHER Dry well 11 ft. in dia. by 10 ft. deep below the inlet located 22 ft. from the front property line and 38 ft. off the left side property line as seen when facing the lot from Folly Quarter Drive. Locate inlet 4 ft. below original grade.

PLANS APPROVED BY J. Hannigan DATE 5/27/65

FILL SEPTIC TANK AND DISTRIBUTION BOX WITH WATER BEFORE CALLING FOR AN INSPECTION. COVER NO WORK UNTIL INSPECTED AND APPROVED.


NEITHER THE HOWARD COUNTY COMMISSIONERS NOR THE HEALTH DEPARTMENT IS RESPONSIBLE FOR THE SUCCESSFUL OPERATION OF ANY SYSTEM.

A 09610

11 by 12
3 4 5

12 by 12
4 5 2 2 1/2 ft.

14
- 4 1/2
9 1/2 ft. d. p. b. inlet

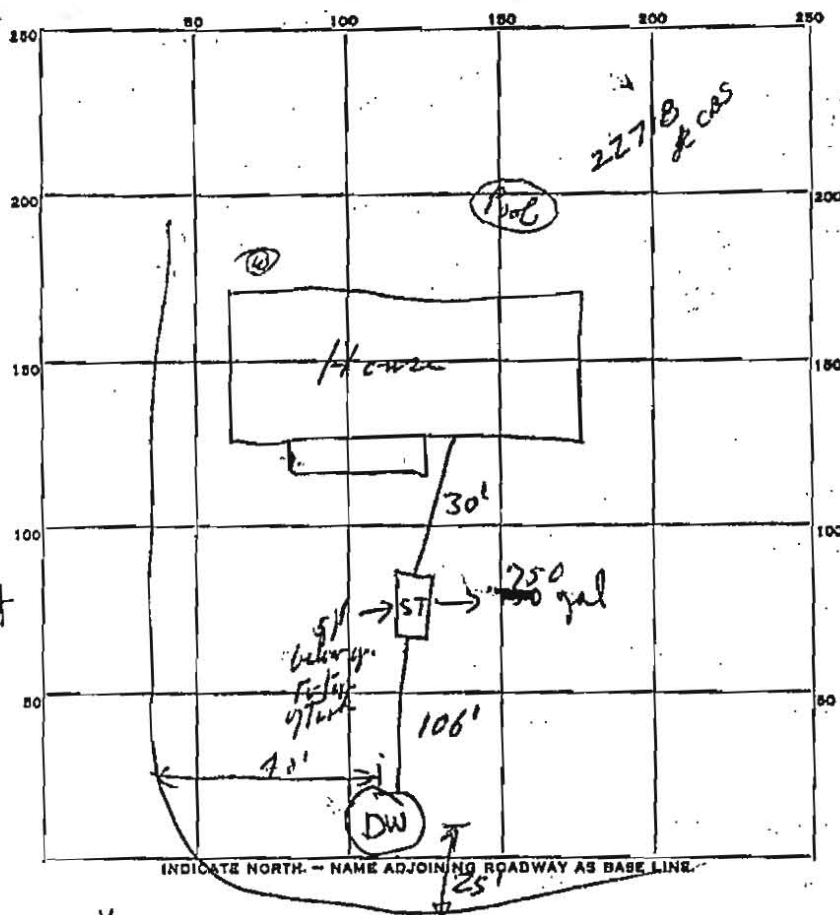

PERMIT CARD OK

SEPTIC TANK, LEVEL OK

CLEANOUTS OK

DISTRIBUTION BOX, LEVEL _____

TILE FIELD, DEPTH _____ FT. TRENCH WIDTH _____ FT.

GRAVEL DEPTH _____ IN. TOTAL LENGTH _____ FT.

NUMBER OF TRENCHES _____ TOTAL BOTTOM AREA _____

SEEPAGE PITS, INSIDE DIAMETER 9 1/2 FT. DEPTH BELOW INLET 9 1/2 FT.

ABSORBENT AREA 286 SQ. FT.

REMARKS D.W. to D.W. dia = 12 ft. by 9 1/2 ft dpr = 356 sq. ft.
Incomplete (10/7/65 - eliminate crack in top and chugwell - R.F.)

DATE SYSTEM APPROVED 10/10/65 INSPECTOR R.F. [Signature]