

HOWARD COUNTY
PERMIT APPLICATION

PERMIT NUMBER

1500144008 BB

Building Address 12642 Hilltop Road

Property Owner's Name VERNON PURSEL

Address 12642 Hilltop Road

Suite/Apt. #: _____ SDP/WP/Petition #: _____

City Hilltop State MD Zip Code 21077

Census Tract 605102 Subdivision _____

Home Phone 301-854-9758 Work Phone N/A

Section _____ Area _____ Lot _____

Applicant's Name & Mailing Address, (if other than stated hereon):

Tax Map 40 Parcel 334 Grid 11

1 (301) 399-5708

Zoning RPOD Map Coordinates 14C13 Lot size 2.01

Phone _____ Fax _____

Existing Use SFD

Contractor Company BRENTWOOD BUILDERS

Proposed Use SFD Addition

Contact Person BRENT JOHNSON

Estimated Construction Cost \$ 50,000 w/ 2500 sq ft

Address 17116 SPRING HOLLOW COURT

Description of Work Garage / Master bedroom

City MT. AIRY State MD Zip Code 21791

addition above, Deck 12'x8'

License No. 410-619

Work Room / Work shop in Garage

Phone 410-290-8711 Fax (301) 399-5708

Occupant or Tenant same

Engineer or Architect Company Brent Johnson

Contact Name _____

Contact Person _____

Address _____

Address 5712 Main St.

City _____ State _____ Zip Code _____

City Hilltop State MD Zip Code 21043

Phone _____ Fax _____

Phone 410-337-930 Fax 410-465-3703

BUILDING DESCRIPTION - COMMERCIAL

BUILDING DESCRIPTION - RESIDENTIAL

Building Characteristics

Utilities

Height: _____

Water Supply: _____

No. of stories: _____

Public _____

Gross area, sq. ft. per floor: _____

Private _____

Use group: _____

Sewage Disposal: _____

Construction type: _____

Public _____

Reinforced Concrete _____

Private _____

Structural Steel _____

Electric Yes ☐ No ☐

Masonry _____

Gas Yes ☐ No ☐

Wood Frame _____

Heating System: _____

State Certified Modular _____

Electric ☐ Oil ☐

Natural Gas ☐

Propane Gas ☐

Sprinkler system: N/A ☐

Full _____

Partial _____

Other Suppression _____

of Heads _____

Building Characteristics

Utilities

SF Dwelling ☐ SF Townhouse ☐

Water Supply: _____

Depth _____ Width _____

Public _____

1st floor: _____

Private _____

2nd floor: _____

Sewage Disposal: _____

Basement: _____

Public _____

Finished Basement ☐ Unfinished Basement ☐

Private _____

Crawl space ☐ Slab on Grade ☐

Electric Yes ☐ No ☐

No. of Bedrooms _____

Gas Yes ☐ No ☐

Multi-family dwellings: _____

Heating System: _____

No. of efficiency units: _____

Electric ☐ Oil ☐

No. of 1 BR units: _____

Natural Gas ☐

No. of 2 BR units: _____

Propane Gas ☐

No. of 3 BR units: _____

Sprinkler system: N/A ☐

Other Structure: _____

NFPA #13D _____

Dimensions: _____

NFPA #13R _____

Footings: _____

Other: _____

Roof: _____

State Certified Modular _____

Manufactured Home _____

THE UNDERSIGNED HEREBY CERTIFIES AND AGREES AS FOLLOWS: (1) THAT HE/SHE IS AUTHORIZED TO MAKE THIS APPLICATION; (2) THAT THE INFORMATION IS CORRECT; (3) THAT HE/SHE WILL COMPLY WITH ALL REGULATIONS OF HOWARD COUNTY WHICH ARE APPLICABLE THERETO; (4) THAT HE/SHE WILL PERFORM NO WORK ON THE ABOVE REFERENCED PROPERTY NOT SPECIFICALLY DESCRIBED IN THIS APPLICATION; (5) THAT HE/SHE GRANTS COUNTY OFFICIALS THE RIGHT TO ENTER ONTO THIS PROPERTY FOR THE PURPOSE OF INSPECTING THE WORK PERMITTED AND POSTING NOTICES.

Applicant's Signature

Print Name

Title/Company

Date

Checks payable to: DIRECTOR OF FINANCE OF HOWARD COUNTY

** PLEASE WRITE NEATLY AND LEGIBLY. **

- FOR OFFICE USE ONLY -

AGENCY DATE SIGNATURE APPROVAL

DPZ SETBACK INFORMATION

PROPERTY ID#

Land Development, DPZ

Front: _____

Filing fee \$ 25

State Highways

Rear: _____

Permit fee \$ _____

Building Official

Side: _____

Excise tax \$ _____

Dev. Engineering, DPZ

Side St.: _____

Add'l per. fee \$ _____

Health

All minimum setbacks met?

TOTAL FEES \$ _____

Fire Protection

YES ☐ NO ☐

Sub-total paid \$ _____

Is Sediment Control approval required prior to issuance?

Is Entrance Permit required?

Balance due \$ _____

YES ☐ NO ☐

YES ☐ NO ☐

Check # _____

CONTINGENCY CONSTRUCTION START: ☐

Historic District?

Validation # 2275

ONE STOP SHOP: ☐

YES ☐ NO ☐

Lot Coverage for New Town Zone _____

SDP/Red-line approval date _____

Accepted by A

Distribution of Copies-


White: Building Official

Green: LDD, DPZ

Yellow: DED, DPZ

Pink: Health

Gold: SHA

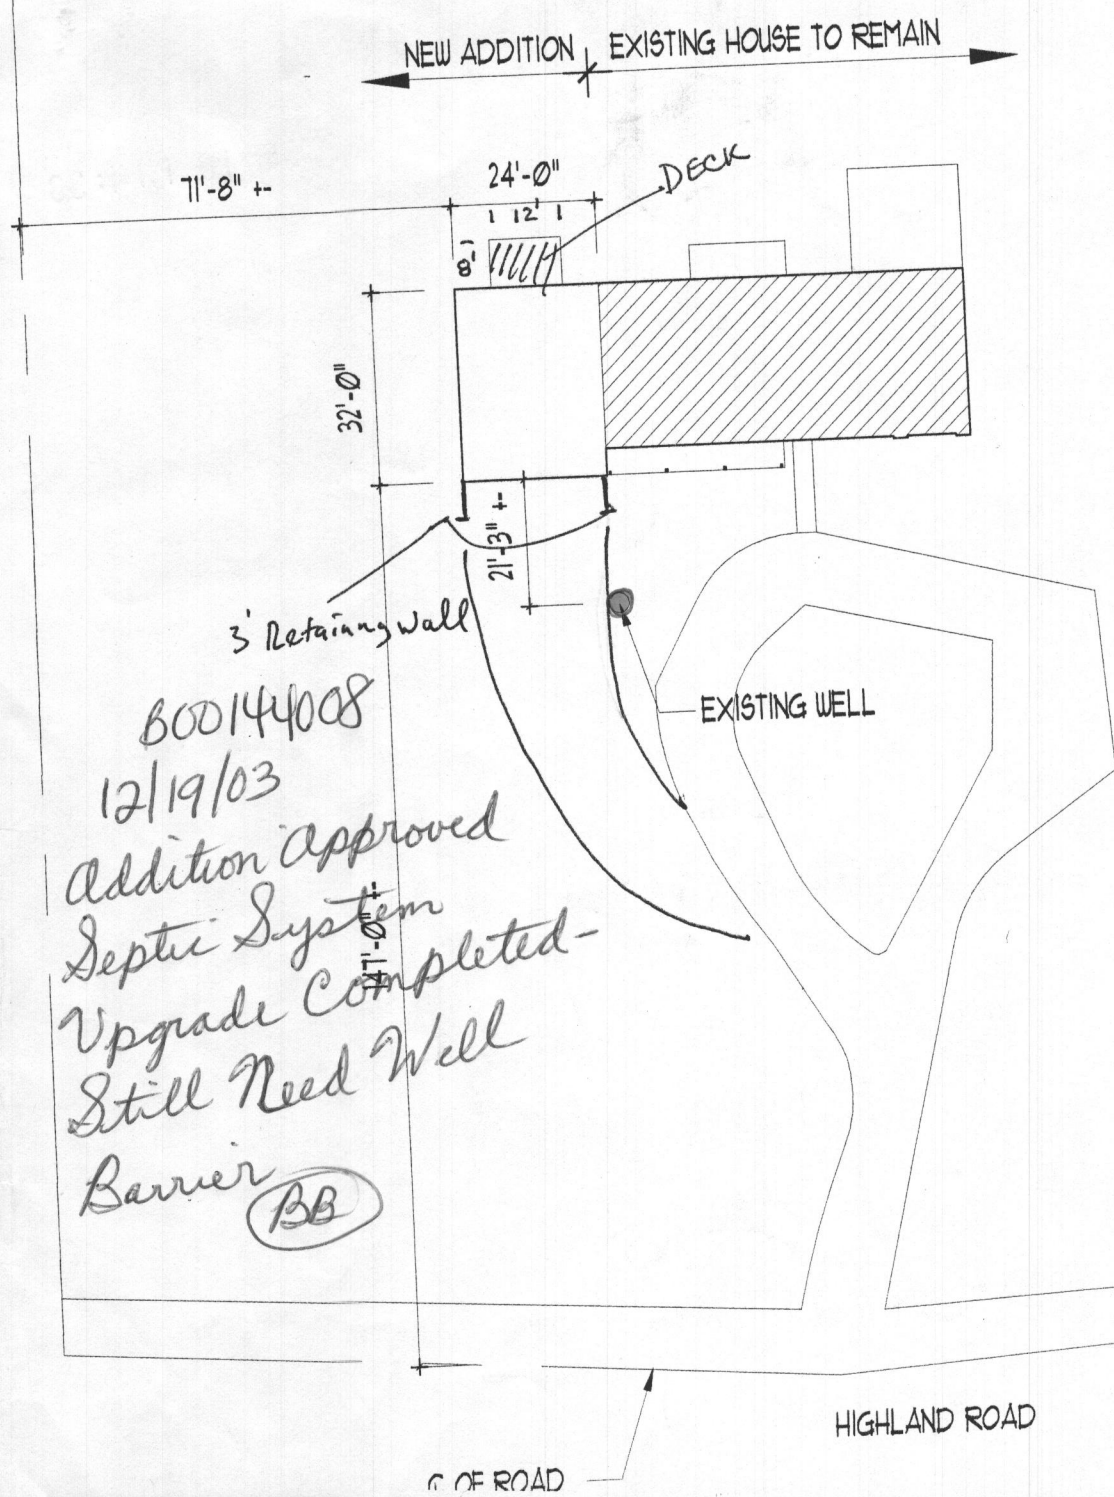

B00144008
12/19/03
Addition approved
Septic System
Upgrade Completed -
Still Need Well
Barrier
(BB)