

APPLICATION

SEWAGE DISPOSAL TESTING

STATE OF MARYLAND - DEPARTMENT OF HEALTH AND MENTAL HYGIENE

HOWARD COUNTY HEALTH DEPARTMENT
ENVIRONMENTAL HEALTH SERVICES

P. O. BOX 476 ELLICOTT CITY, MARYLAND 21043
TELEPHONE: 992-2330

A 35020

P _____

DISTRICT 4th.

DATE 2/15/85

TO: THE COUNTY HEALTH OFFICER
ELLICOTT CITY, MARYLAND

I, HEREBY, APPLY FOR THE NECESSARY TEST IN ORDER TO CONSTRUCT (OR RECONSTRUCT) A SEWAGE DISPOSAL SYSTEM.

PROPERTY OWNER Sobrina 99, Inc.
12150 Tech Road
ADDRESS Silver Spring, Maryland 20904 PHONE Don Reuwer - 531-5252

PROPERTY LOCATION:
SOBRINA FARMS
SUBDIVISION Montgomery Industrial Park LOT NO. 6
ROAD AND DESCRIPTION Route 94

SIZE OF LOT 9.2 Acres TYPE BLDG. 3 or 4 Bedrooms
(NUMBER OF BEDROOMS)

THE SYSTEM INSTALLED UNDER THIS APPLICATION IS ACCEPTABLE ONLY UNTIL PUBLIC FACILITIES BECOME AVAILABLE. I FULLY UNDERSTAND THE
FEE CONNECTED WITH THE FILING OF THIS PERC TEST APPLICATION IS NON-REFUNDABLE UNDER ANY CIRCUMSTANCES. I ALSO AGREE TO COMPLY
WITH ALL M.O.S.H.A. REQUIREMENTS IN TESTING THIS LOT. /s/ Don Reuwer

(SIGNATURE OF APPLICANT)

APPROVED BY Sidney Ahe FOR Standard Tech DATE 8-8-89


REJECTED BY _____ FOR _____ DATE _____


HOLD PENDING FURTHER TESTS _____ DATE _____

REASONS FOR REJECTION OR HOLDING 3/12/85 PERC OK HOLD FOR PLAT R/H

3/19/85 Copy to Ballard R/H

THIS IS NOT A PERMIT

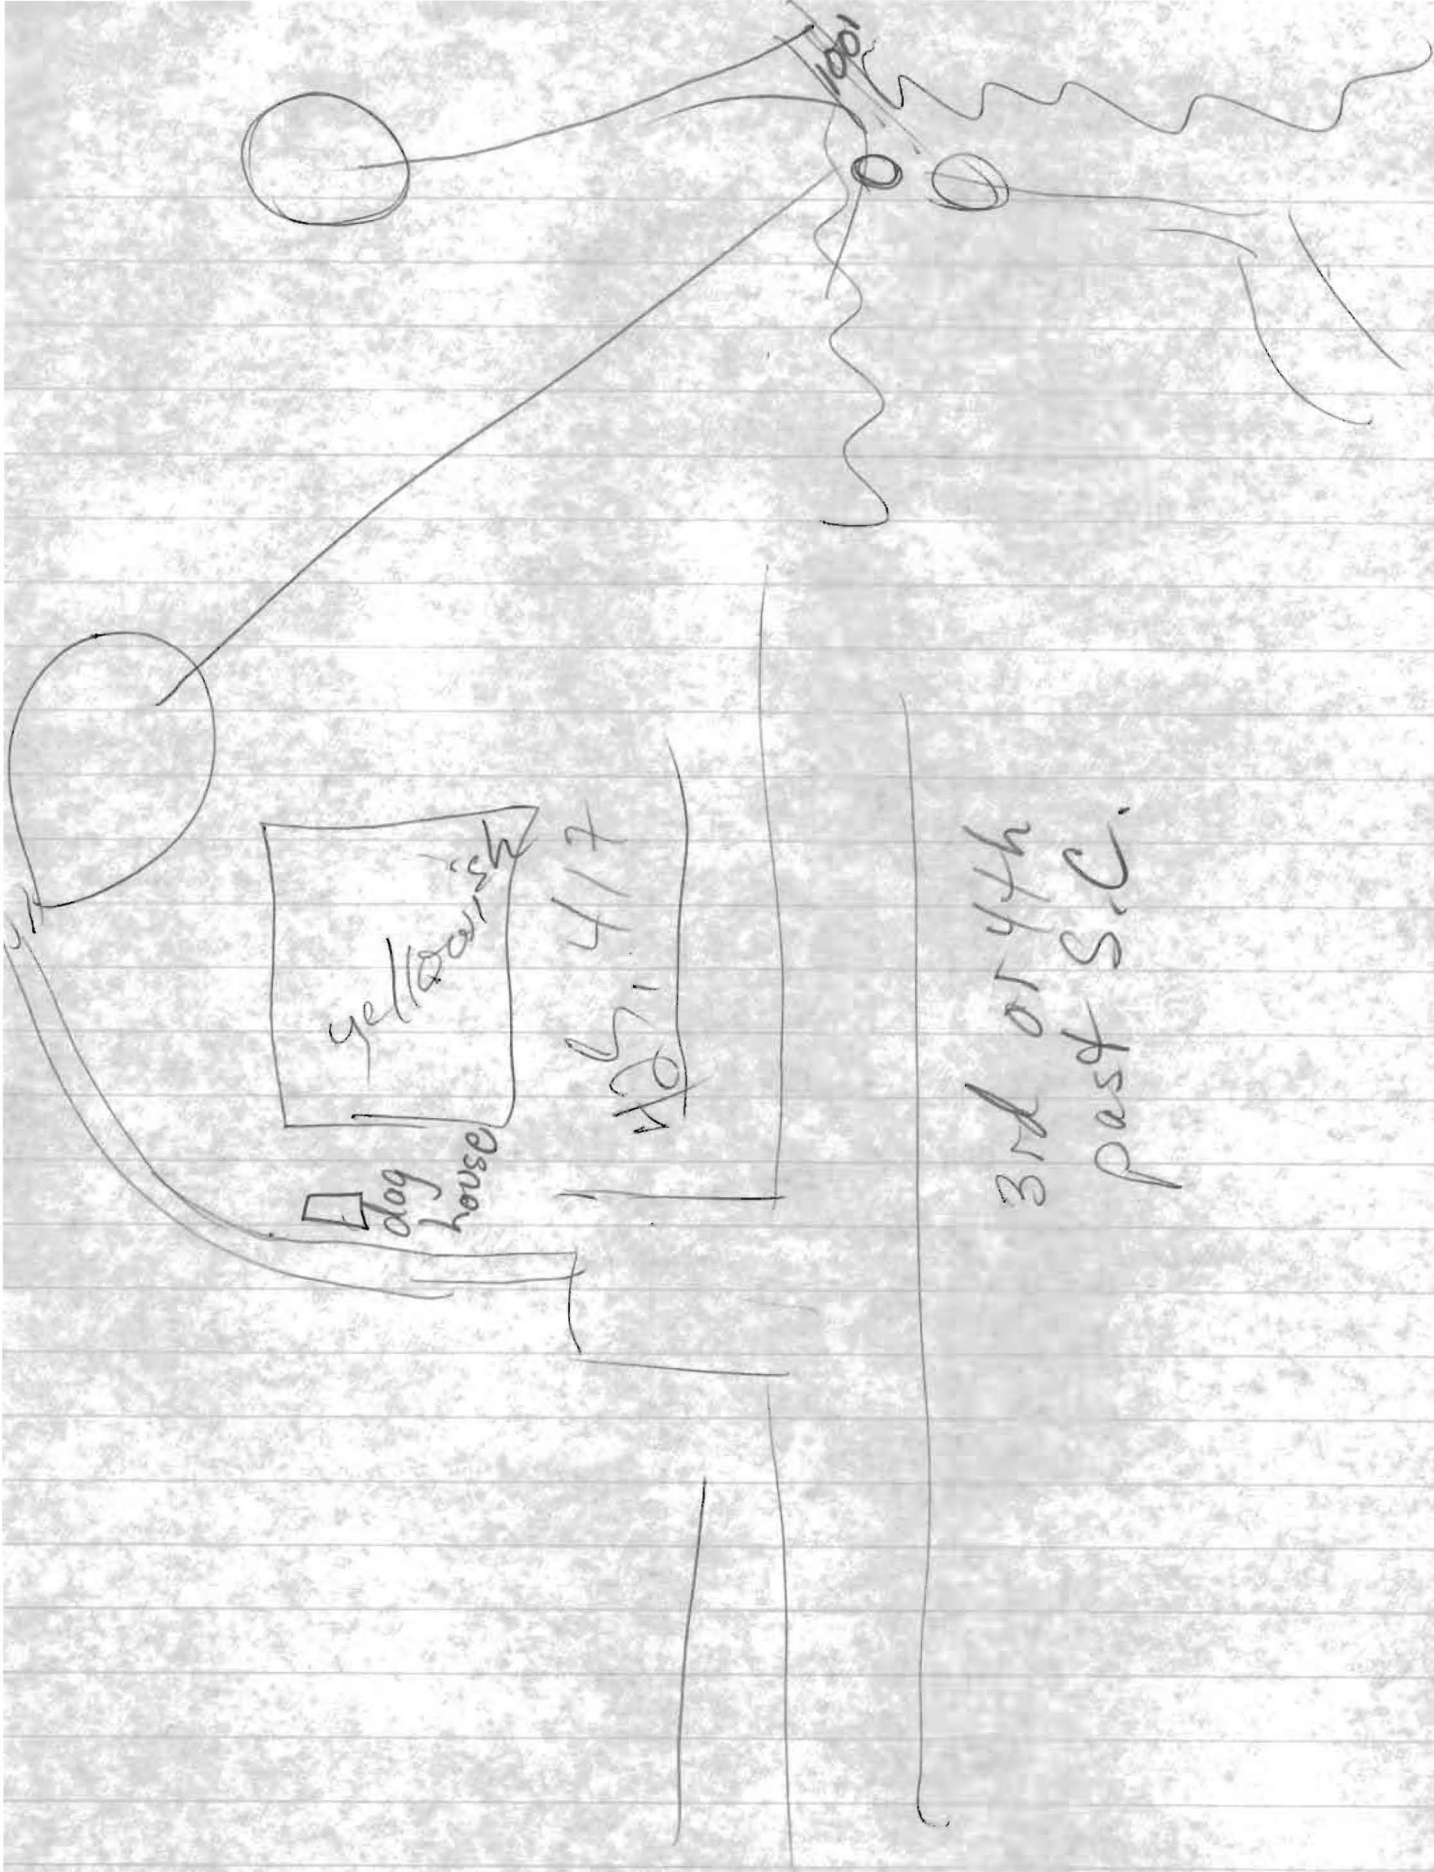

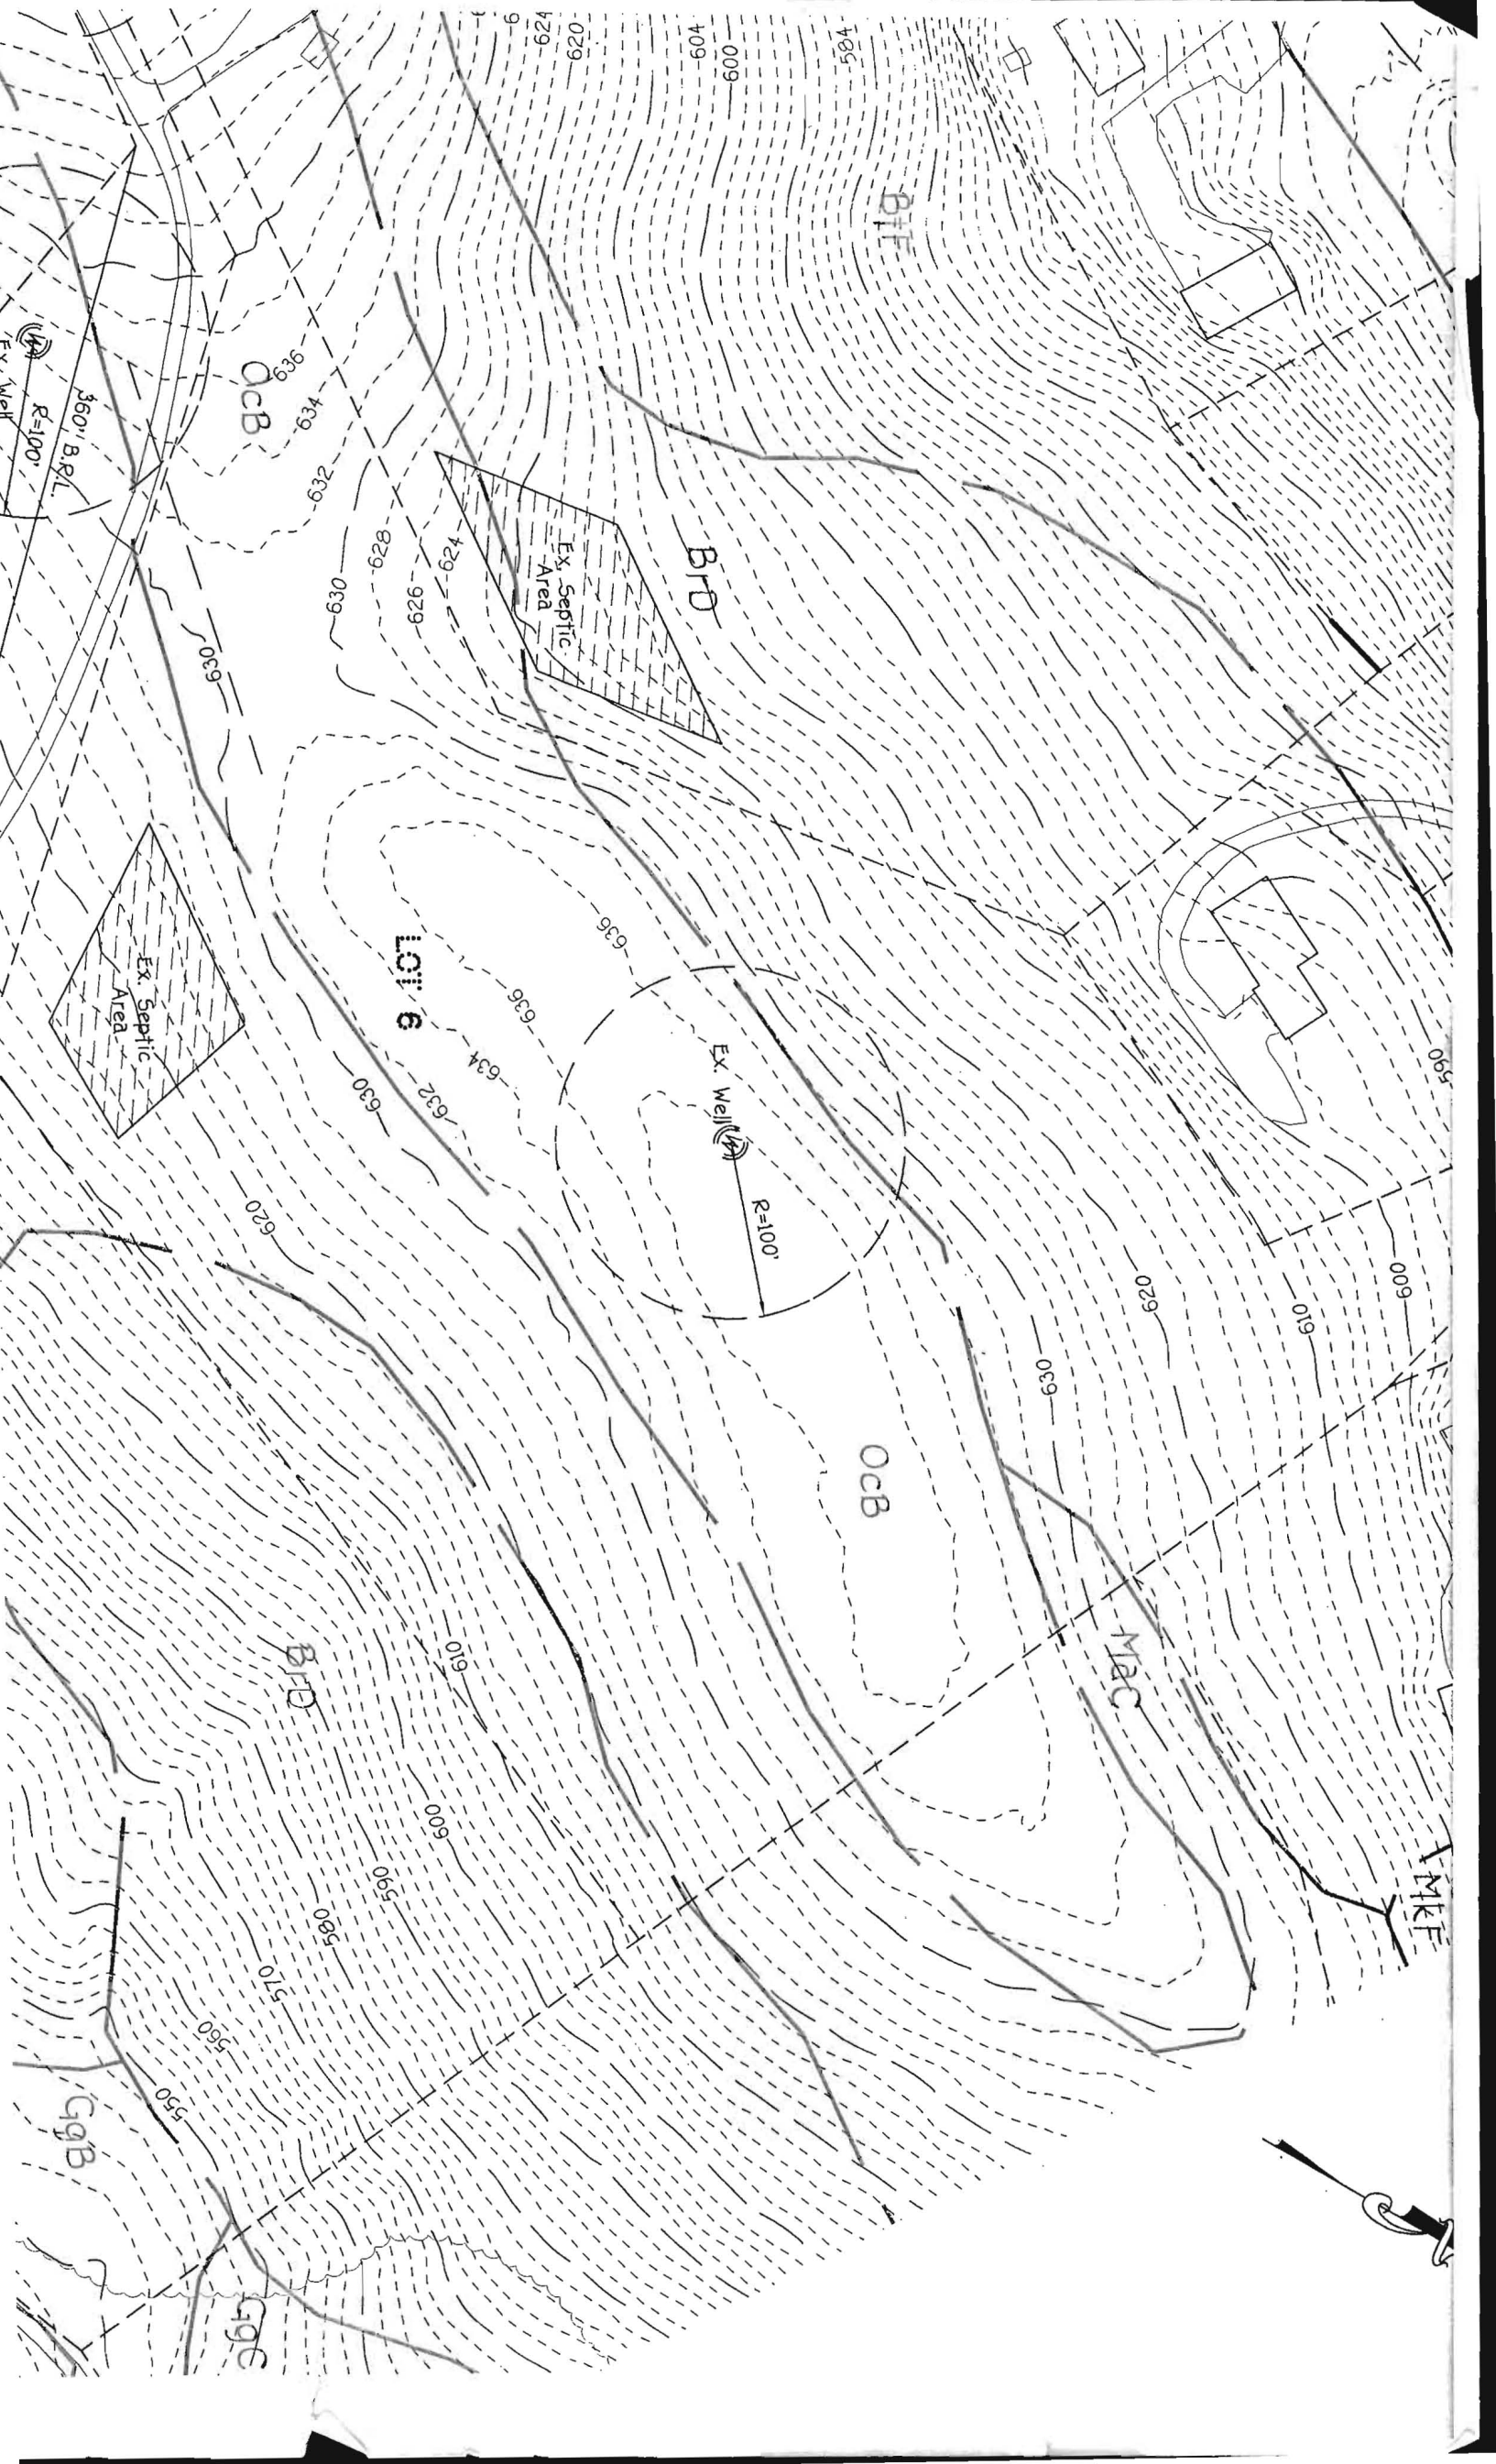

APPLICATION

SEWAGE DISPOSAL TESTING

STATE OF MARYLAND - DEPARTMENT OF HEALTH AND MENTAL HYGIENE

A 35020

P _____

HOWARD COUNTY HEALTH DEPARTMENT
ENVIRONMENTAL HEALTH SERVICES

P. O. BOX 476 ELLICOTT CITY, MARYLAND 21043
TELEPHONE: 992-2330

DISTRICT 4th.

DATE 2/15/85

TO: THE COUNTY HEALTH OFFICER
ELLICOTT CITY, MARYLAND

I, HEREBY, APPLY FOR THE NECESSARY TEST IN ORDER TO CONSTRUCT (OR RECONSTRUCT) A SEWAGE DISPOSAL SYSTEM.

PROPERTY OWNER Sobrina 99, Inc.
12150 Tech Road
ADDRESS Silver Spring, Maryland 20904 PHONE Don Reuwer - 531-5252

PROPERTY LOCATION:

SUBDIVISION Montgomery Industrial Park LOT NO. 6

ROAD AND DESCRIPTION Route 94

SIZE OF LOT 9.2 Acres TYPE BLDG. 3 or 4 Bedrooms
(NUMBER OF BEDROOMS)

THE SYSTEM INSTALLED UNDER THIS APPLICATION IS ACCEPTABLE ONLY UNTIL PUBLIC FACILITIES BECOME AVAILABLE. I FULLY UNDERSTAND THE
FEE CONNECTED WITH THE FILING OF THIS PERC TEST APPLICATION IS NON-REFUNDABLE UNDER ANY CIRCUMSTANCES. I ALSO AGREE TO COMPLY
WITH ALL M.O.S.H.A. REQUIREMENTS IN TESTING THIS LOT. /s/ Don Reuwer

(SIGNATURE OF APPLICANT)

APPROVED BY _____ FOR _____ DATE _____

REJECTED BY _____ FOR _____ DATE _____


HOLD PENDING FURTHER TESTS _____ DATE _____

REASONS FOR REJECTION OR HOLDING _____

THIS IS NOT A PERMIT

PERC HOLES OR STAKE ROCK WOODS
DUG SURVEY LOT 1

SOIL PROFILE
CLAY & TOPSOIL
BROWN SAND LOAM
13 1/2

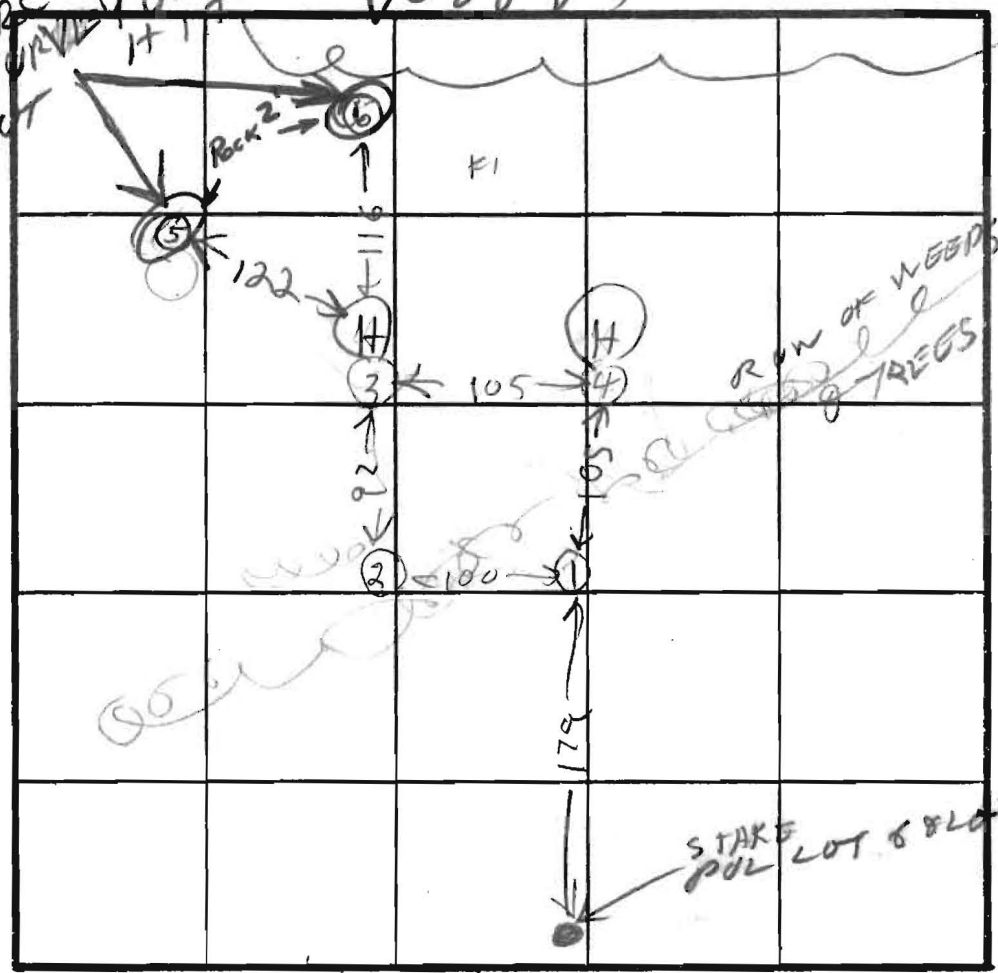

CLAY & TOPSOIL
PINKISH BROWN SAND LOAM & SOME SPAROLITE

INDICATE NORTH - NAME ADJOINING ROADWAY AS BASE LINE.

DATE	TEST NO.	DEPTH	PRE-WET		TEST - 1" DROP		TIME
			START	STOP	START	STOP	
3/12/85	1S	3	1123	1129	1129	1134	5
	1V	13 1/2	LOOKS	OK			
	2S	4	1127	1133	1133	1146	11
	2V	13	LOOKS	OK			
	3S	3	1131	1138	1138	1154	14
	3V	11	LOOKS	OK			
	4S	3	1137	1141	1141	1156	15
	4V	12	LOOKS	OK			
	5	2	ROCK				
	6	2	ROCK				

CLAY & TOPSOIL
BROWN SAND LOAM & SOME SPAROLITE

CLAY & TOPSOIL
PINK BROWN SAND LOAM & SOME SPAROLITE

air time
11 min
max depth
2 FT
IN LOT 3
MAX 15 1/2
2008

REMARKS HOLES 1 2 3 4 NOT DUG PER SURVEY OR STAKE HOLES

TYPE OF SOIL
TESTED BY B. HODGES
ALSO PRESENT OKLETTERMAN & POOL CLINT BALLARD Real Estate

