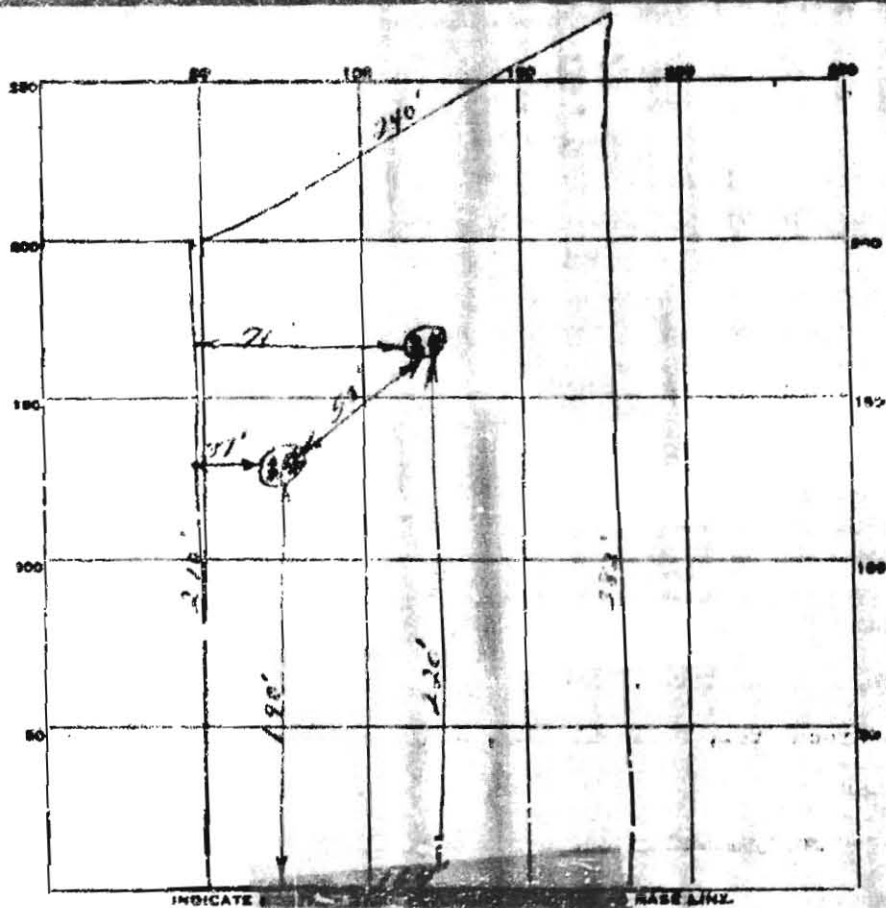


70-0067

C 1 5163 THIS NUMBER IS TO BE POSTED IN COL. 8 OF THE REPORT		STATE OF MARYLAND DEPARTMENT OF WATER RESOURCES STATE OFFICE BLDG., ANNAPOLIS, MARYLAND 21401 WELL COMPLETION REPORT		THIS REPORT MUST BE SUBMITTED WITHIN 30 DAYS AFTER COMPLETION OF THE WELL A 09-16 FILL IN THIS FORM COMPLETE	
DATE WELL COMPLETED May 26, 1969		DEPTH OF WELL 102 (TO NEAREST FOOT)		VERIFIED FROM POINT SURVEY WITH NO-20-100-1 (SEE INSTRUCTIONS)	
OWNER Frank Walter LAST NAME		FIRST NAME Alcott City Md.			
STREET OR RD. WELL LOG		POST OFFICE Alcott City Md.			
STATE THE KIND OF FORMATIONS PENETRATED, THEIR COLOR, DEPTH, THICKNESS AND IF WATER BEARING (USE OF PENCILS)		WELL DESCRIPTION GROUTING RECORD (FILL IN APPROPRIATE BOXES) YES ☒ NO ☐ ALL HAS BEEN SHROUTED (CIRCLE APPROPRIATE BOX) YES ☒ NO ☐ DEPTH OF GROUT SEAL (IN NEAREST FOOT) FROM 0 TO 22 (ENTER 0 IF FROM SURFACE)			
50 ft of dirt and 52 ft of gray rock		PUMPING TEST HOURS PUMPED (TO NEAREST HOUR) PUMPING RATE GALLONS PER MINUTE TO NEAREST GALLON 3 METHOD USED TO MEASURE PUMPING RATE WATER LEVEL (DISTANCE FROM LAST SURFACE) SETBACK PUMPING 13 WHEN PUMPING 95 TYPE OF PUMP USED (CIRCLE APPROPRIATE) A AIR ☐ B PISTON ☐ C CENTRIFUGAL ☐ D OTHER ☐ E JET ☐ F SUBMERSIBLE ☐			
11-25-69 1751 RH		CASING RECORD Casing Type (CIRCLE APPROPRIATE) STEEL ☒ CONCRETE ☐ PLASTIC ☐ OTHER ☐ MAIN CASING TYPE NOMINAL DIAMETER TOP (INCH) 6 TOTAL DEPTH OF MAIN CASING (NEAREST FOOT) 52 OTHER CASING (IF USED) DIAMETER (INCH) 4 DEPTH (FEET) 10			
3000 515		SCREEN RECORD SCREEN TYPE (CIRCLE APPROPRIATE) STEEL ☒ WIRE ☐ OPEN HOLE ☐ PLASTIC ☐ OTHER ☐ DEPTH (NEAREST WHOLE FOOT) FROM 0 TO 52			
CIRCLE APPROPRIATE BOXES ☒ A WELL WAS ABANDONED AND SEALED WHEN THIS WELL WAS COMPLETED ☐ B ELECTRIC LOG OBTAINED ☐ C COPY OF ELECTRIC LOG ATTACHED I HEREBY CERTIFY THAT I HAVE COMPLIED WITH P.L. 86-363, AS AMENDED, AND THAT THE INFORMATION CONTAINED IN THIS REPORT IS TRUE, ACCURATE, AND COMPLETE TO THE BEST OF MY KNOWLEDGE, INFORMATION AND BELIEF. DRILLER'S NAME Arthur P. Stinson SIGNATURE		IF WELL DRILLED WAS A FLOODING WELL CIRCLE BOX ☐ FOR USE ONLY (DO NOT FILL IN IF DRILLED IN A FLOODING WELL) TELESCOPE CASING ☐ INDICATOR ☐ OTHER DATA AVAILABLE ☐ FRONT DEPTH WELL ANNAPOLIS			

HEALTH

[illegible]

av. P...
Time 5.757

SOIL AUGER FINDING

TESTED BY.

REMARKS:

ALSO PRESENT

LET MO