

# APPLICATION

PERCOLATION TESTING

A 49861A

P \_\_\_\_\_

HOWARD COUNTY HEALTH DEPARTMENT  
BUREAU OF ENVIRONMENTAL HEALTH  
P.O. BOX 476 ELLICOTT CITY, MARYLAND 21043  
TELEPHONE: 461-9933

DISTRICT \_\_\_\_\_

DATE \_\_\_\_\_

TO: THE COUNTY HEALTH OFFICER  
ELLICOTT CITY, MARYLAND

I, HEREBY, APPLY FOR THE NECESSARY TEST IN ORDER TO CONSTRUCT (OR RECONSTRUCT) A SEWAGE DISPOSAL SYSTEM.

PROPERTY OWNER Dale Thompson Builders

ADDRESS \_\_\_\_\_ PHONE \_\_\_\_\_

PROSPECTIVE BUYER \_\_\_\_\_

ADDRESS \_\_\_\_\_ PHONE \_\_\_\_\_

PROPERTY LOCATION:

SUBDIVISION Springdale LOT NO X 10 on perc. cert

ROAD AND DESCRIPTION (13721 Springdale Drive)

TAX MAP \_\_\_\_\_ PARCEL # \_\_\_\_\_

SIZE OF LOT \_\_\_\_\_ TYPE BLDG SFD - 4Brm

(SINGLE FAMILY DWELLING OR COMMERCIAL)

THE SYSTEM INSTALLED UNDER THIS APPLICATION IS ACCEPTABLE ONLY UNTIL PUBLIC FACILITIES BECOME AVAILABLE. I FULLY UNDERSTAND THE FEE CONNECTED WITH THE FILING OF THIS PERC TEST APPLICATION IS NON-REFUNDABLE UNDER ANY CIRCUMSTANCES. I ALSO AGREE TO COMPLY WITH ALL M.O.S.H.A. REQUIREMENTS IN TESTING THIS LOT.

(SIGNATURE OF APPLICANT)

APPROVED BY \_\_\_\_\_ FOR \_\_\_\_\_ DATE \_\_\_\_\_

REJECTED BY \_\_\_\_\_ FOR \_\_\_\_\_ DATE \_\_\_\_\_

HOLD PENDING FURTHER TESTS \_\_\_\_\_ DATE \_\_\_\_\_

REASONS FOR REJECTION OR HOLDING \_\_\_\_\_

## THIS IS NOT A PERMIT

COUNTY #

SOIL PROFILE

0'

FILL

1 1/2'

br sa  
cl lo


3 1/2'

tan  
sa  
loam

12'

SOIL PROFILE

0'

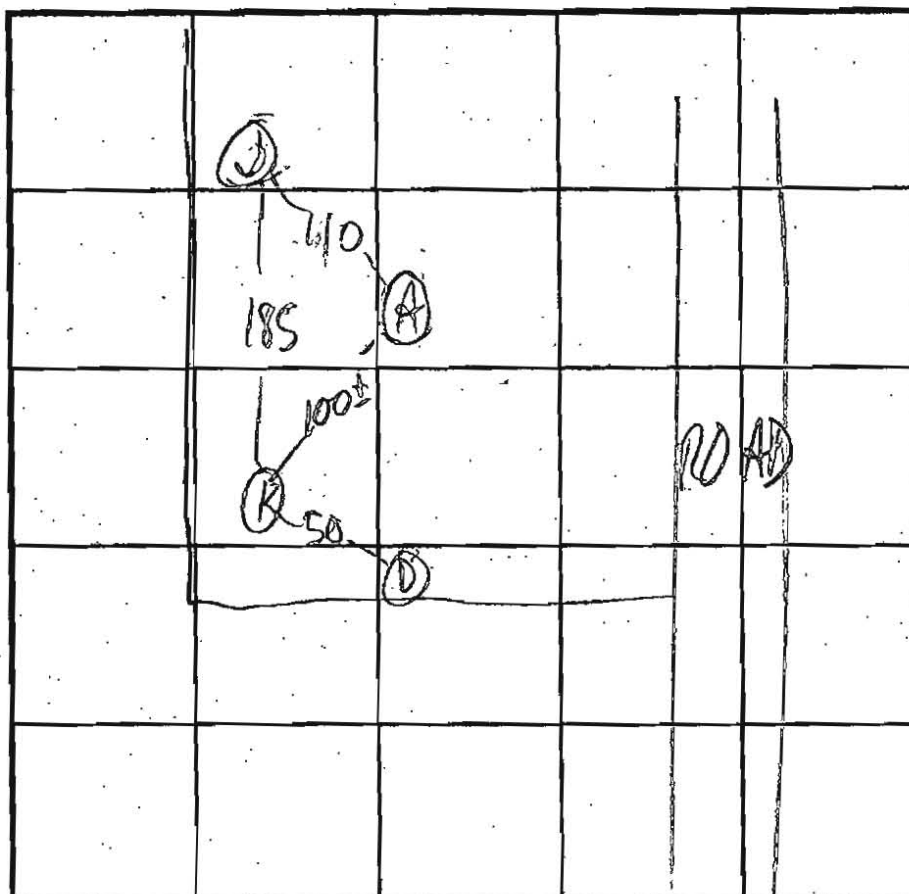

INDICATE NORTH - NAME ADJOINING ROADWAY AS BASE LINE

| DATE    | TEST NO. | DEPTH  | PRE-WET |       | TEST - 1" DROP |       | TIME |
|---------|----------|--------|---------|-------|----------------|-------|------|
|         |          |        | START   | STOP  | START          | STOP  |      |
| 11/2/94 | 10K S    | 3'6"   | 10:54   | 11:01 | 11:01          | 11:15 | 14   |
|         | 10K V    | 12     |         |       |                |       |      |
|         | 10J S    | 4      | 11:06   | 11:11 | 11:11          | 11:18 | 7    |
|         | 10J V    | 11 1/2 |         |       |                |       |      |
|         |          |        |         |       |                |       |      |
|         |          |        |         |       |                |       |      |
REMARKS

TYPE OF SOIL

TESTED BY M. Rifkin

ALSO PRESENT R.D., J. Allen

TRENCH DESIGN DATA: AVERAGE PERCOLATION TIME

TRENCH WIDTH 3

INLET DEPTH 3 1/2

MAXIMUM BOTTOM DEPTH 5 1/2

SQ. FT/BEDROOM 180

# APPLICATION

PERCOLATION TESTING

A \_\_\_\_\_

P \_\_\_\_\_

HOWARD COUNTY HEALTH DEPARTMENT  
BUREAU OF ENVIRONMENTAL HEALTH  
3525 W ELLICOTT MILLS DRIVE/ELLICOTT CITY, MARYLAND 21043  
TELEPHONE: 313-2840

DISTRICT \_\_\_\_\_

DATE \_\_\_\_\_

TO: THE COUNTY HEALTH OFFICER  
ELLICOTT CITY, MARYLAND

I HEREBY APPLY FOR THE NECESSARY TEST PRIOR TO APPLICATION FOR PERMIT TO CONSTRUCT (OR RECONSTRUCT) A SEWAGE DISPOSAL SYSTEM.

PROPERTY OWNER \_\_\_\_\_

ADDRESS \_\_\_\_\_ PHONE \_\_\_\_\_

AGENT OR PROSPECTIVE BUYER \_\_\_\_\_

ADDRESS \_\_\_\_\_ PHONE \_\_\_\_\_

PROPERTY LOCATION:

SUBDIVISION \_\_\_\_\_ LOT NO. 10

ROAD AND DESCRIPTION \_\_\_\_\_

TAX MAP \_\_\_\_\_ PARCEL # \_\_\_\_\_

SIZE OF LOT \_\_\_\_\_ TYPE BLDG. \_\_\_\_\_  
(SINGLE FAMILY DWELLING OR COMMERCIAL)

THE SYSTEM INSTALLED UNDER THIS APPLICATION IS ACCEPTABLE ONLY UNTIL PUBLIC FACILITIES BECOME AVAILABLE. I FULLY UNDERSTAND THE  
FEE CONNECTED WITH THE FILING OF THIS PERC TEST APPLICATION IS NON-REFUNDABLE UNDER ANY CIRCUMSTANCES. I ALSO AGREE TO  
COMPLY WITH ALL M.O.S.H.A. REQUIREMENTS IN TESTING THIS LOT. \_\_\_\_\_

(SIGNATURE OF APPLICANT)

APPROVED BY \_\_\_\_\_ FOR \_\_\_\_\_ DATE \_\_\_\_\_

DISAPPROVED BY \_\_\_\_\_ FOR \_\_\_\_\_ DATE \_\_\_\_\_

HOLD PENDING FURTHER TESTS \_\_\_\_\_

REASONS FOR REJECTION OR HOLDING \_\_\_\_\_

PERCOLATION TEST PLAT/PRELIMINARY PLAT - TITLE OR I.D. # \_\_\_\_\_ DATE \_\_\_\_\_

SITE DEVELOPMENT PLAN/FINAL PLAT - TITLE OR I.D. # \_\_\_\_\_ DATE \_\_\_\_\_

## THIS IS NOT A PERMIT

A49861A

Lot 11

ALL HOLES

SOIL PROFILE

red  
brn  
saclm  
pink  
tan  
saclm  
5-15%  
Frag

2-3


12-14

F=3

180 BR

Inlet 3

Box 5

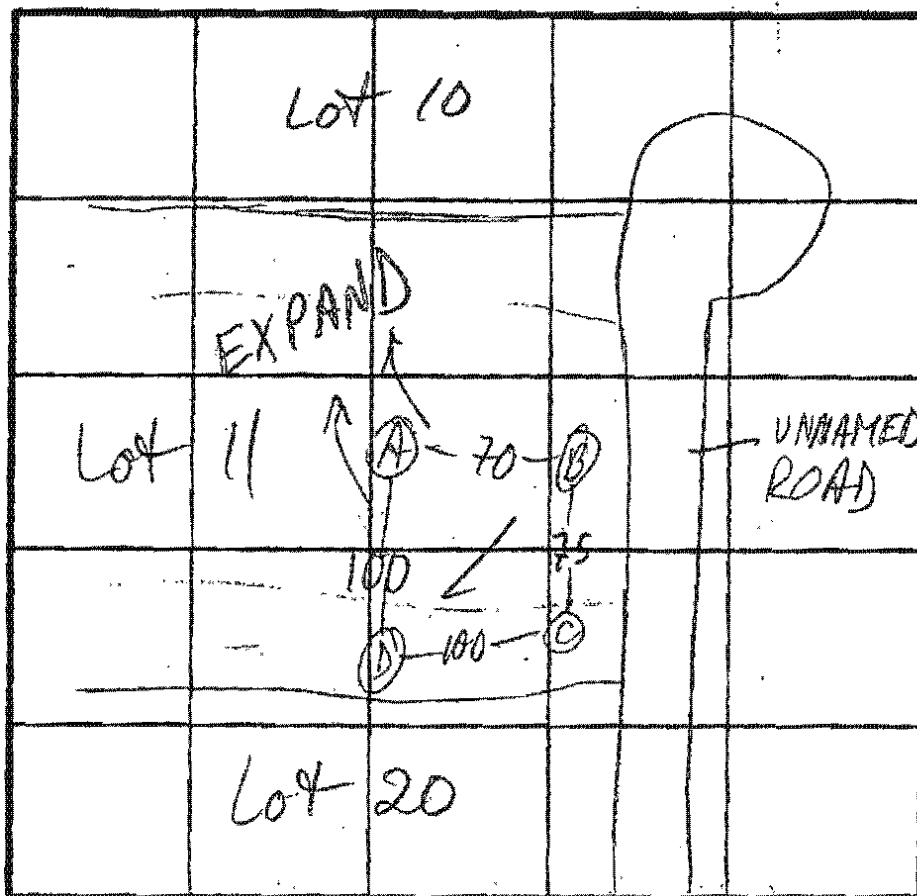

INDICATE NORTH - NAME ADJOINING ROADWAY AS BASE LINE.

BRIGHTON DAM RD

| DATE   | TEST NO. | DEPTH | PRE-WET |       | TEST - 1" DROP |       | TIME |
|--------|----------|-------|---------|-------|----------------|-------|------|
|        |          |       | START   | STOP  | START          | STOP  |      |
| 3/4/94 | B H      | 4     | 12:13   | 12:16 | 12:16          | 12:18 | 2    |
|        | B V      | 12    | 12:13   | 12:14 | 12:14          | 12:16 | 2    |
|        | A S      | 3 1/2 | 12:17   | 12:20 | 12:20          | 12:25 | 5    |
|        | A V      | 12    |         |       |                |       |      |
|        | D H      | 4 1/2 | 12:31   | 12:32 | 12:32          | 12:33 | 1    |
|        | D V      | 14    | 12:28   | 12:30 | 12:30          | 12:35 | 5    |
|        | C S      | 4 1/2 | 12:46   | 12:47 | 12:47          | 12:49 | 2    |
|        | C V      | 12    |         |       |                |       |      |
|        |          |       |         |       |                |       |      |
|        |          |       |         |       |                |       |      |

may have been in  
fluenced by  
storm flow near hole

REMARKS HOLES PER PLAN ±  
AREA MAY BE < 10 K, ADJUST AS NEEDED

TYPE OF SOIL

TESTED BY

M. Rifkin

ALSO PRESENT

L. Allen, R. Demmitt