

APPLICATION

A 22775

SEWAGE DISPOSAL TESTING

P _____

STATE OF MARYLAND - DEPARTMENT OF HEALTH AND MENTAL HYGIENE

HOWARD COUNTY HEALTH DEPARTMENT
ENVIRONMENTAL HEALTH SERVICES
P. O. BOX 476, ELLICOTT CITY, MARYLAND 21043
TELEPHONE: 465-5000, EXT. 356

DISTRICT 5

DATE 1/27/76

TO: THE COUNTY HEALTH OFFICER
ELLICOTT CITY, MARYLAND

I, HEREBY, APPLY FOR THE NECESSARY TEST IN ORDER TO CONSTRUCT (OR RECONSTRUCT) A SEWAGE DISPOSAL SYSTEM.

PROPERTY OWNER Frank F. Willson & Wf., et al

ADDRESS 3 Ashton Realty Co., Route 108, Ashton, Md. PHONE (8) 924-4811

PROPERTY LOCATION:

SUBDIVISION Linden Chapel Hills LOT NO. 15, Blk. A, Sec. 5

ROAD AND DESCRIPTION R/W off Orion Drive

SIZE OF LOT 119,300 sq. ft. TYPE BLDG. 3 or 4

NUMBER OF BEDROOMS

IF NOT SINGLE RESIDENCE DESCRIBE (Single Fmly. Dwlg.)

THE SYSTEM INSTALLED UNDER THIS APPLICATION IS ACCEPTABLE ONLY UNTIL PUBLIC FACILITIES BECOME AVAILABLE.

SIGNATURE OF APPLICANT /s/ Robert Johnson


APPROVED BY _____ FOR _____ DATE _____
(KIND OF SYSTEM)

REJECTED BY _____ FOR _____ DATE _____
(KIND OF SYSTEM)

HOLD PENDING FURTHER TESTS _____ DATE _____

REASONS FOR REJECTION OR HOLDING _____

THIS IS NOT A PERMIT

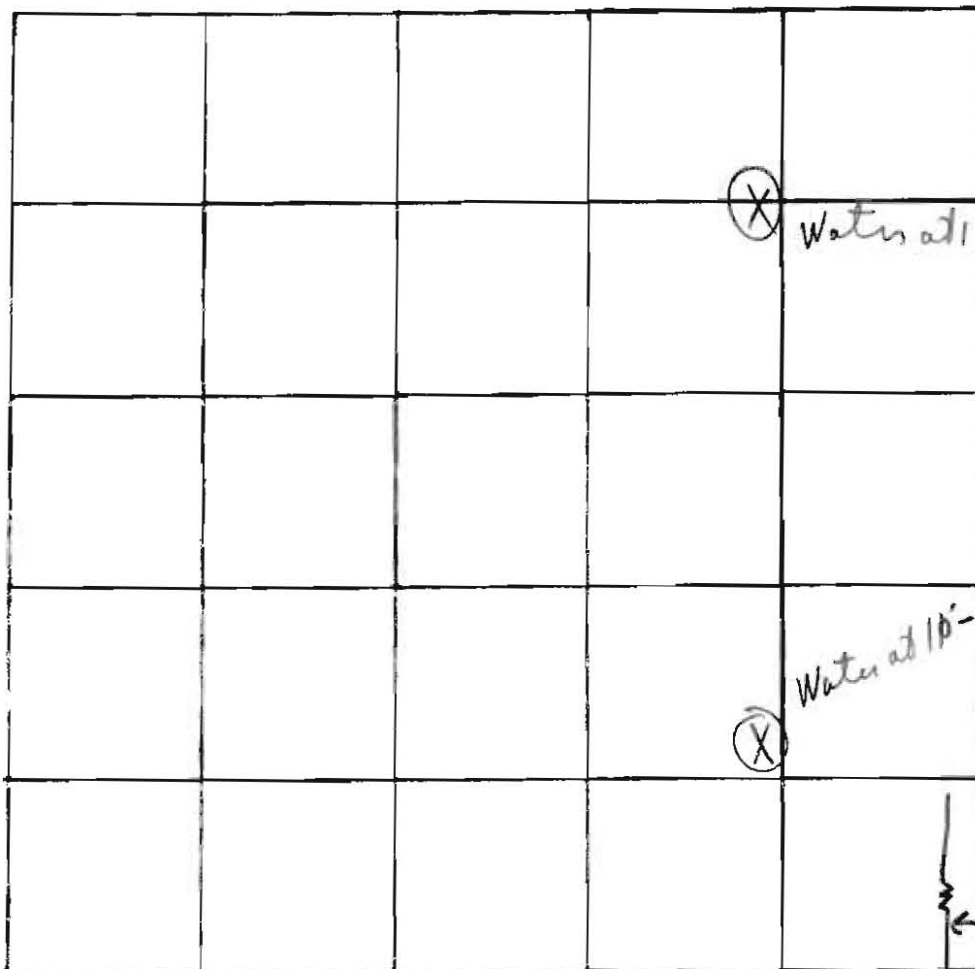


INDICATE NORTH. - NAME ADJOINING ROADWAY AS BASE LINE.

DATE	TEST NO.	DEPTH	PRE-WET		TEST - 1" DROP		TIME
			START	STOP	START	STOP	
4/15/66	1	s	/	/	/	/	
	2	s	/	/	/	/	
	3	s	/	/	/	/	
	4	s	/	/	/	/	
	5	s	/	/	/	/	
	6	s	/	/	/	/	
	7	Visual similar to					

Rejected
still shown
on plot
Take off
or put
nonbuildable

REMARKS Wooded lot - Water hold for further
 TYPE OF SOIL test if wanted
 TESTED BY C. D. S. ALSO PRESENT: F. G. G. men

COORDINATE	SCHEDULE
Mo.	North East
1	530 517.19 504 484.25
2	530 517.19 504 479.31
3	541 668.35 504 510.27
4	501 622.61 504 531.21
5	501 517.19 504 481.91
6	531 517.19 504 481.91
7	551 135.15 504 485.92
8	531 517.19 504 481.91
9	508 008.61 504 515.00
10	508 238.78 504 484.53
11	508 238.78 504 484.53
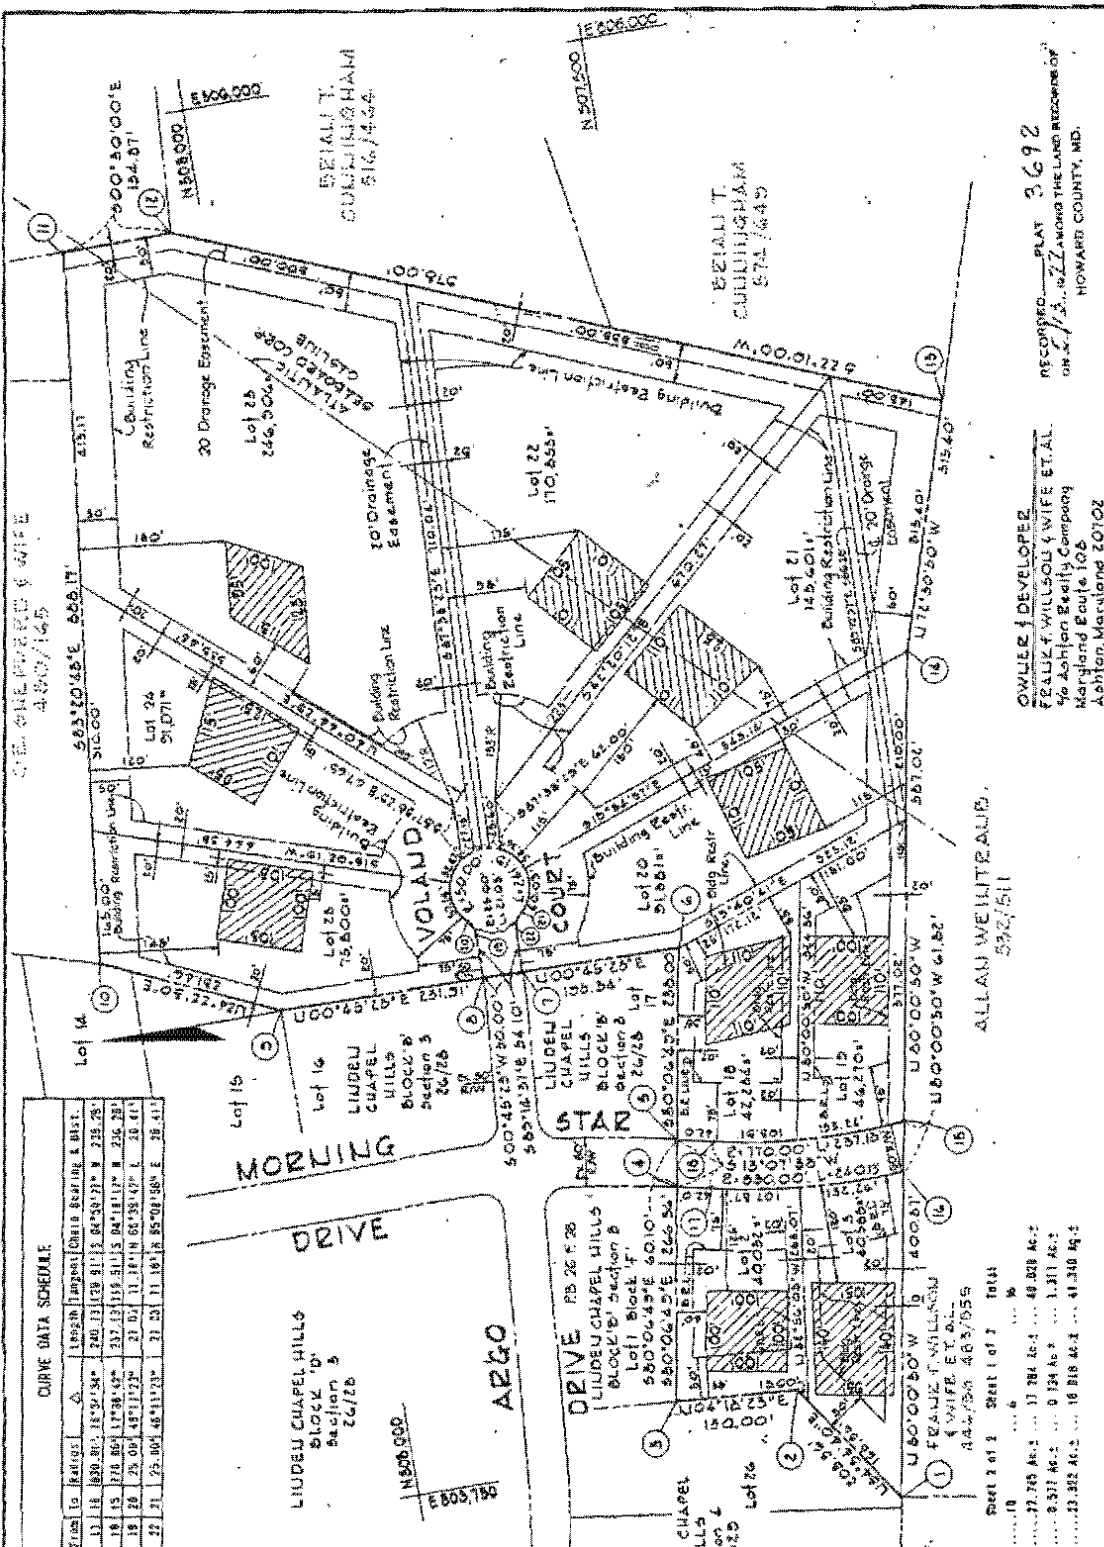[illegible][illegible]

OWNER & DEVELOPER
FRANK WILSON & WIFE ET AL.
46 Ashton Realty Company
106 Howard County, MD.

OWLER & DEVELOPER
FRANK F. WILSON & WIFE ET AL.
c/o John Beatty Company
Maryland Route 106

LINDEN
CHAPEL HILLS

SECTION FIVE
Lots 213 Block "F" Lots 18-25 Block "B"

FIFTH ELECTION DISTRICT HOWARD COUNTY, MD.
AUGUST 20, 1276 Sheet 2 of 2 SCALE: 1"=100'

[illegible][illegible][illegible]

1. The first of these is the fact that the
 2. second of these is the fact that the
 3. third of these is the fact that the
 4. fourth of these is the fact that the
 5. fifth of these is the fact that the
 6. sixth of these is the fact that the
 7. seventh of these is the fact that the
 8. eighth of these is the fact that the
 9. ninth of these is the fact that the
 10. tenth of these is the fact that the

44-38861-107
 Received County Office of Planning and
 Community Health Officer, Date 5/3/77
 Dr. W. S. H. O'Brien
 County Health Officer, Date 5/3/77
 Received County Office of Planning and
 Community Health Officer, Date 5/3/77

[illegible]

CURVE DATA SCHEDULE

From	To	Radius	Δ	Length	Tangent	Chord	Bearing & Dist.
11	12	505.00'	4°15'53"	37.59'	18.80'	S 76°56'57" W	37.58'

COORDINATE SCHEDULE

No.	North	East
1	509,567.67	803,764.32
2	509,856.04	803,793.72
3	509,858.25	803,788.04
4	509,888.81	803,709.74
5	509,897.06	803,688.61
6	510,829.05	803,762.38
7	510,788.83	804,304.50
8	510,445.52	804,819.43
9	510,422.54	804,594.38
10	510,358.32	804,340.91
11	510,073.57	804,395.85
12	510,065.09	804,359.23
13	510,016.83	804,372.33
14	509,767.75	804,409.48
15	509,698.97	804,280.71
16	509,623.44	803,930.18

NOTE: The coordinates shown hereon are based on the Maryland State Grid System.

20' Drainage Easement

E.T. Ryan
620/112


E 803,500

N 509,750

Paul G. Hobbs
753/476

NG8°40'46"W-22.68'
NG8°40'46"W-34.04'
NG8°40'46"W-6.11'

ORION

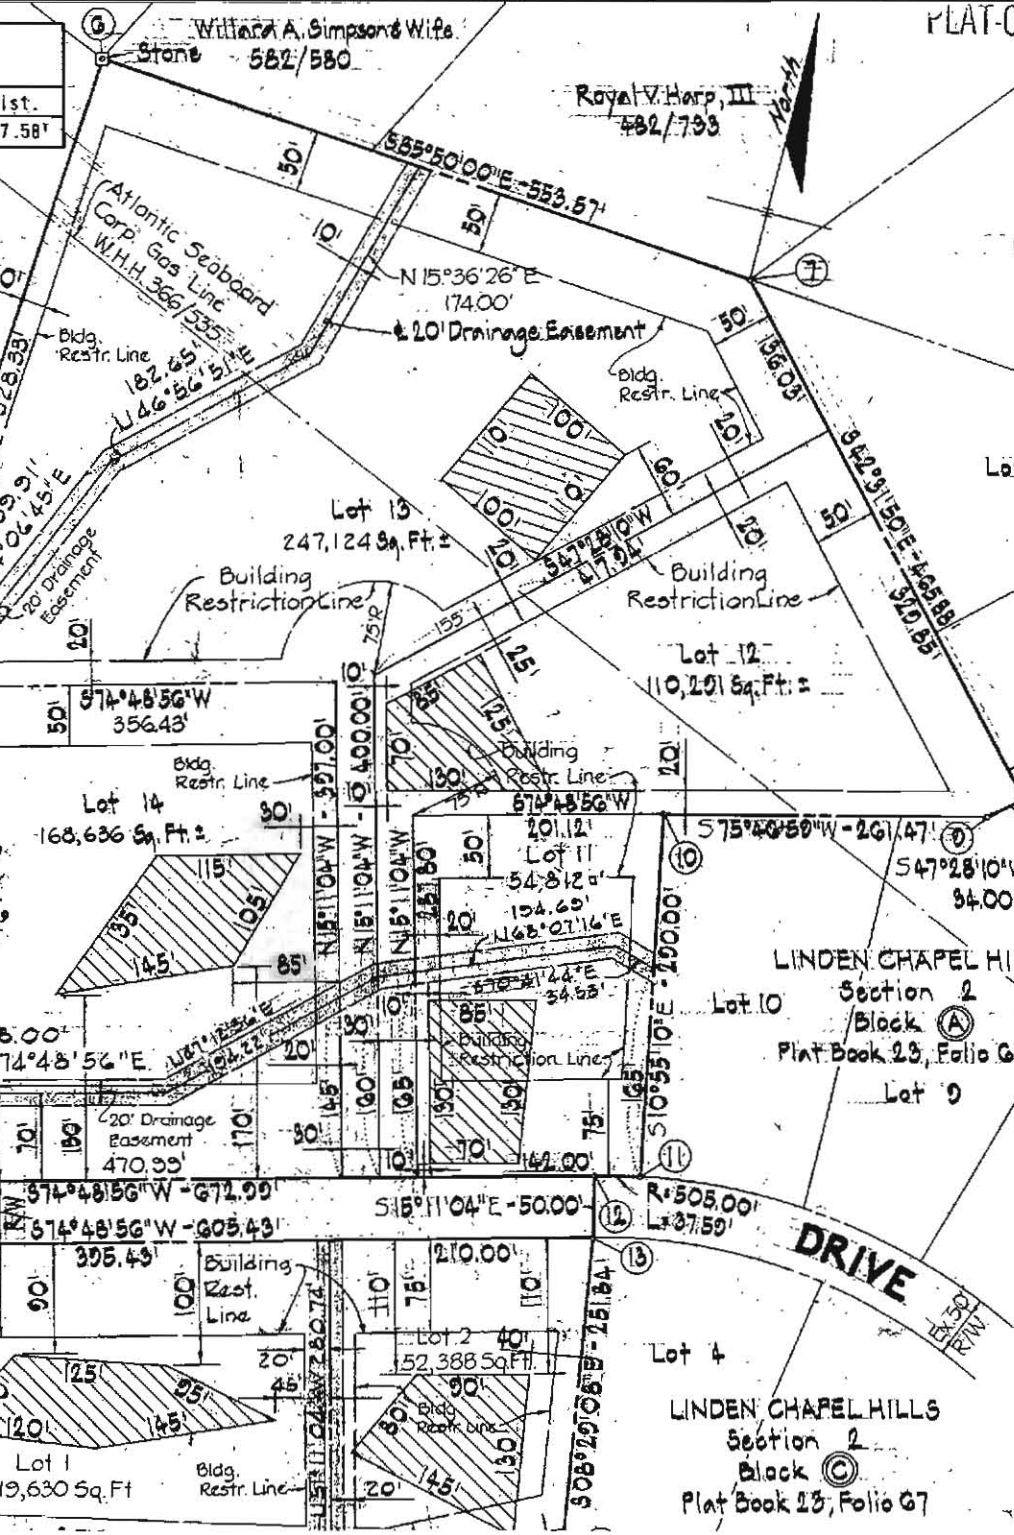

William A. Simpson & Wife
Stone 582/580


Royal V. Harp, III
482/793

LINDEN CHAPEL HILL
Section 2
Block A
Plat Book 23, Folio 67

LINDEN CHAPEL HILLS
Section 2
Block C
Plat Book 23, Folio 67

DRIVE

DETAIL
SCALE: 1" = 29'
5TH ELECTION DISTRICT
HOWARD COUNTY, MD.

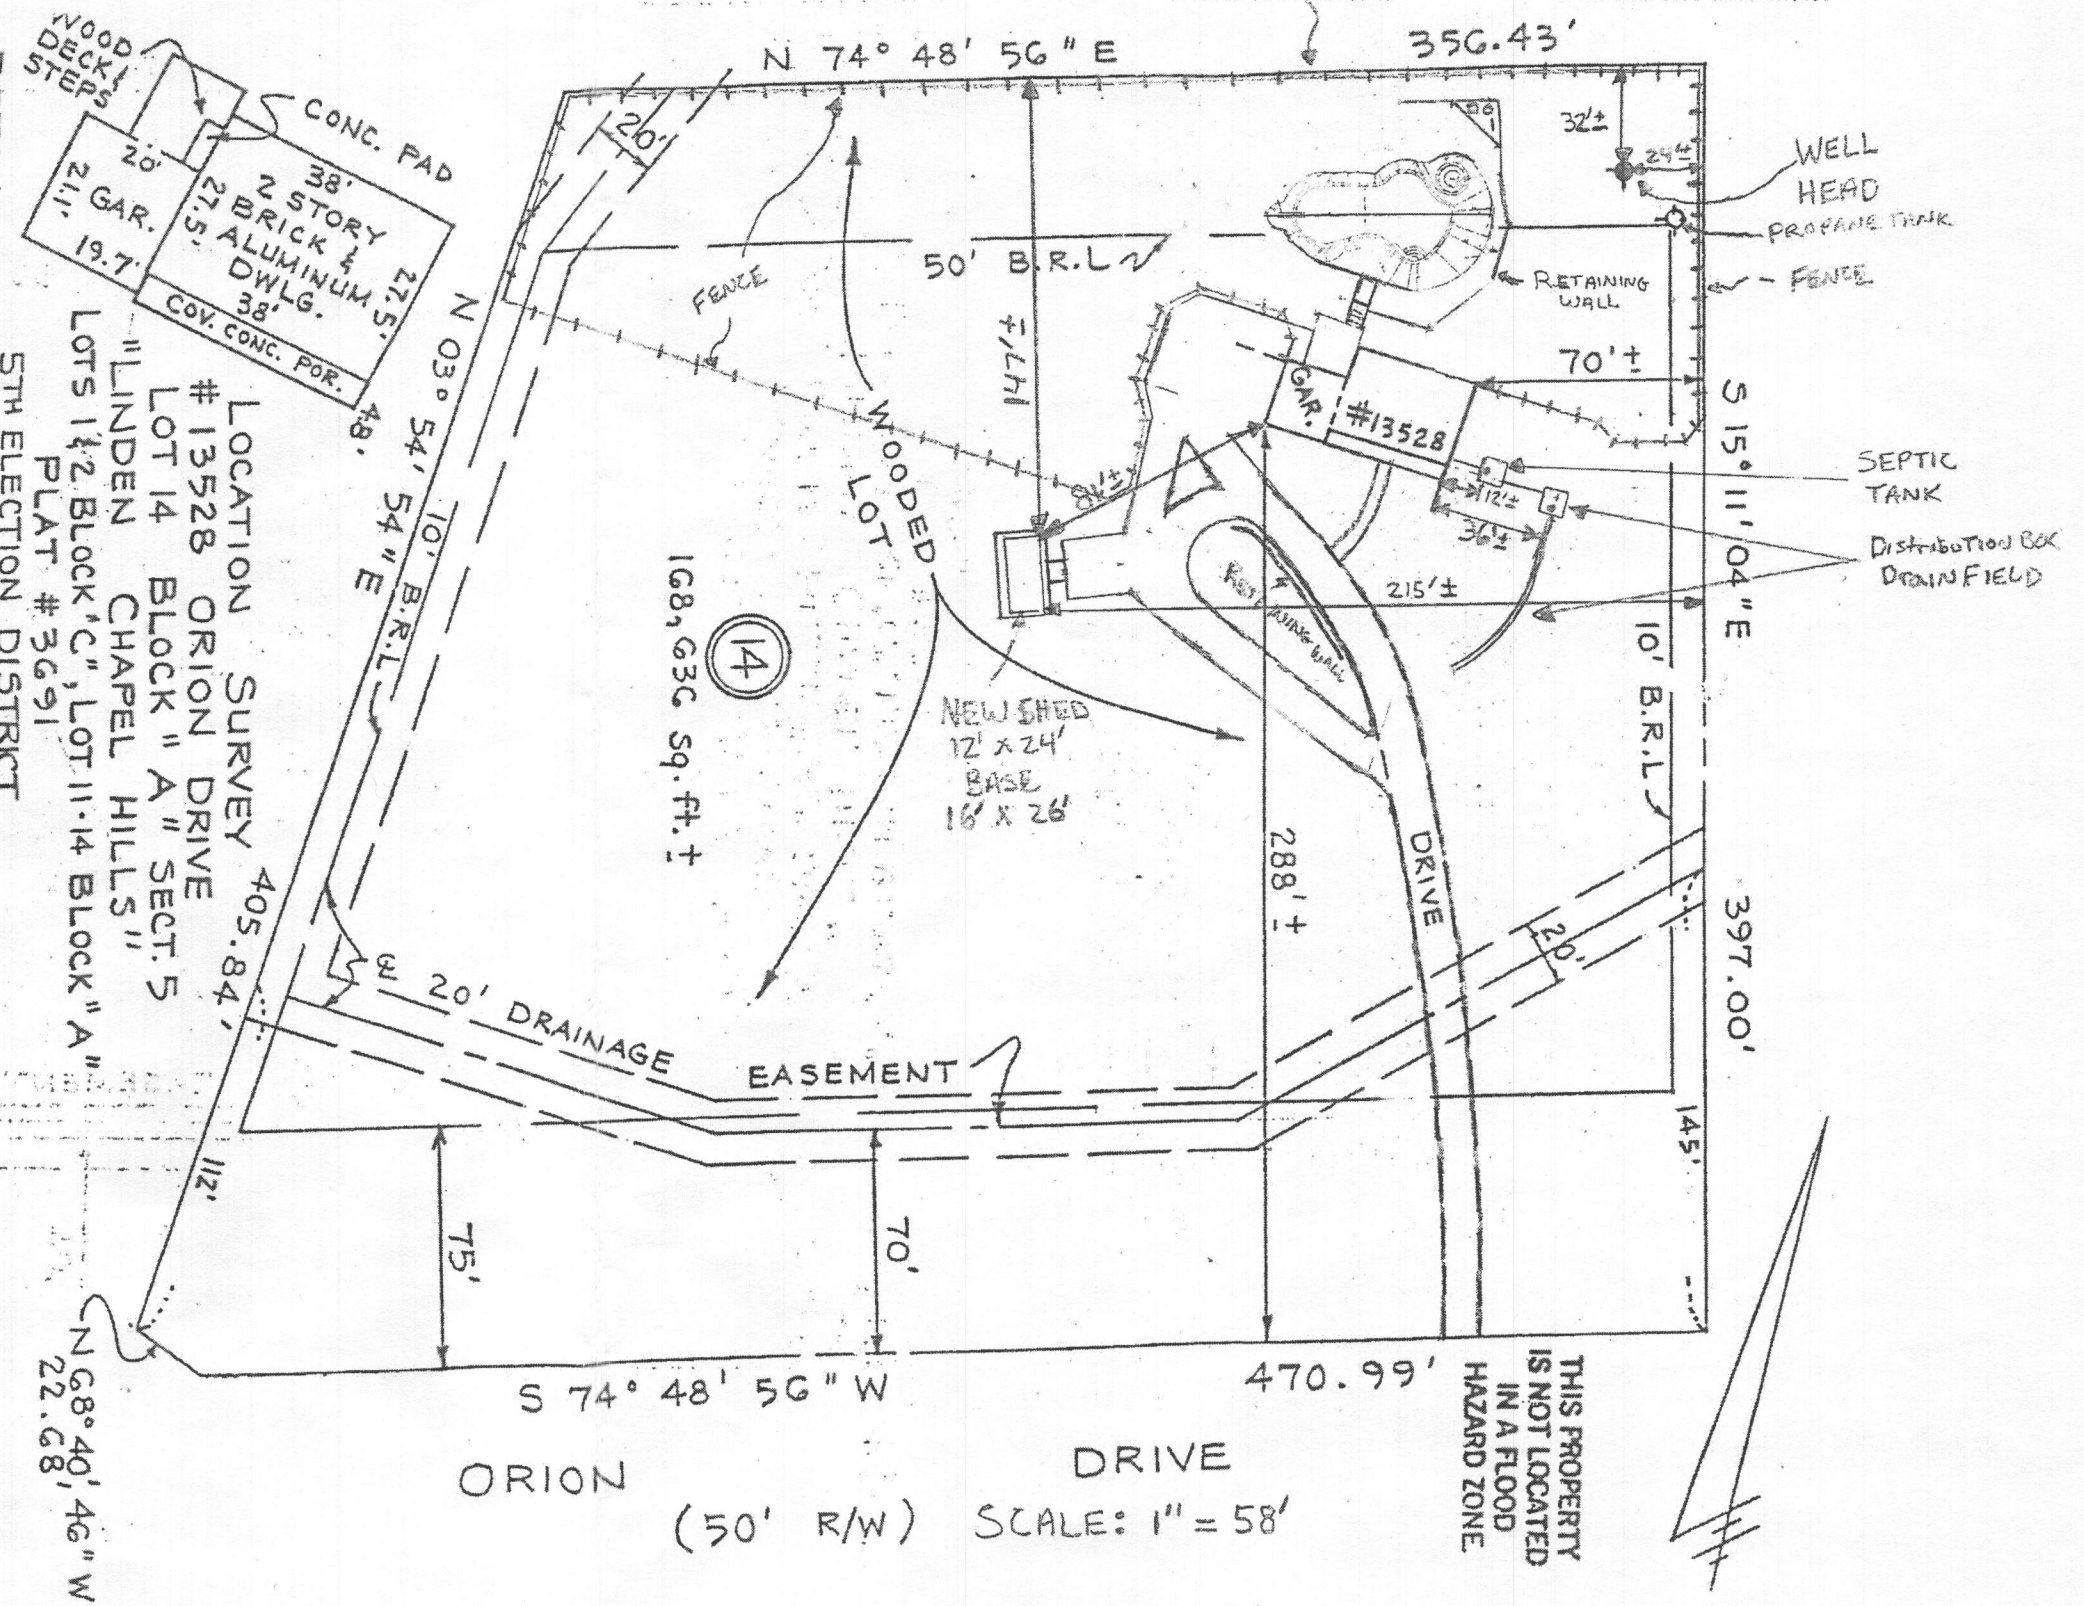

APPLICATION

A 22775

P _____

SEWAGE DISPOSAL TESTING

STATE OF MARYLAND - DEPARTMENT OF HEALTH AND MENTAL HYGIENE

HOWARD COUNTY HEALTH DEPARTMENT
ENVIRONMENTAL HEALTH SERVICESP O BOX 476, ELLICOTT CITY, MARYLAND 21043
TELEPHONE: 465-5000, EXT. 356DISTRICT 5DATE 1/27/76TO: THE COUNTY HEALTH OFFICER
ELLICOTT CITY, MARYLAND

I, HEREBY, APPLY FOR THE NECESSARY TEST IN ORDER TO CONSTRUCT (OR RECONSTRUCT) A SEWAGE DISPOSAL SYSTEM.

PROPERTY OWNER Frank E. Willson & Wf., et alADDRESS % Ashton Realty Co., Route 108, Ashton, Md. PHONE (8) 924-4811

PROPERTY LOCATION:

SUBDIVISION Linden Chapel Hills LOT NO. 15, Blk. A, Sec. 5ROAD AND DESCRIPTION R/W off Orion DriveSIZE OF LOT 119,300 sq. ft. TYPE BLDG. 3 or 4IF NOT SINGLE RESIDENCE DESCRIBE _____
(Single Fmly. Dwllg.)

THE SYSTEM INSTALLED UNDER THIS APPLICATION IS ACCEPTABLE ONLY UNTIL PUBLIC FACILITIES BECOME AVAILABLE.

SIGNATURE OR APPLICANT /s/ Robert JohnsenAPPROVED BY _____ FOR _____ DATE _____
(KIND OF SYSTEM)REJECTED BY C. B. Theaker FOR Aug system DATE 4/15/76
(KIND OF SYSTEM)

HOLD PENDING FURTHER TESTS _____ DATE _____

REASONS FOR REJECTION OR HOLDING 4/15/76 Hold for further testing
C.B.A.

THIS IS NOT A PERMIT

