

5/13/80
5/14/80

5/14/80 Filed
C.62

PERMIT

SEWAGE DISPOSAL SYSTEM

MARYLAND STATE DEPARTMENT OF HEALTH

HOWARD COUNTY

INDEXED

ELLICOTT CITY

DISTRICT 5th

DATE 5/9/80

Jack Pyock

IS PERMITTED TO INSTALL ☒ ALTER

ADDRESS 13775 Triadelphia Road, Glenelg, Md. 21737

PHONE 988-9270

SUBDIVISION Linden Chapel Hills

ROAD 13528 Orion Drive

LOT 14, Blk. A, Sec. 5

PROPERTY OWNER 641 Nillion

John Kaeffer Michael Butler

ADDRESS

SPECIFICATIONS 4 bedrooms

SEPTIC TANK CAPACITY 1250 GALLONS

DRAIN FIELD DEPTH FEET, BOTTOM AREA SQ. FT.

DEEP TRENCH DEPTH FEET, BOTTOM AREA SQ. FT.

BEEPADE PTS. ☒ ABSORBENT SIDE-WALL AREA 125 SQ. FT. per bedroom.

INLET PIPE 6 FT. BELOW ORIGINAL GRADE, MAXIMUM DEPTH 12 FT. BELOW ORIGINAL GRADE

EFFECTIVE DEPTH AT 5 FT. BELOW ORIGINAL GRADE.

LOCATE DISPOSAL AREA 35 FT. FROM right LOT LINE AND 255 FT. FROM front LOT LINE AS SEEN WHEN

FACING LOT FROM Orion Drive. If dry well and trench needed: Leave 5 ft. earth buffer between dry well and trench. Trench to follow contour of the land.

PLANS APPROVED BY Charles B. Streskar

DATE 10/28/77

COVER NO WORK UNTIL INSPECTED AND APPROVED.

NEITHER THE HOWARD COUNTY COUNCIL NOR THE HEALTH DEPARTMENT IS RESPONSIBLE FOR THE SUCCESSFUL OPERATION OF ANY SYSTEM.

NOTE: IF TRENCH IS USED CALL FOR INSPECTION BEFORE PLACING GRAVEL IN TRENCH.

NOTE: NO DRY WELL SHALL EXCEED 18 FOOT IN DIAMETER.

NOTE: ALL PIPE FROM HOUSE TO DISPOSAL AREA MUST BE CAST IRON.

PERMIT VOID AFTER THREE YEARS.

NOTE: INSTALL STAND PIPE ON SEPTIC TANK AND DRY WELL. STAND PIPES MUST BE 6 INCHES IN DIAMETER. CAST IRON, CONCRETE OR TERRA COTTA ACCEPTED.

*INSTALLER IS RESPONSIBLE FOR OBTAINING FINAL APPROVAL ON THIS PERMIT.

HD - 23

BLDG. PERMIT SIGNED

AND RETURNED 9/24/80

Seal # 53618


Remodeling

BLDG. PERMIT SIGNED

AND RETURNED 4/21/84

Seal # 53618

PH

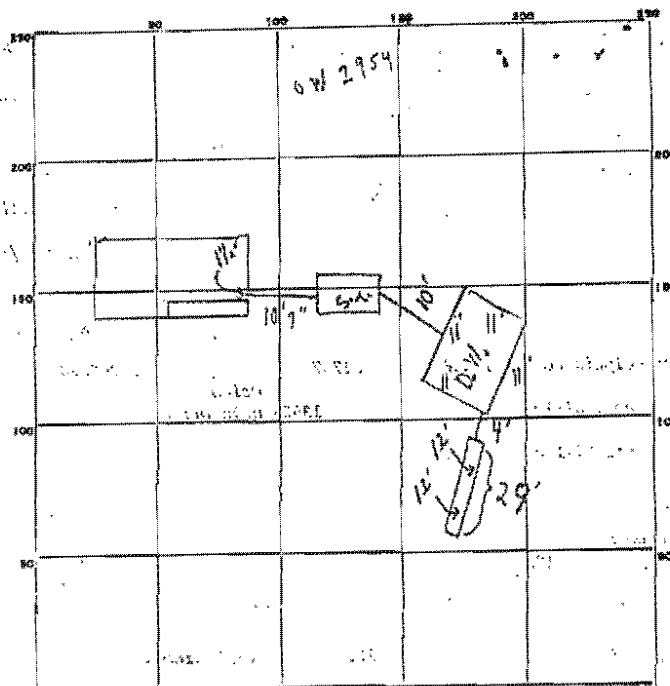

INDICATE NORTH - NAME ADJOINING ROADWAY AS BASE LINE.

ORION DRIVE

PERMIT CARD

S.T. D.W.

SEPTIC TANK, LEVEL

CLEANOUTS

DISTRIBUTION BOX, LEVEL

TILE FIELD, DEPTH 12 FT. TRENCH WIDTH 2 FT.

GRAVEL DEPTH 7+ IN. TOTAL LENGTH 29 FT.

203

NUMBER OF TRENCHES 1

TOTAL BOTTOM AREA

SEEPAGE PITS, INSIDE DIAMETER 44 FT.

DEPTH BELOW INLET 7+ FT.

308

ABSORBENT AREA 511 SQ. FT.

REMARKS

5/13/80 CHECKED - TRENCH SHORT NEED 8' MORE IN LENGTH

(2) TRENCH NOW 29' LONG. HOLD FOR FINAL ON TRENCH - OK TO COVER

FROM HOUSE TO DRYWELL. C.B.J. 5/14/80 SYSTEM COMPLETE.

C.B.J. P.S.K.

DATE SYSTEM APPROVED

5/14/80 as per above

INSPECTOR

C.B.J. Stricker