

# APPLICATION

A 22778

## SEWAGE DISPOSAL TESTING

P. \_\_\_\_\_

STATE OF MARYLAND - DEPARTMENT OF HEALTH AND MENTAL HYGIENE

HOWARD COUNTY HEALTH DEPARTMENT  
ENVIRONMENTAL HEALTH SERVICES  
P. O. BOX 474, ELLICOTT CITY, MARYLAND 21043  
TELEPHONE: 485-5000, EXT. 356

DISTRICT 5

DATE 1/27/76

TO: THE COUNTY HEALTH OFFICER  
ELLICOTT CITY, MARYLAND

I, HEREBY, APPLY FOR THE NECESSARY TEST IN ORDER TO CONSTRUCT (OR RECONSTRUCT) A SEWAGE DISPOSAL SYSTEM.

PROPERTY OWNER Frank F. Willson & Ws., et al

ADDRESS 2 Ashton Realty Co., Route 108, Ashton, Md. PHONE (8) 924-4811

PROPERTY LOCATION:

SUBDIVISION Linden Chapel Hills LOT NO. 16, Blk. A, Sec. 5

ROAD AND DESCRIPTION Orion Drive

SIZE OF LOT 86,900 sq. ft. TYPE BLDG. 3 or 4

IF NOT SINGLE RESIDENCE DESCRIBE (Single Faly. Dwlg.)

THE SYSTEM INSTALLED UNDER THIS APPLICATION IS ACCEPTABLE ONLY UNTIL PUBLIC FACILITIES BECOME AVAILABLE.

SIGNATURE OF APPLICANT /s/ Robert Johnson

APPROVED BY \_\_\_\_\_ FOR \_\_\_\_\_ DATE \_\_\_\_\_  
(KIND OF SYSTEM)

REJECTED BY \_\_\_\_\_ FOR \_\_\_\_\_ DATE \_\_\_\_\_  
(KIND OF SYSTEM)


HOLD PENDING FURTHER TESTS \_\_\_\_\_ DATE \_\_\_\_\_

REASONS FOR REJECTION OR HOLDING \_\_\_\_\_

# THIS IS NOT A PERMIT

A 22776

150'

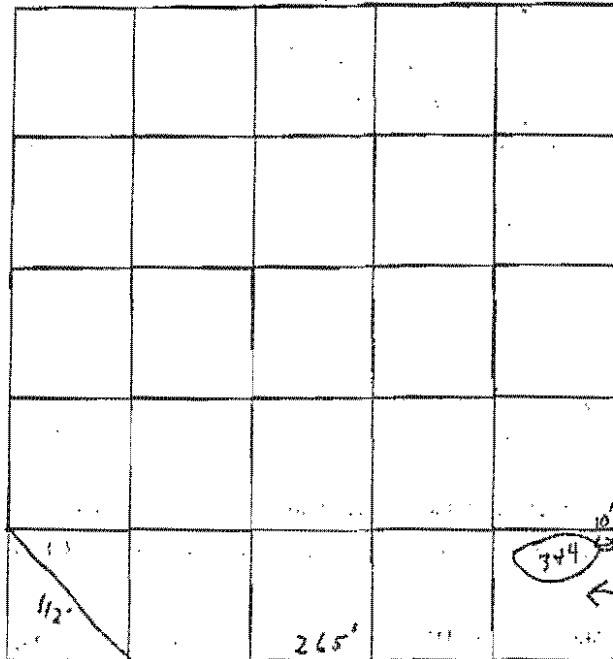

395

10' off highway

X 344 15

Not 16

14A

DATE	TEST NO.	DEPTH	PRE-WET		TEST - 1" DROP		TIME
			START	STOP	START	STOP	
4/15/78	1						
	2						
	3	6'	2:28	2:30	2:30	2:34	4m
	4	13'	2:20	2:22	2:22	2:27	5m
	5						
	6						
	7		Visual similar to				

REMARKS: Wooded lot Chance Right of Way  
 TYPE OF SOIL: Combine 15016  
 TESTED BY: C. B. M. ALSO PRESENT: Fyockmen