

Name: Harinder Saini
 Street Address: 1801 Quarter horse Dr
 City, State, Zip: Woodstock MD 21163
 Date: 09-28-2018

Amendment, Permit # B18002249

Ms. Debbie Whalen
 Division of Plan Review
 Department of Inspections, Licenses and Permits
 Howard County Government
 3430 Court House Dr
 Ellicott City, MD 21043

Dear Ms. Whalen:

I am requesting to amend Permit # B18002249 at
1801 Quarter horse Dr, Woodstock MD 21163 to

To amend the new addition to detached garage
from 16 feet to 22 feet 10 inches.

Enclosed:

✓ Fee: \$25.00
 2 Plot Plans
 2 Sets of Construction Drawings
 Other: _____

If there is anything we can do to assist you, please let me know.


Sincerely,

CC: PTZ
 Health

Name: Harinder Saini
 Title: _____
 Phone: 410-227-3362
 Email: HARRYXS@LIVE.COM

pd.
 X Cash X

QUARTER HORSE DRIVE

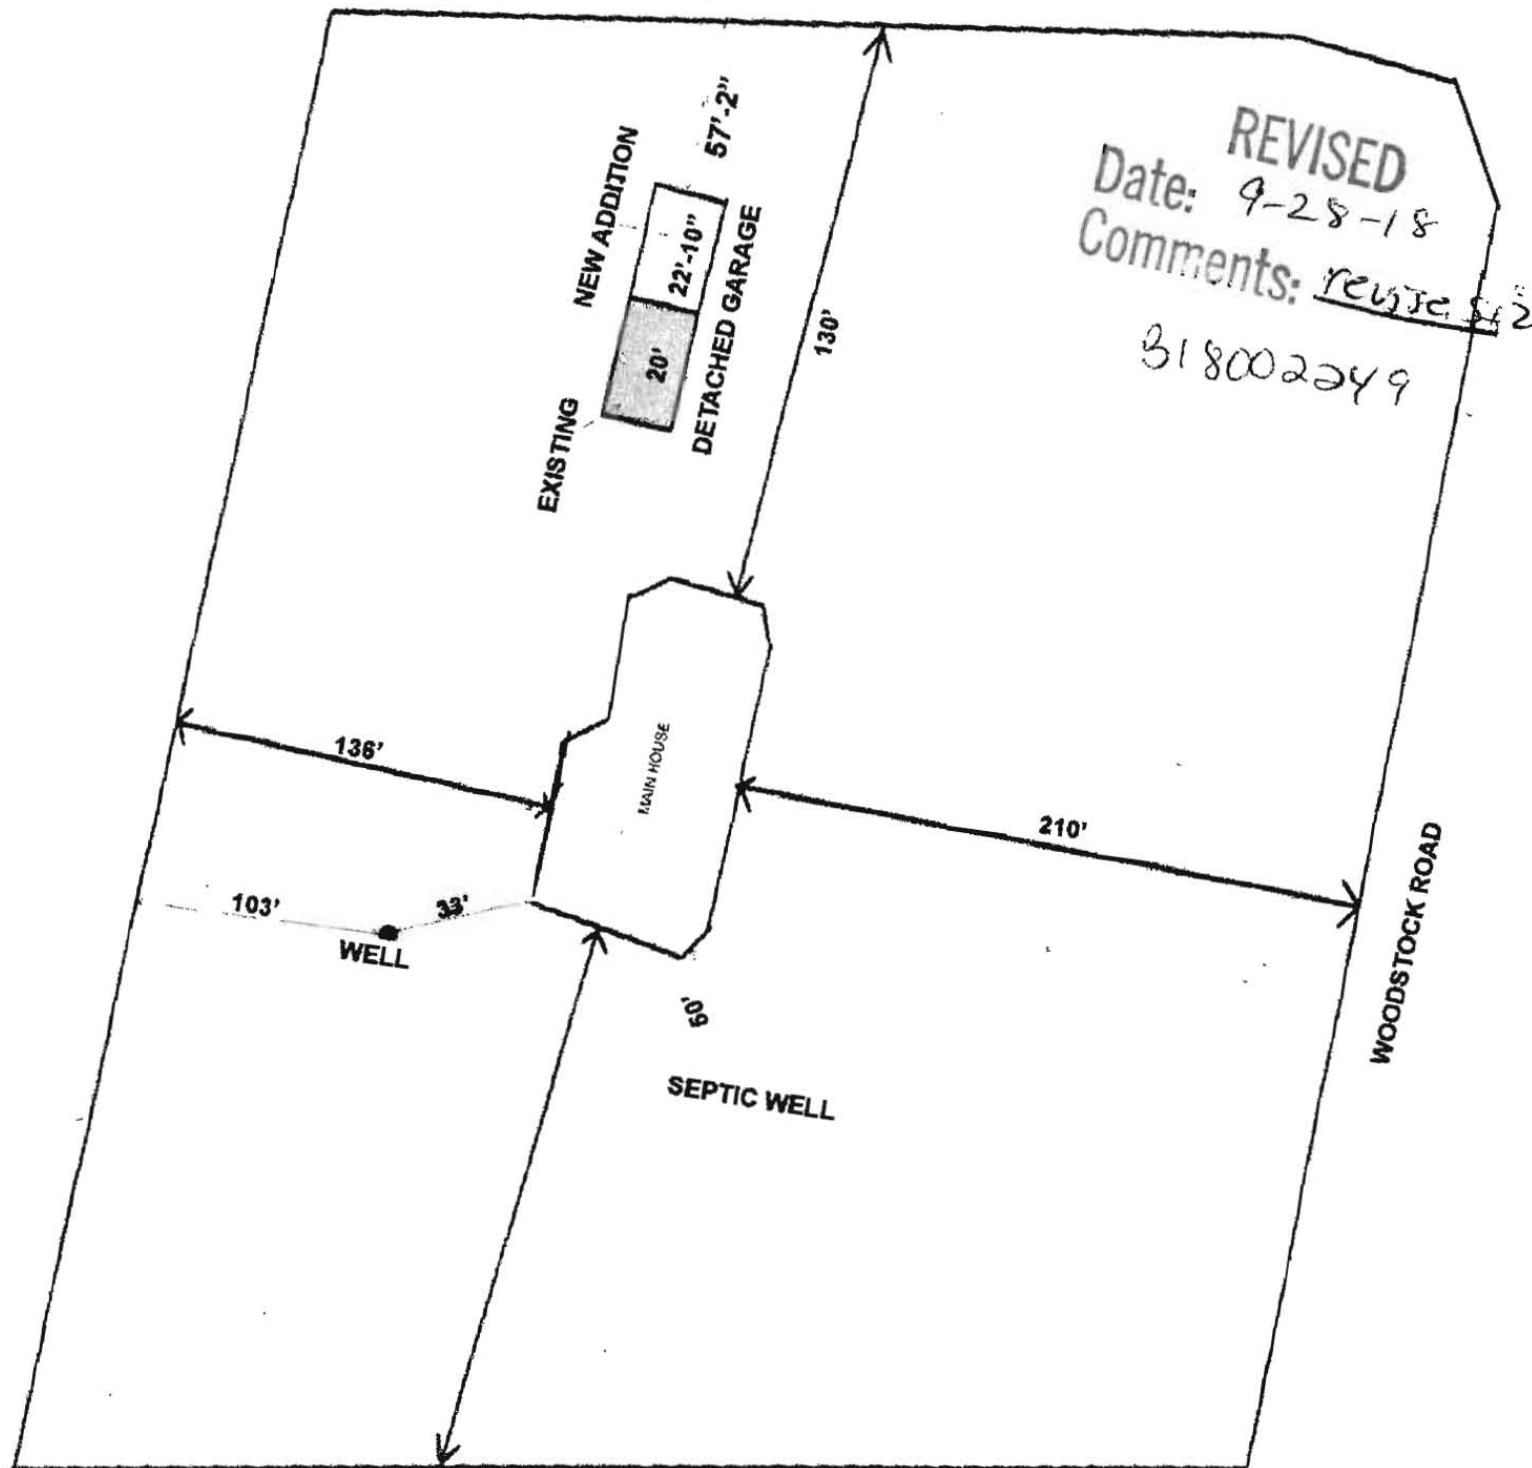

1801 QUARTER HORSE DRIVE, WOODSTOCK, MD, 21163
PARCEL - 03310442
LOT SIZE- 3 ACRES

B# B18002249