

Name: JASWINDER SINGH
Street Address: 1801 QUARTER HORSE DR.
City, State, Zip: WOODSTOCK, MARYLAND 21163
Date: 08-30-18

Amendment, Permit # B18002249

Ms. Debbie Whalen
Division of Plan Review
Department of Inspections, Licenses and Permits
Howard County Government
3430 Court House Dr
Ellicott City, MD 21043

Dear Ms. Whalen:

I am requesting to amend Permit # B18002249 at
1801 QUARTER HORSE DR. WOODSTOCK, MD 21163 to
a detached add-on CAR GARAGE has been extended an additional
4 feet from the previous approved drawing.
(Extend existing detached garage an additional 4 feet)

Enclosed:

1 Fee: 50.00
4 Plot Plans
2 Sets of Construction Drawings
Other: _____

If there is anything we can do to assist you, please let me know.

Sincerely,

CC: P1Z
Heather

RECEIVED
AUG 30 2018
L. J. [illegible]
[illegible]

Name: JASWINDER SINGH
Title: OWNER
Phone: 443-742-5441
Email: HARRYXS@CIVE.COM


Amendment Letter

* To be Picked up *

REVISED

Date: 8-30-18

Comments: Revised site plan to extend detached garage an additional 4 feet

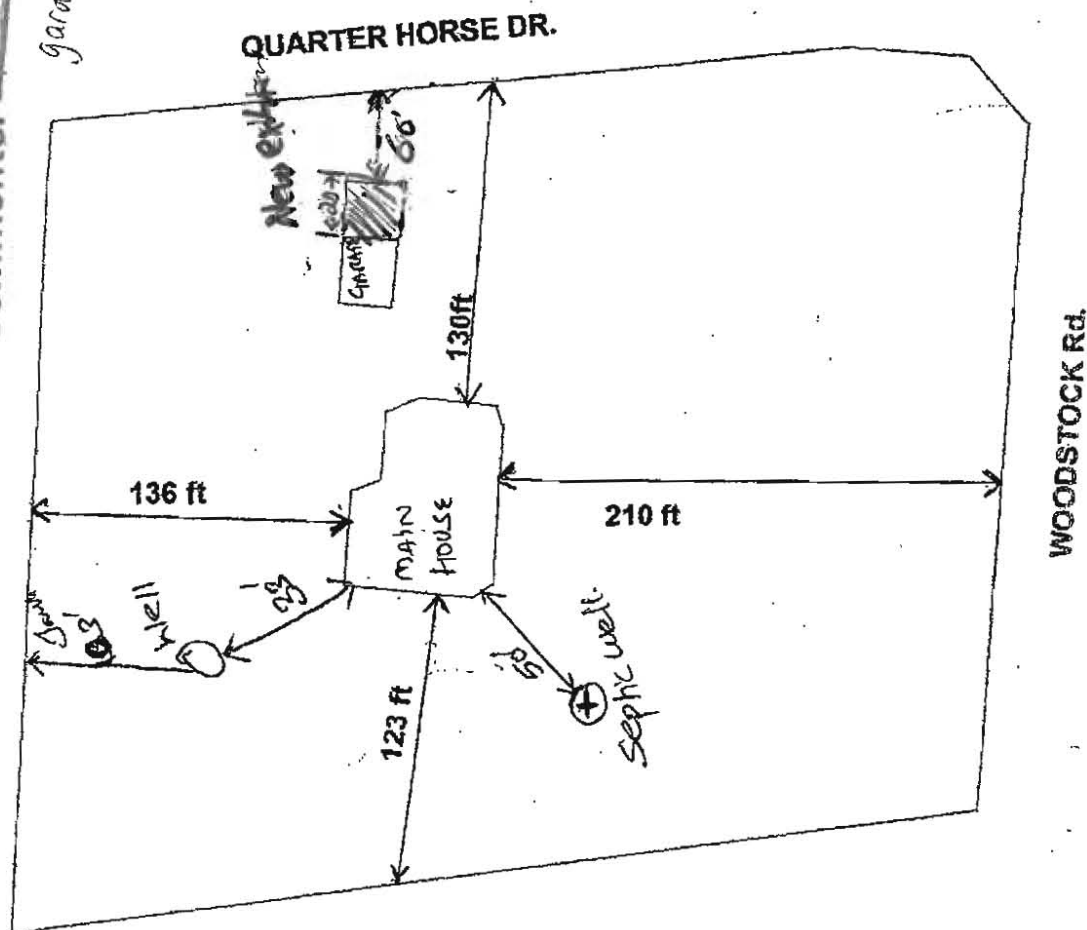

1801 QUARTER HORSE Dr, WOODSTOCK MD.21163

PARCEL- 03310442

LOT - 173-066 A.

LOT SIZE - 3 Acres

APPROVED

WALK-THRU BUILDING PERMIT

BP# B18-2249 A#

APP. SAN H. Oswald DATE: 6/27/18

DESC. OF WORK: Replace damaged part of roof on garage and add approx. 300 sq ft to garage.