

LAYOUT None Given (LW) INSP 4 _____
INSP 2 8/20/08 INSP 5 _____
INSP 3 8/22/08 INSP 6 _____

ISSUE DATE: _____

PERMIT

P 529533

APPROVAL DATE: 8/22/08

A 529454

TAX ID # 03300366

ON-SITE SEWAGE DISPOSAL SYSTEM HOWARD COUNTY HEALTH DEPARTMENT BUREAU OF ENVIRONMENTAL HEALTH

Michael Runx Plumbing + Heating PERMITTED TO INSTALL ☒ ALTER ☐

ADDRESS: P.O. Box 1453 Sylvestre PHONE NUMBER: 410.781.6791

SUBDIVISION: _____ LOT NUMBER: _____

ADDRESS: 1739 Woodstock Rd PROPERTY OWNER: Mike Smith

SEPTIC TANK CAPACITY (GALLONS): 1000 OUTLET BAFFLE FILTER REQUIRED ☐

PUMP CHAMBER CAPACITY (GALLONS): _____ COMPARTMENTED TANK REQUIRED ☒

NUMBER OF BEDROOMS: 4

SQUARE FEET PER BEDROOM: _____

LINEAR FEET OF TRENCH REQUIRED: 103

TRENCHES:	Trench to be 3.0 feet wide. Inlet 3.0 feet below original grade. Bottom maximum depth 6.0 feet below original grade. Effective area begins at 4.0 feet below original grade. 3.0 feet of stone below distribution pipe.
LOCATION:	Abandon existing drywell. Run 1x100' trench on contour at highest part of easement.
NOTES:	Layout required prior to installation. Install system per plan unless otherwise directed by HCHD. Verify pipe from house to tank is schd 40.

PLANS APPROVED: Heidi Scott DATE: 7/16/08

NOTE: PERMIT VOID AFTER 2 YEARS

NOTE: CONTRACTOR RESPONSIBLE FOR SCHEDULING A PRE-CONSTRUCTION INSPECTION FOR ALL INSTALLATIONS


NOTE: WATERTIGHT SEPTIC TANKS REQUIRED

NOTE: ALL PARTS OF SEPTIC SYSTEM SHALL BE 100 FEET FROM ANY WATER WELL

NOTE: MANHOLE RISERS REQUIRED ON ALL SEPTIC TANKS AND PUMP CHAMBERS UNLESS SPECIFICALLY AUTHORIZED

**NEITHER THE HOWARD COUNTY COUNCIL NOR THE HEALTH DEPARTMENT IS
RESPONSIBLE FOR THE SUCCESSFUL OPERATION OF ANY SYSTEM
PERMITTEE RESPONSIBLE FOR OBTAINING FINAL APPROVAL ON THIS PERMIT
CALL 410-313-1771 FOR INSPECTION OF SEPTIC SYSTEM**

NOT TO SCALE

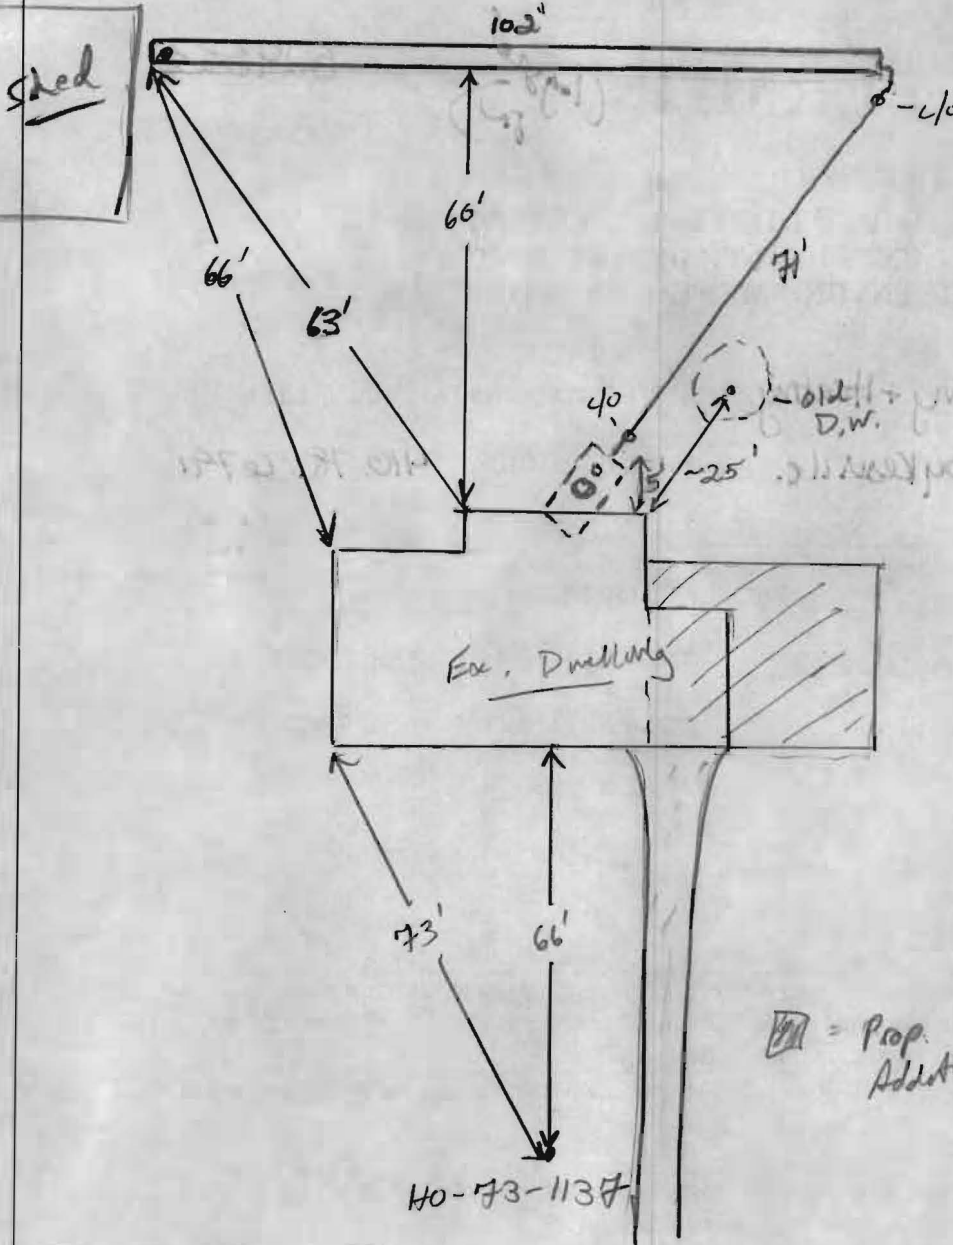

TRENCH/DRAINFIELD DATA
 WIDTH 3-3.5' INLET 3 BOTTOM 6?
 NUMBER OF TRENCHES 1
 TOTAL LENGTH 102
 ABSORPTION AREA 306 + SW
 DISTRIBUTION BOX LEVEL N/A
 DISTRIBUTION BOX BAFFLE N/A
 DISTRIBUTION BOX PORT N/A

EX SEPTIC TANK DATA
 SEPTIC TANK 1 LEVEL ?
 MANUFACTURER ?
 CAPACITY ? GAL
 SEAM LOC 00
 TANK LID DEPTH 4'
 BAFFLES Rear
 BAFFLE FILTER —
 MANHOLE LOC —
 6" PORT LOC —
 WATERTIGHT TEST ✓
 SLOTTED 00
 PUMP/SEPTIC TANK LEVEL —
 MANUFACTURER —
 CAPACITY — GAL
 SEAM LOC —
 TANK LID DEPTH —
 BAFFLES —
 BAFFLE FILTER —
 MANHOLE LOC —
 6" PORT LOC —
 WATERTIGHT TEST —
 SLOTTED —

PRE-CONSTRUCTION

8/20/08 upon Arrival, contractor (who I've never seen before) had system completed already. He used red laser paper, no obs. port @ end of trench, No layout was given, no c/o, tank had no man-hole access brought to grade. In support of BP, must have obs. port, c/o, rear/c/o on Tank before final approval (P.D.). 8/22/08 Rear added on Tank. c/o's added and obs. port installed @ end of trench.

FINAL INSPECTOR

DATE OF APPROVAL

8/22/08

1739

WOODSTOCK ROAD

Point of Beginning
N 27° 52' 43" E 118.85'
C.P. of 2nd Line
C.M.P. 647/367

mm ①

Drive
WELL

3rd and 4th Lines
C.M.P. 647/387

Quarry

293.00'

N 62° 07' 17" W

F.F. 434.50
B.F. 1126.55

Area of Lot
14,417 sq ft

30'

Lot 2
Block C

S 27° 32' 43" W 57.00'

S 60° 19' 53" W 133.05'

SAME AS Lot 2

Block C SHORRY VALLEY
SUBDIVISION

1739

WOODSTOCK ROAD

N 27° 52' 43" E - 118.85'

Point of Beginning

Part of 2nd Line
C.M.P. 647/387

Driveway

WELL

FR 43452
BF 43452

Area of Lot
44,417 sq ft

32' 00" 00" E

327.87'

57.00'

S 27° 52' 43" W

S 60° 15' 53" W - 133.05'

me AS Lot 2

Block C SHORRY VALLEY

WOODSTOCK ROAD

N 27° 52' 43" E - 118.85'

Point of
Beginning

Part of 2nd Line
C.M.P. 647/387

→ 15, 16, 17, 849, 85

FR 43450
BF 42630

Area of Lot
44,417 sq ft

37
3 70° 00' 00" E
Lore and 4th Lines
C.M. 18647/387

X PERC LOCATIONS

N 62° 07' 17" W

267.87

5. 27° 52' 43" W

57.00'

5.60° 19' 53" W

133.05

LOT 2
BLOCK C

SAME AS Lot 2

Block C

SHORRY GALLERY
SUBDIVISION