

Building Permit Application

Howard County Maryland

Department of Inspections, Licenses and Permits
3430 Court House Drive

Permits: 410-313-2455 www.howardcountymd.gov


Date	Received:	

Permit No :		
	Permit No.:	

Building Address: 11046 Dot	rsch Farm	Load Property Owner's Name: Nicholas Dalesio.				
city: Ellirot City State:						
	WP/BA #:	City: State: Mb Zip Code:				
	WP/BA #:	Fmail: 3				
Subdivision: 2041						
Lot: 69 Tax Map:	Parcel: 000	Applicant's Name & Malling Address, (if other than stated herein) Applicant's Name: With Wilson				
		Applicant's Name: NOW WIFON Address: 00 Box 175				
Existing Use:		Address: VO Says 175 City: Film State: MD Zip Code: 21110 Phone: 40-143-1117 Fax: Fax: Fax:				
Proposed Use: Sreen Porch	/deck	Phone: 4(0 - 463 - 114 Fax:				
Estimated Construction Cost: \$ 2.5	000	The state of the s				
Description of Work: 22 × 13	Scoren Davish	Contractor Company; Custom Works				
		Contact Person: Glen Wilson				
with open deck.	JONIA MANERS	- Address: 0.0. Bas 175				
2x9 cager doub	e Hashing.	City: Civa State: MD Zip Code: 31190				
2+2×12 beams, 2	1 8 SOIX	License No.: MHIC 01-41343				
		Phone: 410 - 4 4 - 111 9 Fax:				
		Email: a wiken & cwinch d. com				
Occupant/Tenant Name:						
Was tenant space previously occupied?	□Yes	No Engineer/Architect Company: _ Custom Works				
Contact Name:		Responsible Oesign Prof.: Glen Wilson				
Address:		Address: P.O. Bak 175				
City:Si						
Phone:	ax:	Phone: 410-963-1119 Fax:				
Email:		Email: gwitton & cwincind. com				
	I n 14 at 1 n 14 t a ct	Tolly Co.				
Commercial Building Characteristics Height:	Residential Building Chart SF Dwelling ☐ SF Town					
No. of stories:		dth Gas: Dives Divo				
Gross area, sq. ft./floor:	1st floor:	000.				
	2 nd floor:	Water Supply ☑ Public				
Area of construction (sq. ft.):	Basement:					
	☐ Finished Basement	Private				
Use group:	Unfinished Basement	Sewage Disposal				
Construction Live	☐ Crawl Space	Public				
<u>Construction type:</u> ☐ Reinforced Concrete	□ Slab on Grade No. of Bedrooms:	© Private				
☐ Structural Steel	Multi-family Dwell	Heating System				
☐ Masonry	No. of efficiency units:	W Electric □ OII				
☐ Wood Frame	No. of 1 BR units:	□ Natural Gas □ Propane Gas				
☐ State Certified Modular	No. of 2 BR units:	Other:				
	No. of 3 BR units: Other Structure:	Sprinkler System:				
	Dimensions:	☐ Yes ☐ No				
> Roadside Tree Project Fermit	Footings:					
□Yes □ ElNo	Roof:	Grading Permit Number:				
Roodside Tree Project Permit #	☐ State Certified Modular					
	☐ Manufactured Home	Building Shell Permit Number:				
THE UNDERSIGNED HEREBY CERTIFIES AND AGREES AS FOLLOWS: (1) THAT HE/SHE IS AUTHORIZED TO MAKE THIS APPLICATION; (2) THAT THE INFORMATION IS CORRECT; (3) THAT HE/SHE WILL COMPLY WITH ALL REGULATIONS OF HOWARD COUNTY WHICH ARE APPLICATION; (3) THAT HE/SHE WILL PERFORM NO WORK ON THE ABOVE REFERENCED PROPERTY NOT SPECIFICALLY DESCRIBED IN THIS APPLICATION; (5) THAT HE/SHE GRANTS COUNTY OFFICIALS THE RIGHT TO ENTER ONTO THIS PROPERTY FOR THE PURPOSE OF INSPECTING THE WORK PERMITTED AND POSTING NOTICES. APPLICATION; (5) THAT HE/SHE GRANTS COUNTY OFFICIALS THE RIGHT TO ENTER ONTO THIS PROPERTY FOR THE PURPOSE OF INSPECTING THE WORK PERMITTED AND POSTING NOTICES. Print Name Print Name 0 / 15/18						
	Checks Payable to: DI	ECTOR OF FINANCE OF HOWARD COUNTY				
DECEMBER ASSESSMENT	**PLEA	WRITE NEATLY & LEGIBLY**				
BOALUS SALESSES	/	R OFFICE USE ONLY-				
AGENCY DATE SI	GNATURE OF APPROVAL	PZ SETBACK INFORMATION Filing Fee \$				
State Highways		ront: Permit Fee \$ lear: Tech Fee \$				
Building Officials		ide: Excise Tax \$				
PSZA (Zoning)		ide St.: PSFS \$				
PSZA (Engineering)		Ul minimum setbacks met? Yes No Guaranty Fund \$				
to 227		Entrance Permit Required?				
Health 10 35-18	market	ot Coverage for New Town Zone: Sub-Total Paid \$				
Is Sediment Control approval required for CONTINGENCY CONSTRUCTION START	ssuance? ☐ Yes ☐ Nó	DP/Red-line approval date: Balance Due \$				
		Check #				

.FIS S G LWO puge document and is not valid without both pages. See page two (or reverse) for Survey Notes.



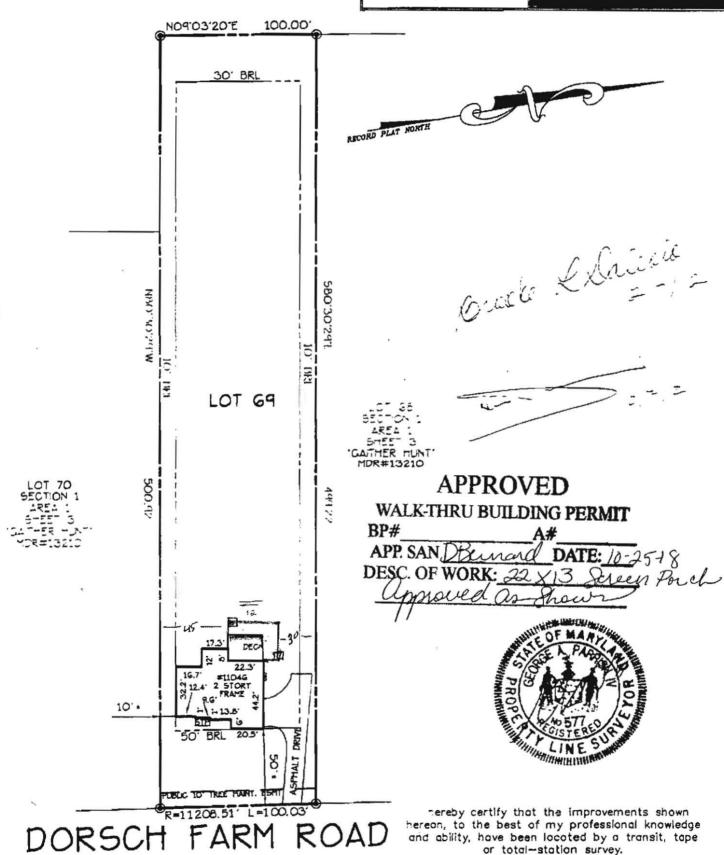

GEORGE A. PARRISH IV PROP.LS#577 11/06/12

and ability, have been located by a transit, tape or total-station survey.