

APPLICATION

FOR PERCOLATION TESTING AND SITE EVALUATION

DATE 5/16/88

TEST DATE(S)______ TEST TIME _____

AGENCY REVIEW: _____

DO NOT WRITE ABOVE THIS LINE

CHECK AS NEEDED:	ECESSARY TESTING/EVALUATION SEPTIC SYSTEM(S) N EXISTING SEPTIC SYSTEM STING SEPTIC SYSTEM	(CHECK AS NEEDED:	E(S)	
	T(S) STING LOT IN A SUBDIVISION STING PARCEL OF RECORD		S THE PROPERTY WIT □ YES ☞ NO	HIN 2500' OF ANY RES	ERVOIR?
THE TYPE OF STRUCTU SE RESIDENTIAL WITH COMMERCIAL INSTITUTIONAL/GOV	PROPOSED BE (PROVIDE DETAIL OF N	NUMBERS AND TYPE	D TYPES OF EMPLOYE	ES/USERS ON ACCOM	PANYING PLAN)
PROPERTY OWNER(S)	FRED IFF	<u> </u>	Jusanr	in rati	
DAYTIME PHONE $4/\ell$	13653950 CEI	L <u>44332</u>	48638	FAX	
MAILING ADDRESS	1565 WOOT	DSTOCK J	CITY/TOWN	STOCK MD STATE	2/163
APPLICANT OWNE	R				
DAYTIME PHONE	CEL	L		FAX	
MAILING ADDRESS					
S	STREET		CITY/TOWN	STATE	ZIP
APPLICANT'S ROLE: DI	EVELOPER BUILDER	BUYER	RELATIVE/FRIEND	REALTOR	CONSULTANT
PROPERTY LOCATION SUBDIVISION/PROPERTY I	NAME			LOT N	0
PROPERTY ADDRESS	565 WOODS7 STREET	ock Rd	TOWN/PC	DSTOCIC DST OFFICE	MD 21163
TAX MAP PAGE(S) 10		PARCEL(S) 140	1 PF	ROPOSED LOT SIZE	
AS APPLICANT, I UNDERS	TAND THE FOLLOWING: TH	E SYSTEM INSTAL	LED SUBSEQUENT	TO THIS APPLICATIO	ON IS ACCEPT-
ABLE ONLY UNTIL PUBLIC	SEWERAGE IS AVAILABLE.	THIS APPLICATION	ON IS COMPLETE W	HEN ALL APPLICABL	E FEES AND A
SUITABLE SITE PLAN HAV	E BEEN RECEIVED. I ACCE	PT THE RESPONS	IBILITY FOR COMPL	IANCE WITH ALL M.	O.S.H.A. AND
"MISS UTILITY" REQUIREM	IENTS. APPROVAL IS BASE	D UPON SATISFA	TORY REVIEW OF	A PERC CERTIFICAT	ION PLAN.
TEST RESULTS WILL BE M	AILED TO APPLICANT.		SIGNATURE OF AP	PLICANT	
	ALTH DEPARTMENT, BUR A GATEWAY DRIVE COLU TDD (410) 313-23	UMBIA, MARYLA	<i>(</i>) NMENTAL HEALTH	I, WELL AND SEPT	



Bureau of Environmental Health 7178 Columbia Gateway Drive, Columbia, MD 21046-2147 (410) 313-2640 Fax (410) 313-2648 TDD (410) 313-2323 Toll Free 1-866-313-6300 website: www.hchealth.org

Peter L. Beilenson, M.D., M.P.H., Health Officer

June 5, 2008

Fred and Susanna Taft 1565 Woodstock Road Woodstock, MD 21163

RE: PERCOLATION TEST RESULTS, 1565 Woodstock Road, A528916

Dear Mr. & Mrs. Taft,

Percolation testing was conducted on May 23, 2008, on your property (1565 Woodstock Road). Soil profiles were observed and recorded at four locations, and at 3 of those locations percolation testing was conducted. The area investigated is on moderately steep slopes along the east and north property boundaries, i.e. the hillside that is your back yard.

All locations had percolation rates that are approvable, and all observed locations have approvable soil profiles. The better soils are along the northern boundary of your property as a deep, sandy loam subsoil occurs there that has a moderately rapid percolation rate. However, the water table ranges from deeper than 14 feet (test location 3) to 10.5 feet (test location 4). The soils in the southeast property corner have been altered, the topsoil being removed from the area represented by test location 1 and apparently deposited in the area represented by test location 2. Depth to the underlying rock layer is 7 feet at test location 1 and 10 feet at test location 2. Slopes of 25% to 30% were measured in the areas tested. An area immediately uphill of your garage (that wasn't tested) has a slope of about 40%.

These percolation tests were conducted under the assumption that the well for the subject property could be re-located, and the area tested would meet the regulated setback distance. A complicating factor has become evident as the existing well for the neighboring property (1555 Woodstock Road) has been found to be about 68 feet from test location 4. That well is a dug-well about 3 feet in diameter with stacked-stone walls. The observed water level in late May was about 6 feet from the soil surface. The well has a plywood and wood-frame cover. Its recharge area is downgradient from both your existing septic system and the areas tested.

For a 2-bedroom house, the area and depth of soil in the northeast corner of your property appears to be adequate for 3 septic drainfields of conventional design while maintaining a 100-foot separation from the well at 1555 Woodstock Road. For a 3-bedroom residence, the southeast corner of your property would also need to be included in a septic easement.

Even for these relatively small areas, there are several conditions that must be overcome to have them approved as septic easements. Code of Maryland (COMAR, 26.04.02.04.J.1) requires a setback of 25 feet from steep slopes (i.e., slopes greater than 25%). Also, for unconfined aquifers such as occurs in Howard County, COMAR 26.04.02.04.J.10 requires 100 feet separation between septic easement or septic tank and a well. Howard County Code 3.808.D.3 has a more stringent requirement for well-septic separation in that a septic easement must be 200 feet distant from a well that is downgradient. Your entire property is within 200 feet of the well that serves the neighboring downhill property.

		1-		- 10	55 1	27.	1			Θ	
dkgreybrast	15-1	20'	· .			35	Plat 1	, 15°		common	cl shk wice
sed-brn SIX		M	54		00	/		1	30%	(Fill)	
branymice brasl			¥ a		-20	L	5 39		2-	many mi	
1 Cew stones many mica br n tak bro		50	1		Ķ		M.CO.	3210		hon sl micased	
SI suprolite Manymice	30le	~	<i>.</i>	ŕ		A	1000	v T	3-	It bould	รโ
vby sl p->50%	27'	74	20	}		Ga	roge			ten gran	
dk grey-brn		-1	5-124	=rt-]				85	brn,	Ţ
1 SI heavy	2		l propos		use		LD1	¥		ar a	
1 common mice			1.	15	65 Na		ckRd	4:			
1 many mila	DATE	TEST #	DEPTH	START	BREAK 1" DROP	STOP 2" DROP	TIME OF 2ND INCH	P/F/H			
many mea	5/23/08	#1	20/65	9:53 Visuo	1 1 1	10:32 pseil (tat)	P		(3)]
JR. brngr51	5/21	<i>₹</i> ∠ 7	8.5 31/11	11:41	<u>Sau</u>	11.48	3' TO 8.	P	, ,	ak brn	fl(hea
twet-care	5/23/08	4	3.5	12:25		16 76	5	P	03-	brn sc	
brages(<u>(</u>)	Common 1556K EEW gr brages	wel
- 10 ⁻¹									3'.	bruges	brn
Salar Contractor									11-	brusolk sisapro micaceo Variega	lite
in Seale										SI SPOID	IU TE
a series	REMARKS [Tope	neoded at	*					11-	some w/	Bepl
	SANITARIAN_	1	PB	BAC	KHOE <u>Pen</u>	n's Fear		s_`	N		
	TEST HOLES U	JSED IN S	DA			AVG.	PERC TIME		SQ. F	T/BR	
	TRENCH WIDT										

100 miles

Further consideration for your proposal to build an addition to your residence is contingent upon submission of a Percolation Certification Plan that meets state and county requirements. The Health Department has already considered an exception to the rule excluding areas on slopes 25% and greater. We encourage you to offer your concerns and inquiries. You may request variances to regulated setback distances. I believe you have been advised of the potential for installation of pre-treatment options, and the Bay Restoration Fund where you may obtain a grant to help with the cost of adding a pre-treatment component to your wastewater system.

I am including copies of the field data worksheet and site inspection sheet generated during my field investigation. This report and these documents will be maintained in the Health Department for the address of your property. I am also enclosing a 4-page document that describes the required content for a Percolation Certification Plan and a 2-page document that lists the regulated setback distances, both excerpts of Howard County Code Title 3, Subtitle 8. If you have any questions regarding this matter, please contact me at the above address or by calling (410) 313-2691.

Respectfully,

Robert Bricker, CPSS, RS Well and Septic Program Development Coordination Section

Copy: Heidi Scott, Environmental Sanitarian File



Bureau of Environmental Health 7178 Columbia Gateway Drive, Columbia, MD 21046-2147 (410) 313-2640 Fax (410) 313-2648 TDD (410) 313-2323 Toll Free 1-866-313-6300 website: www.hchealth.org

Peter L. Beilenson, M.D., M.P.H., Health Officer

November 5th, 2008

Fred & Susanna Taft 1565 Woodstock Rd. Woodstock, MD 21163

RE: Variance request 1565 Woodstock Road

Dear Mr. and Mrs. Taft,

The Health Department has received your variance request dated June 20th, 2008 for the above referenced property. Maryland Department of the Environment has accepted our recommendation to approve the variance request allowing the sewage disposal system and future repair area to be located up gradient from private water supplies and within the 25'setback to 25% or greater slopes. Due to the landscape position of the sewage areas and wells, the request was approved subject to the following conditions:

1. An advanced pre-treatment system, which utilizes best available technology to perform nitrogen reduction, must be installed on the existing septic system prior to the approval of your building permit. In addition, an operation and maintenance contract agreement must be filed with Howard County Land Records. Before a septic system installation permit is released for the advanced pre-treatment system, a site plan must be submitted with all necessary details for installation of the system.

If you have any questions regarding this matter, please contact me at the above address or by calling (410) 313-6287.

Sincerely,

Heidi Scott Well and Septic Program

Maryland Department of the Environment

Cc: File Mr. Mike Davis Bureau of Environmental Health 7178 Columbia Gateway Drive Columbia, MD 21046

Mr. Davis,

We are contacting you in hopes of getting a variance for our property at 1565 Woodstock Road, Woodstock, MD 21163. We purchased our home a few years ago and in January of this year we had a fire there. We decided to take advantage of the fact that we would have to do considerable renovations, and build an addition onto the extisting home. The permits have been put on hold however because your department has found the current septic lacking. This is an odd lot with a house on it that is about 100 years old and considerable slope to the lot. The solution your department has suggested involves a pretreatment septic system. However in order for this to work we need a variance to the 25' setback from the 25% slope for septic easement. We also are seeking an easement to the 200' setback from the well that is directly down gradient, the entire property does not fit this criteria.


Our departmental contact is Heidi Scott, we believe she may be able to furnish you with any other information you may need. The property was recently perced and a Percolation Certification Plan is in the works. In addition, we have submitted a pre-application to the Bay Restoration Fund for financial assistance with the pre-treatment system. Please contact us with any questions or comments.

Regards,

Jusanni

Fred and Susanna Taft/ 1565 Woodstock Road Woodstock MD 21163

410-365-3950 443-324-8638

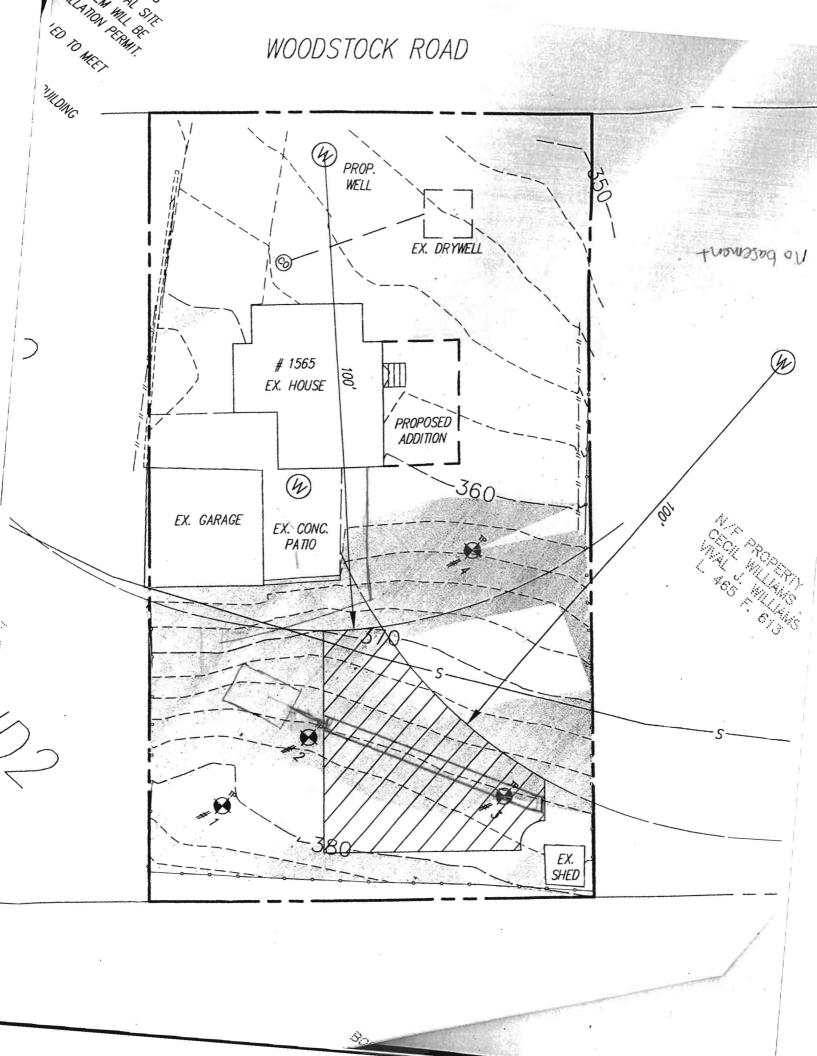

GENERAL NOTES:

- 1. THIS AREA DESIGNATES A PRIVATE SEWERAGE DISPOSAL AREA AS REQUIRED BY THE MARYLAND STATE DEPARTMENT OF THE ENVIRONMENT FOR INDIVIDUAL SEWERAGE DISPOSAL. IMPROVEMENTS OF ANY NATURE IN THIS AREA ARE RESTRICTED. THIS SEWAGE DISPOSAL AREA SHALL BECOME NULL AND VOID UPON CONNECTION TO A PUBLIC SEWERAGE SYSTEM. THE COUNTY HEALTH OFFICER SHALL HAVE THE AUTHORITY TO GRANT ADJUSTMENTS TO THE PRIVATE SEWERAGE DISPOSAL AREA.
- 2. ANY CHANGES TO A PRIVATE SEWAGE EASEMENT SHALL REQUIRE A REVISED PERCOLATION CERTIFICATION PLAN.
- 3. ALL EXISTING WELLS AND/OR SEWERAGE EASEMENTS WITHIN 100 FEET OF THE PROPERTY HAVE BEEN SHOWN FROM THE BEST AVAILABLE INFORMATION.
- 4. TOPOGRAPHY IS FIELD RUN BY GUTSCHICK, LITTLE & WEBER, PA. IN AUGUST, 2008.
- 5. BOUNDARY INFORMATION IS BASED ON AVAILABLE RECORDS.
- 6. PROPERTY TABULATION: A. TAX PARCEL 144 B. TOTAL ACREAGE: 0.35 AC.
- 7. THE SEPTIC SYSTEM MUST HAVE ADVANCED TREATMENT DUE TO RESTRICTIVE FACTORS SUCH AS STEEP SLOPES AND LESS THAN 200' WELL SEPARATION. A SUPPLEMENTAL SITE PLAN WITH ALL OF THE NECESSARY DETAILS FOR INSTALLATION OF THE SYSTEM WILL BE REQUIRED PRIOR TO RELEASE OF THE BUILDING PERMIT AND SEPTIC INSTALLATION PERMIT.
- 8. THE EXISTING WELL IS TO BE ABANDONED AND A NEW WELL WILL BE DRILLED TO MEET CURRENT CODE PRIOR TO BUILDING PERMIT APPROVAL.
- 9. THE EXISTING SEPTIC SYSTEM IS TO BE ABANDONED AND UPGRADED PRIOR TO BUILDING PERMIT APPROVAL.
- 10. HOUSE SHALL HAVE A MAXIMUM OF 3 BEDROOMS.
- 11. MARYLAND DEPARTMENT OF THE ENVIRONMENT APPROVED A VARIANCE TO ALLOW ON-SITE SEWAGE DISPOSAL TO BE UP GRADIENT OF PRIVATE WATER SUPPLIES AND WITHIN 25' TO 25% OR GREATER SLOPES.

PERCOLATION CERTIFICATION

I CERTIFY TO THE INFORMATION SHOWN HEREON IS BASED ON FIELD WORK PERFORMED UNDER MY DIRECT SUPERVISION, AND IS CORRECT, TO THE BEST OF MY PROFESSIONAL KNOWLEDGE AND BELIEF.

Char 10-29-08 CARL K. GUISCHICK, P.E.

N/F PROPERTY OF PETER WILLIAM DAY & CARMEN KAY DAY L. 1549 F. 352

WOODSTOCK ROAD

W PROP.

(0)

1565 HOUSE

Et.

W

GARAGE

Et.

NIDZ

EX. CONC.

APPROVED FOR PRIVATE WATER AND PRIVATE SEWERAGE SYSTEMS, HOWARD COUNTY HEALTH DEPARTMENT

ster Brilensen II DATE MOC COUNTY HEALTH OFFICER




DRN.

CHK.

:\CADD\DRAWINGS\TAFT PROP(PAIGE SEE)\TAFT-PERC-PLAN.dwg DES.

PREPARED FOR : SUSANNA TAFT & FRED V. TAFT 1565 WOODSTOCK ROAD WOODSTOCK, MD 21163 PHONE: 410-750-9061

WEST FRIENDSHIP ELECTION DISTRICT No. 3

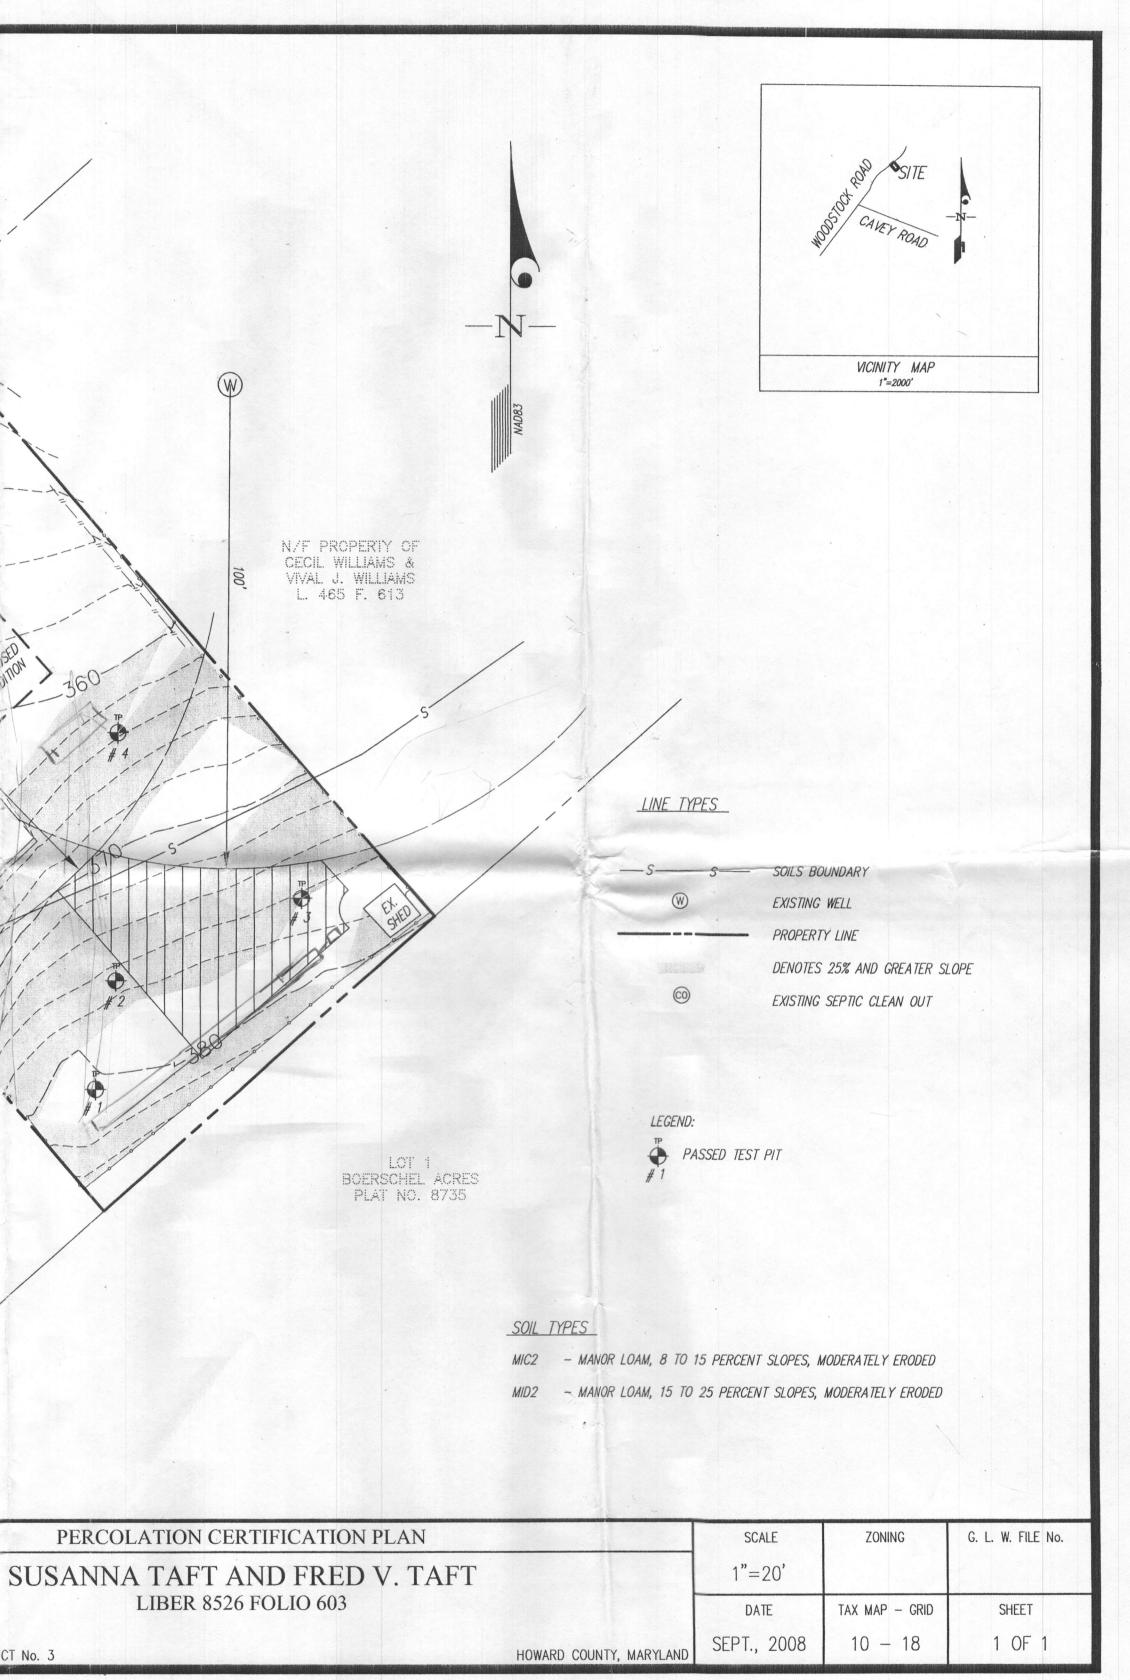

GENERAL NOTES:

- 2. ANY CHANGES TO A PRIVATE SEWAGE EASEMENT SHALL REQUIRE A REVISED PERCOLATION CERTIFICATION PLAN.
- 3. ALL EXISTING WELLS AND/OR SEWERAGE EASEMENTS WITHIN 100 FEET OF THE PROPERTY HAVE BEEN SHOWN FROM THE BEST AVAILABLE INFORMATION.
- 4. TOPOGRAPHY IS FIELD RUN BY GUTSCHICK, LITTLE & WEBER, PA. IN AUGUST, 2008.
- 5. BOUNDARY INFORMATION IS BASED ON AVAILABLE RECORDS.
- 6. PROPERTY TABULATION: A. TAX PARCEL 144 B. TOTAL ACREAGE: 0.35 AC.
- 7. THE SEPTIC SYSTEM MUST HAVE ADVANCED TREATMENT DUE TO RESTRICTIVE FACTORS SUCH AS STEEP SLOPES AND LESS THAN 200' WELL SEPARATION. A SUPPLEMENTAL SITE PLAN WITH ALL OF THE NECESSARY DETAILS FOR INSTALLATION OF THE SYSTEM WILL BE REQUIRED PRIOR TO RELEASE OF THE BUILDING PERMIT AND SEPTIC INSTALLATION PERMIT.
- 8. THE EXISTING WELL IS TO BE ABANDONED AND A NEW WELL WILL BE DRILLED TO MEET CURRENT CODE PRIOR TO BUILDING PERMIT APPROVAL.
- 9. THE EXISTING SEPTIC SYSTEM IS TO BE ABANDONED AND UPGRADED PRIOR TO BUILDING PERMIT APPROVAL.
- 10. HOUSE SHALL HAVE A MAXIMUM OF 3 BEDROOMS.
- 11. MARYLAND DEPARTMENT OF THE ENVIRONMENT APPROVED A VARIANCE TO ALLOW ON-SITE SEWAGE DISPOSAL AREA TO BE UP GRADIENT OF PRIVATE WATER SUPPLIES AND WITHIN 25' OF 25% OR GREATER SLOPES.

PERCOLATION CERTIFICATION

I CERTIFY TO THE INFORMATION SHOWN HEREON IS BASED ON FIELD WORK PERFORMED UNDER MY DIRECT SUPERVISION, AND IS CORRECT, TO THE BEST OF MY PROFESSIONAL KNOWLEDGE AND BELIEF.

Chan 10-29-08 CARL K. GUNCHICK, P.E.



APPROVED FOR PRIVATE WATER AND PRIVATE SEWERAGE SYSTEMS, HOWARD COUNTY HEALTH DEPARTMENT

B Nipon for Peter Brilensen 11/24/08 DATE COUNTY HEALTH OFFICER HS nga



CIVIL ENGINEERS, LAND SURVEYORS, LAND PLANNERS, LANDSCAPE ARCHITECTS 3909 NATIONAL DRIVE – SUITE 250 – BURTONSVILLE OFFICE PARK BURTONSVILLE, MARYLAND 20866 TEL: 301-421-4024 BALT: 410-880-1820 DC/VA: 301-989-2524 FAX: 301-421-4186

L:\CADD\DRAWINGS\TAFT PROP(PAIGE SEE)\TAFT-PERC-PLAN.dwg DES. DRN. CHK.

PREPARED FOR : SUSANNA TAFT & FRED V. TAFT 1565 WOODSTOCK ROAD WOODSTOCK, MD 21163 PHONE: 410-750-9061

N/F PROPERIY OF PETER WILLIAM DAY & CARMEN KAY DAY L. 1549 F. 352

WOODSTOCK ROAD

W PROP.

(00)

1565 HOUCE

VW

GARAGE


54.

NIDZ

EX PATIO

Et.

CI	TO
1	10

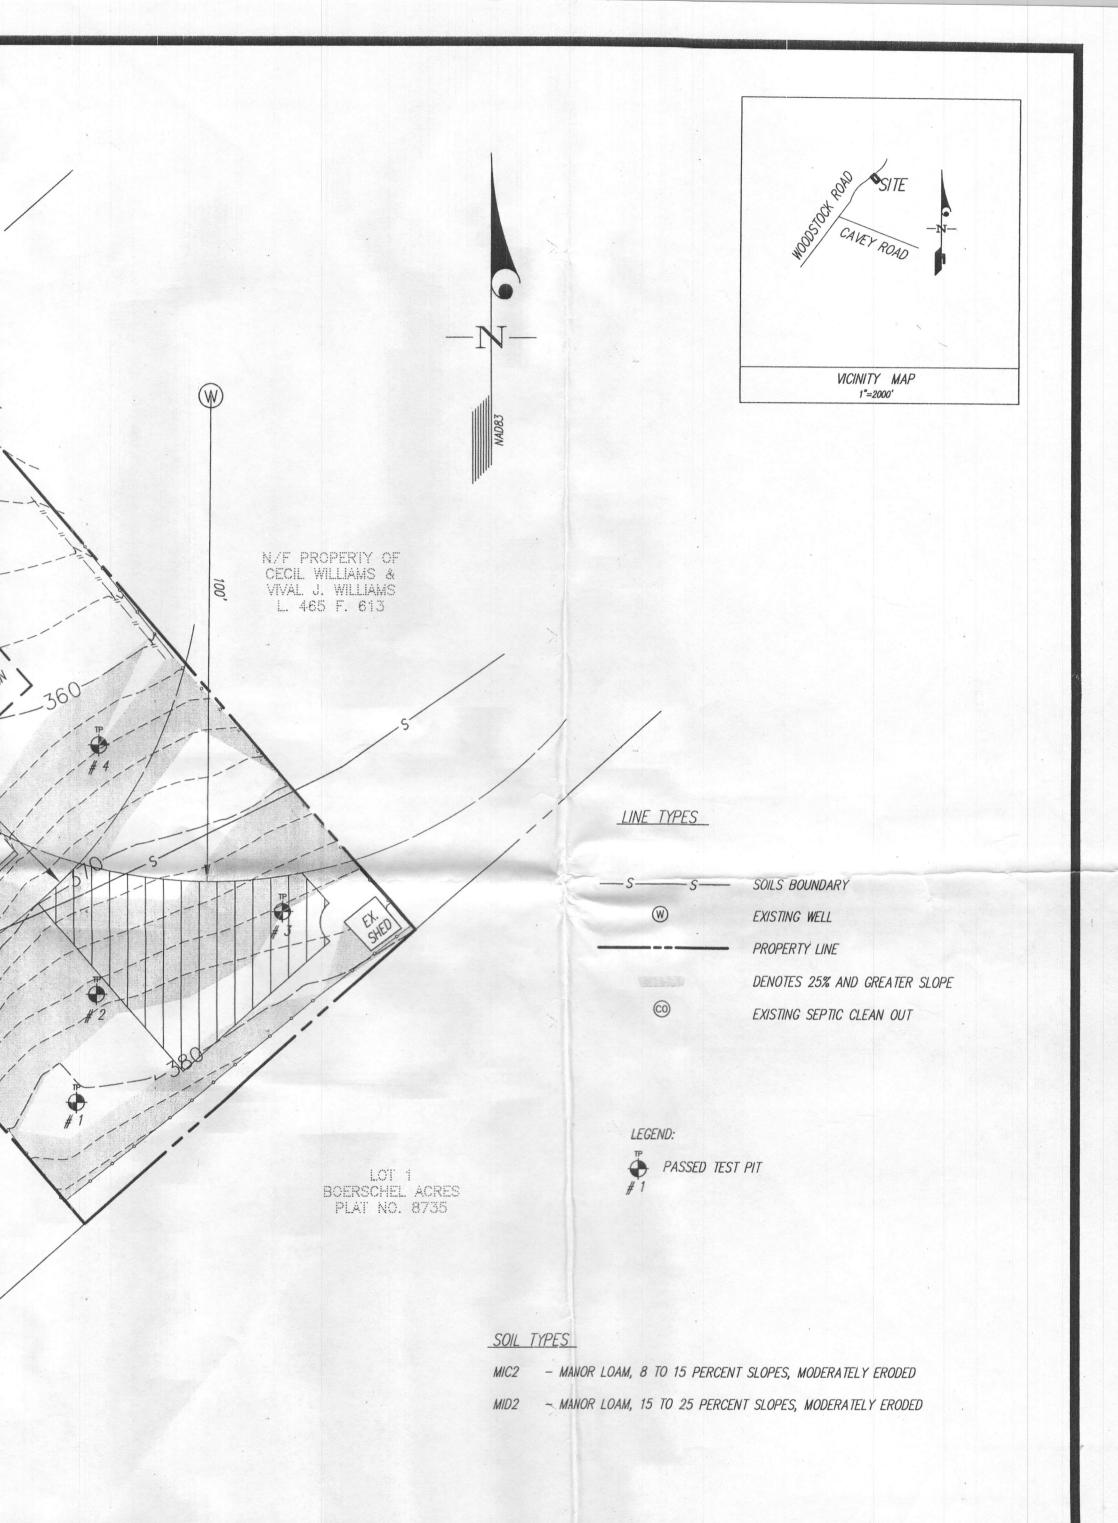

		Charles .		
PERCOLATION CERTIFICATION PLAN		SCALE	ZONING	G. L. W. FILE No.
SANNA TAFT AND FRED V. TAFT		1"=20'		
LIBER 8526 FOLIO 603		DATE	TAX MAP – GRID	SHEET
3	HOWARD COUNTY, MARYLAND	SEPT., 2008	10 - 18	1 OF 1