

APPROVED 7-30-79

R. Demarco

# PERMIT

SEWAGE DISPOSAL SYSTEM

MARYLAND STATE DEPARTMENT OF HEALTH\*

HOWARD COUNTY

05-348617

ELLICOTT CITY

DISTRICT 5th

DATE 3/20/79

INDEXED

Olen Ketterman

IS PERMITTED TO INSTALL ☒ ALTER ☒

ADDRESS 6119 Jerry's Drive, Columbia, Md. 21044

PHONE 997-8740

SUBDIVISION Clarksville Ridge ROAD 6601 Whitegate Road LOT 5

PROPERTY OWNER Mr. William F. Douglas

ADDRESS 6601 Whitegate Road, Clarksville, Md. 21029

## SPECIFICATIONS

SEPTIC TANK CAPACITY \_\_\_\_\_ GALLONS

DRAIN FIELD \_\_\_\_\_ DEPTH \_\_\_\_\_ FEET, BOTTOM AREA \_\_\_\_\_ SQ. FT.

DEEP TRENCH \_\_\_\_\_ DEPTH \_\_\_\_\_ FEET, BOTTOM AREA \_\_\_\_\_ SQ. FT.

SEEPAGE PITS \_\_\_\_\_ ABSORBENT SIDE-WALL AREA \_\_\_\_\_ SQ. FT.

INLET PIPE \_\_\_\_\_ FT. BELOW ORIGINAL GRADE, MAXIMUM DEPTH \_\_\_\_\_ FT. BELOW ORIGINAL GRADE

EFFECTIVE DEPTH AT \_\_\_\_\_ FT. BELOW ORIGINAL GRADE.

LOCATE DISPOSAL AREA \_\_\_\_\_ FT. FROM \_\_\_\_\_ LOT LINE AND \_\_\_\_\_ FT. FROM \_\_\_\_\_ LOT LINE AS SEEN WHEN

FACING LOT FROM \_\_\_\_\_

REPAIR - Call for an appointment when ground is opened up and Sanitarian will  
recommend the repair system.

PLANS APPROVED BY Palmer F. Wine

DATE 3/20/79

COVER NO WORK UNTIL INSPECTED AND APPROVED.

NEITHER THE HOWARD COUNTY COUNCIL NOR THE HEALTH DEPARTMENT IS RESPONSIBLE FOR THE SUCCESSFUL OPERATION OF ANY SYSTEM.

NOTE: IF TRENCH IS USED CALL FOR INSPECTION BEFORE PLACING GRAVEL IN TRENCH.

NOTE: NO DRY WELL SHALL EXCEED 16 FOOT IN DIAMETER.

NOTE: ALL PIPE FROM HOUSE TO DISPOSAL AREA MUST BE CAST IRON.

PERMIT VOID AFTER THREE YEARS.

NOTE: INSTALL STAND PIPE ON SEPTIC TANK AND DRY WELL. STAND PIPES MUST BE 6 INCHES IN DIAMETER. CAST IRON, CONCRETE OR TERRA

COTTA ACCEPTED.


\*INSTALLER IS RESPONSIBLE FOR OBTAINING FINAL APPROVAL ON THIS PERMIT.

HD - 23

BLDG. PERMIT SIGNED  
AND RETURNED 8-30-00

#00126200  
ENLARGE FRONT OF HOUSE

P29588

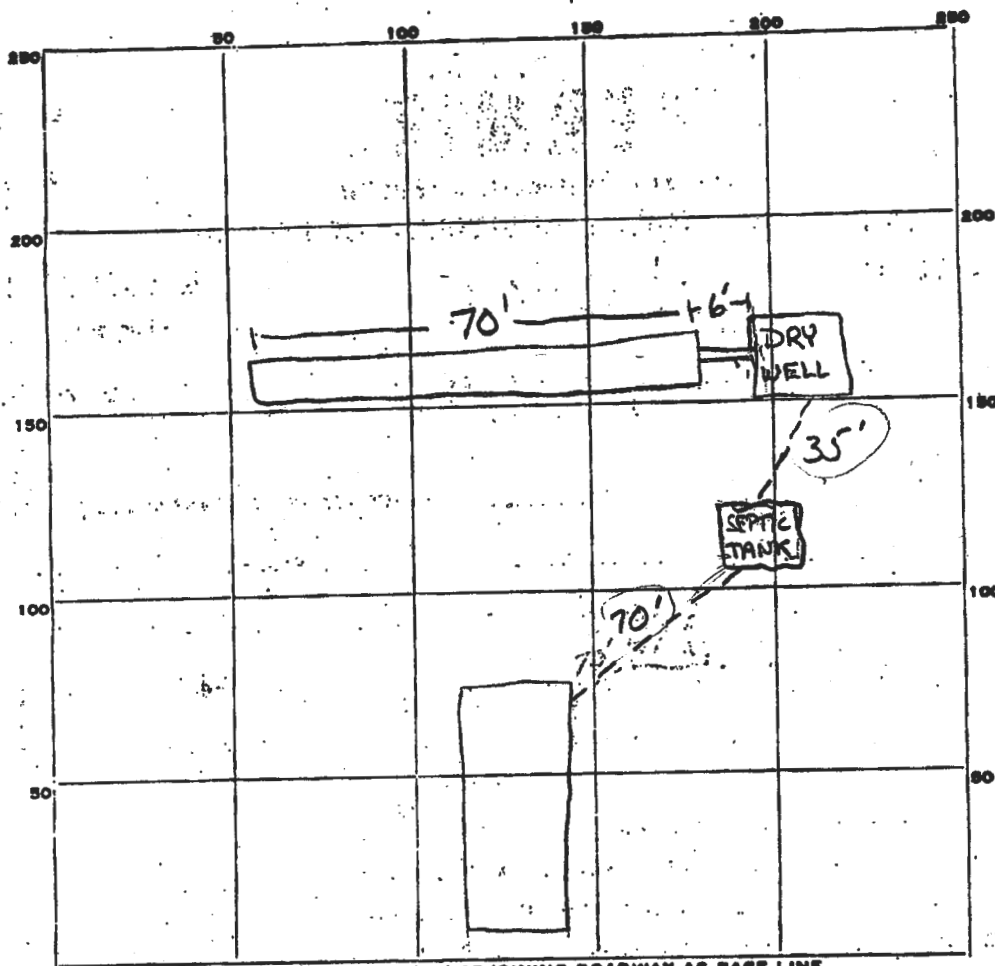

PERMIT CARD ✓

SEPTIC TANK, LEVEL                     

CLEANOUTS                     

DISTRIBUTION BOX, LEVEL                     

TILE FIELD, DEPTH 13' FT. TRENCH WIDTH 2' FT.

GRAVEL DEPTH 16" IN. TOTAL LENGTH 70' FT.

NUMBER OF TRENCHES 1 TOTAL BOTTOM AREA 420<sup>+</sup>

SEEPAGE PITS, INSIDE DIAMETER            FT. DEPTH BELOW INLET            FT.

ABSORBENT AREA 420<sup>+</sup> SQ. FT.

REMARKS 7-30-79 OK TO COVER. OWNER WILL VERIFY GRAVEL DEPTH.

DATE SYSTEM APPROVED

7-30-79

INSPECTOR

R. Romero