

4/8/80
check

9/8/80 File approved
C. 658

PERMIT

P #30477
A Repair

SEWAGE DISPOSAL SYSTEM

MARYLAND STATE DEPARTMENT OF HEALTH

HOWARD COUNTY

ELLICOTT CITY

INDEXED

DISTRICT 4th

DATE 1/11/80

Herman Sirk IS PERMITTED TO INSTALL ALTER

ADDRESS 2555 Jennings Chapel Road, Woodbine, Md. 21797 PHONE 489-4724

SUBDIVISION ROAD Box 2320 Route 97 LOT

PROPERTY OWNER Norman Smith

ADDRESS Box 2320 Route 97, Cooksville, Md.

SPECIFICATIONS

- SEPTIC TANK CAPACITY _____ GALLONS
- DRAIN FIELD _____ DEPTH _____ FEET, BOTTOM AREA _____ SQ. FT.
- DEEP TRENCH _____ DEPTH _____ FEET, BOTTOM AREA _____ SQ. FT.
- SEEPAGE PITS _____ ABSORBENT SIDE-WALL AREA _____ SQ. FT.
- INLET PIPE _____ FT. BELOW ORIGINAL GRADE, MAXIMUM DEPTH _____ FT. BELOW ORIGINAL GRADE
- EFFECTIVE DEPTH AT _____ FT. BELOW ORIGINAL GRADE.
- LOCATE DISPOSAL AREA _____ FT. FROM _____ LOT LINE AND _____ FT. FROM _____ LOT LINE AS SEEN WHEN FACING LOT FROM

REPAIR - Install 1000 gallon sealed tank for kitchen wastewater disposal. PLACE TANK

AT LEAST 50 FT FROM WELL PREFERABLY 75 FT,
AT LEAST 10 FT FROM THE LOT LINE

HAVE ALARM SYSTEM ON TANK & MANHOLE

PLANS APPROVED BY Donald W. Monaghan DATE 1/10/80


- COVER NO WORK UNTIL INSPECTED AND APPROVED.
- NEITHER THE HOWARD COUNTY COUNCIL NOR THE HEALTH DEPARTMENT IS RESPONSIBLE FOR THE SUCCESSFUL OPERATION OF ANY SYSTEM.
- NOTE: IF TRENCH IS USED CALL FOR INSPECTION BEFORE PLACING GRAVEL IN TRENCH.
- NOTE: NO DRY WELL SHALL EXCEED 15 FOOT IN DIAMETER.
- NOTE: ALL PIPE FROM HOUSE TO DISPOSAL AREA MUST BE CAST IRON.
- PERMIT VOID AFTER THREE YEARS.
- NOTE: INSTALL STAND PIPE ON SEPTIC TANK AND DRY WELL. STAND PIPES MUST BE 6 INCHES IN DIAMETER. CAST IRON, CONCRETE OR TERRA COTTA ACCEPTED.

BLDG. PERMIT SIGNED AND RETURNED 1/16/80
Serial No. 42275

P 30477

*INSTALLER IS RESPONSIBLE FOR OBTAINING FINAL APPROVAL ON THIS PERMIT.

BLDG. PERMIT SIGNED AND RETURNED 9/17/83
Serial # 50429
2 car garage

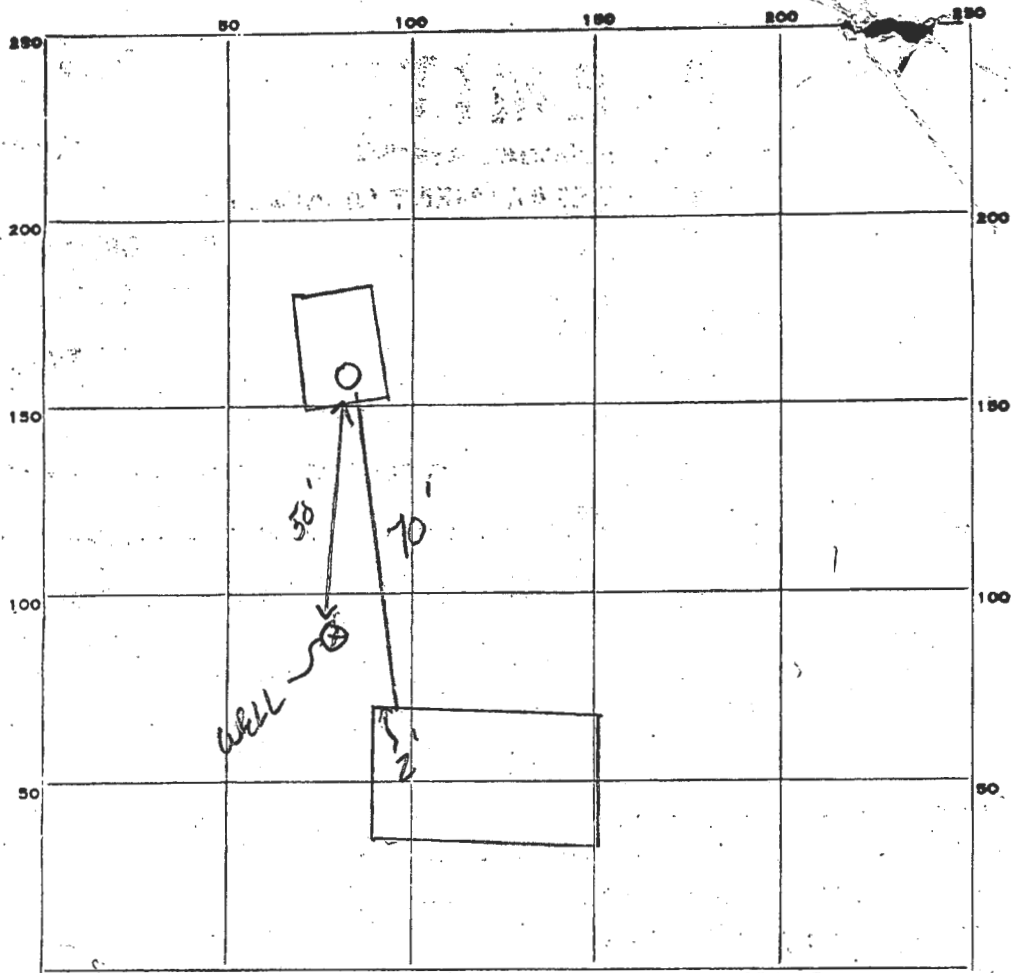

INDICATE NORTH. - NAME ADJOINING ROADWAY AS BASE LINE.

RT 97

PERMIT CARD:

SEPTIC TANK, LEVEL: CLEANOUTS:

DISTRIBUTION BOX, LEVEL: _____

TILE FIELD, DEPTH _____ FT. TRENCH WIDTH _____ FT.

GRAVEL DEPTH _____ IN. TOTAL LENGTH _____ FT.

NUMBER OF TRENCHES _____ TOTAL BOTTOM AREA _____

SEEPAGE PITS, INSIDE DIAMETER _____ FT. DEPTH BELOW INLET _____ FT.

ABSORBENT AREA _____ SQ. FT.

REMARKS 7/25/80 2:00PM - NOTHING DONE NO ONE AT SITE RH
 7/25/80 - 3:30PM TALKED TO MRS SMITH RE 7-30-80 OK TO COVER
 all work, NEED AN OVER FLOW ALARM BEFORE FINAL APPROVAL
 JS+SR 9/8/80 ^{SAW} ELECTRIC WIRES LEADING FROM SEPTIC TANK TO HOUSE; SAW
 LIGHT INDICATOR INSIDE BACK DOOR ON RIGHT WALL.

C.B.S.

DATE SYSTEM APPROVED 9/8/80 AS PER ABOVE INSPECTOR C.B. *Trasker*

APPLICATION

SEWAGE DISPOSAL TESTING

A 30447

STATE OF MARYLAND - DEPARTMENT OF HEALTH AND MENTAL HYGIENE

P _____

HOWARD COUNTY HEALTH DEPARTMENT
ENVIRONMENTAL HEALTH SERVICES
P.O. BOX 476 ELLICOTT, MARYLAND 21043
TELEPHONE: 992-2330

DISTRICT 4th

DATE 1/2/80

TO: THE COUNTY HEALTH OFFICER
ELLICOTT CITY, MARYLAND

I, HEREBY, APPLY FOR THE NECESSARY TEST IN ORDER TO CONSTRUCT (OR RECONSTRUCT) A SEWAGE DISPOSAL SYSTEM.

PROPERTY OWNER Norman Smith

ADDRESS Box 2320 Route 97, Cooksville, Md. PHONE 876-6671

PROPERTY LOCATION _____

SUBDIVISION _____ LOT NO. _____

ROAD AND DESCRIPTION Route 97 - Rt. 70 to Exit 74-South on Rt. 97 1 1/2 miles on right hand side.

1st house on right past Millers Mill Road

SIZE OF LOT 93 hundredths of an acre TYPE BLDG. existing house - 4 bedrooms

THE SYSTEM INSTALLED UNDER THIS APPLICATION IS ACCEPTABLE ONLY UNTIL PUBLIC FACILITIES BECOME AVAILABLE.

I FULLY UNDERSTAND THE FEE CONNECTED WITH THE FILING OF THIS PERC TEST APPLICATION IS NON-REFUNDABLE UNDER

ANY CIRCUMSTANCES.

SIGNATURE OF APPLICANT _____

APPROVED BY _____ FOR _____ DATE _____



REJECTED BY Don [initials] FOR any system DATE 1-10-80

HOLD PENDING FURTHER TESTS _____ DATE _____

REASONS FOR REJECTION OR HOLDING _____

THIS IS NOT A PERMIT

SOIL PROFILE

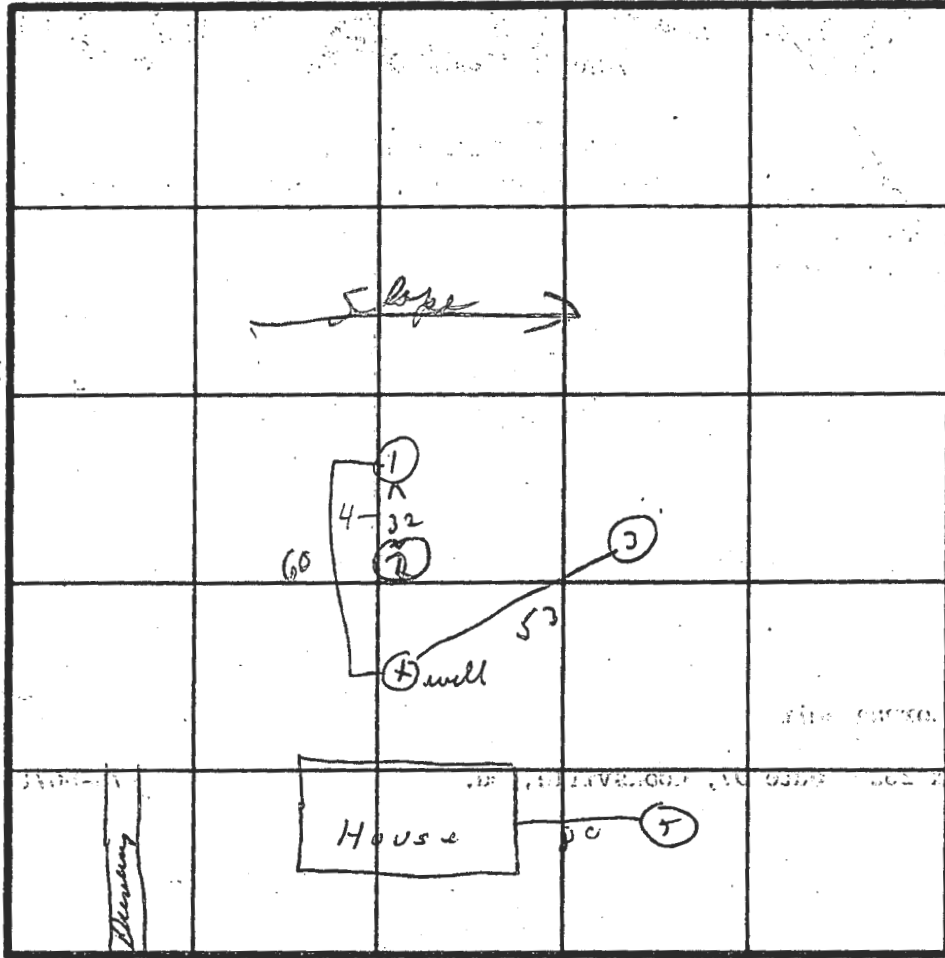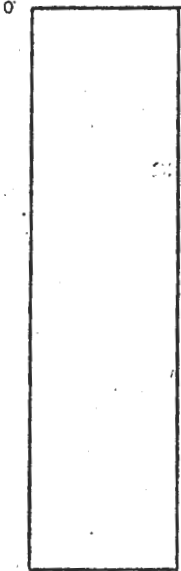

INDICATE NORTH, NAME ADJOINING ROADWAY AS BASE LINE

Route 97

DATE	TEST NO.	DEPTH	PRE-WET		TEST AT DROP		TIME
			START	STOP	START	STOP	
1/10/80	1	12 ft	all clay	-	water at 9 ft		
	2	10 ft	mostly clay		water at 10 ft		water breaking in at 7 ft.
	3	9 ft	water				
	2A	4 ft	9 22	9 37	9 37	10 15	36 min of air
	1A	4 ft	9 40	10 00	10 00		about 1/2" drop out 10 25
	4	1 1/2	9 46	10 15	1" pore starts		
	5	4 ft	water		breaking in at 6 ft		

REMARKS _____

TYPE OF SOIL Clay

TESTED BY DW M. ALSO PRESENT W. Sisk

Freemon, Robert

From: Freemon, Robert
Sent: Wednesday, December 20, 2017 11:19 AM
To: 'bill@ruppertcompanies.com'
Cc: 'Steven Krieg -MDE-'
Subject: 2320 Route 97
Attachments: P30477_BOX_2320_ROUTE_97.pdf

Hi Bill,
On Friday (12/15) Steven Krieg from MDE performed a site visit to check out the layout of the property and surrounding areas. His site visit indicated there may be some options available for evaluating and designing an Innovative septic system. Please contact Steven Krieg for further information regarding this matter.

Robert "Spencer" Freemon
Howard County Health Department
8930 Stanford Blvd. Columbia, MD 21045
Bureau of Environmental Health
Well and Septic Program
Phone: 410-313-6357
Email: rfreemon@howardcountymd.gov
Website: <https://www.howardcountymd.gov/Departments/Health/Environmental-Health/Well-and-Septic>