

C 1	00844	SEQUENCE NO. (OEP USE ONLY)	STATE OF MARYLAND WELL COMPLETION REPORT FILL IN THIS FORM COMPLETELY PLEASE PRINT OR TYPE		THIS REPORT MUST BE SUBMITTED WITHIN 45 DAYS AFTER WELL IS COMPLETED.	
1 2 3 6 (THIS NUMBER IS TO BE PUNCHED IN COLS. 3-6 ON ALL CARDS)				COUNTY NUMBER A-36334		
DATE Received		DATE WELL COMPLETED		PERMIT NO. FROM "PERMIT TO DRILL WELL"		
8 13		15 20		22 26 (TO NEAREST FOOT)		
28 29 30 31 32 33 34 35 36 37				HO-81-1306		

OWNER	last name	first name	TOWN	LOT
H50		F.S.	ELIOT	73
STREET OR RFD		SECTION		LOT
SUBDIVISION		SECTION		LOT
FAR SIDE				73

WELL LOG		
Not required for driven wells		
STATE THE KIND OF FORMATIONS PENETRATED, THEIR COLOR, DEPTH, THICKNESS AND IF WATER BEARING		
DESCRIPTION (Use additional sheets if needed)	FEET	
	FROM	TO
SAND	0	27
Gray Mott Rock	27	245

GROUTING RECORD	
WELL HAS BEEN GROUTED (Circle Appropriate Box)	
yes	no
Y	N
TYPE OF GROUTING MATERIAL	
CEMENT	BENTONITE CLAY
CM	BC
NO. OF BAGS	
NO. OF POUNDS	
GALLONS OF WATER	
DEPTH OF GROUT SEAL (to nearest foot)	
from ft. to ft.	
(enter 0 if from surface)	

CASING RECORD	
casing types insert appropriate code below	
STEEL	CONCRETE
PL	OTHER
MAIN CASING TYPE	
Nominal diameter top (main) casing (nearest inch)	
Total depth of main casing (nearest foot)	
OTHER CASING (if used)	
diameter inch	
depth (feet) from to	

SCREEN RECORD		
screen type or open hole		
insert appropriate code below		
STEEL	BRASS	OPEN HOLE
PL	BRONZE	OT
PLASTIC		OTHER

C 2	
DEPTH (nearest ft.)	
EACH SCREEN	
SLOT SIZE 1 2 3	
DIAMETER OF SCREEN (NEAREST INCH)	
from to	

GRAVEL PACK	
IF WELL DRILLED WAS FLOWING WELL INSERT F IN BOX 68	

OEP USE ONLY (NOT TO BE FILLED IN BY DRILLER)		
T	(E.R.O.S.)	WQ
70	72	74 75 76
TELESCOPE CASING	LOG INDICATOR	OTHER DATA

C 3		
PUMPING TEST		
HOURS PUMPED (nearest hour)		
PUMPING RATE (gal. per min. to nearest gal.)		
METHOD USED TO MEASURE PUMPING RATE		
WATER LEVEL (distance from land surface)		
BEFORE PUMPING		
WHEN PUMPING		
TYPE OF PUMP USED (for test)		
A air	P piston	T turbine
C centrifugal	R rotary	O other (describe below)
J jet	S submersible	

PUMP INSTALLED	
DRILLER WILL INSTALL PUMP YES NO	
IF DRILLER INSTALLS PUMP, THIS SECTION MUST BE COMPLETED FOR ALL WELLS EXCEPT HOME USE	
TYPE OF PUMP INSTALLED	
PLACE (A,C,J,P,R,S,T,O) IN BOX - SEE ABOVE:	
CAPACITY: GALLONS PER MINUTE (to nearest gallon)	
PUMP HORSE POWER	
PUMP COLUMN LENGTH (nearest ft.)	
CASING HEIGHT (circle appropriate box and enter casing height)	
LAND SURFACE (nearest foot)	

LOCATION OF WELL ON LOT	
SHOW PERMANENT STRUCTURE SUCH AS BUILDING, SEPTIC TANKS, AND/OR LANDMARKS AND INDICATE NOT LESS THAN TWO DISTANCES (MEASUREMENTS TO WELL)	

CIRCLE APPROPRIATE LETTER	
A WELL WAS ABANDONED AND SEALED WHEN THIS WELL WAS COMPLETED	
E ELECTRIC LOG OBTAINED	
P TEST WELL CONVERTED TO PRODUCTION WELL	
I HEREBY CERTIFY THAT THIS WELL HAS BEEN CONSTRUCTED IN ACCORDANCE WITH COMAR 10.17.13 "WELL CONSTRUCTION" AND IN CONFORMANCE WITH ALL CONDITIONS STATED IN THE ABOVE CAPTIONED PERMIT, AND THAT THE INFORMATION PRESENTED HEREIN IS ACCURATE AND COMPLETE TO THE BEST OF MY KNOWLEDGE.	
DRILLERS IDENT. NO.	
DRILLERS SIGNATURE	
SITE SUPERVISOR (sign. of driller or journeyman responsible for sitework if different from permittee)	

B 1 3963 SEQUENCE NO.
(OEP USE ONLY)STATE OF MARYLAND
PERMIT TO DRILL WELL

OEP PERMIT NUMBER

110-81-1305

please print or type

fill in this form completely

Date Received

01/08/86

OWNER INFORMATION

454 F. S.

4902 FPN MILLS RD.

COLUMBIA MD 21044

DRILLER INFORMATION

Joseph L. Mayne 238

Joseph L. Mayne Well Drilling

5512 Ridge Rd. Mt. Airy, Md. 20781

Signature Date 1/7/86

B 2 WELL INFORMATION

APPROX. PUMPING RATE (GAL. PER MIN.) 3

AVERAGE DAILY QUANTITY NEEDED (GAL. PER DAY) 509

USE FOR WATER (CIRCLE APPROPRIATE BOX)

- ☒ HOME (SINGLE OR DOUBLE HOUSEHOLD UNIT ONLY)
- ☐ FARMING (LIVESTOCK WATERING & AGRICULTURAL IRRIGATION)
- ☐ INDUSTRIAL, COMMERCIAL, STATE AND FEDERAL GOV. OTHER (REQUIRES APPROPRIATION PERMIT)
- ☐ PUBLIC OR PRIVATE WATER COMPANY (REQUIRES APPROPRIATION PERMIT AND STATE HEALTH DEPARTMENT APPROVAL)
- ☐ TEST, OBSERVATION, MONITORING (MAY REQUIRE APPROPRIATION PERMIT)

APPROXIMATE DEPTH OF WELL 260 FEET

APPROXIMATE DIAMETER OF WELL 6 INCH

METHOD OF DRILLING (circle one)

☒ BORED (or Augered) ☐ JETTED ☐ Jetted & DRIVEN

☒ AIR-ROTARY ☐ AIR-PERCussion ☐ ROTARY (Hydraulic Rotary)

☐ CABLE ☐ REVERSE-ROTARY ☐ DRIVE-POINT

REPLACEMENT OR DEEPEMED WELLS
(CIRCLE APPROPRIATE BOX)

- ☒ THIS WELL WILL NOT REPLACE AN EXISTING WELL
- ☐ THIS WELL WILL REPLACE A WELL THAT WILL BE ABANDONED AND SEALED
- ☐ THIS WELL WILL REPLACE A WELL THAT WILL BE USED AS A STANDBY
- ☐ THIS WELL WILL DEEPEMED AN EXISTING WELL
- PERMIT NUMBER OF WELL TO BE REPLACED OR DEEPEMED (IF AVAILABLE) 41

Not to be filled in by driller (OEP USE ONLY)

APPROP. PERMIT NUMBER 54 GAP 63

FORCE 100 WRITE INITIALS IN BOX PERMIT NO. 110-81-1305

SPECIAL CONDITIONS

B 3

LOCATION OF WELL

12 HOWARD 8 COUNTY 21

FAR SIDE 23 SUBDIVISION 42


SECTION 44 46 LOT 73 48 50

EL ZOUAK 52 NEAREST TOWN 71

MILES FROM TOWN (enter 0 if in town) 1 3/4 MI 73 76 77 78


B 4

DIRECTION OF WELL FROM TOWN (CIRCLE BOX)

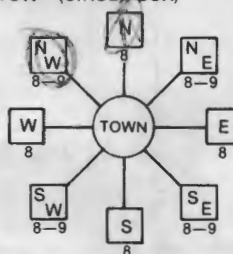

Spring Haven Ct. 11 NEAR WHAT ROAD 30

ON WHICH SIDE OF ROAD (CIRCLE APPROPRIATE BOX)

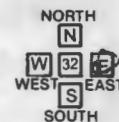

34 110 37 DISTANCE FROM ROAD

ENTER FT or MI 38 39

NOT TO BE FILLED IN BY DRILLER
HEALTH DEPARTMENT APPROVAL

HOWARD A-36334

COUNTY NAME COUNTY NO. OEP STATE HEALTH SIGNATURE INSERT S 41

DATE ISSUED 01/13/86 B. Nijon 07/13/86

NORTH GRID 516000 EAST GRID 0824000

SHOW MAJOR FEATURES OF BOX & LOCATE WELL WITH AN X

SOURCES OF DRILLING WATER


- WELL
-
-

WRITE THE BOX NUMBER FROM THE MAP HERE


E 824 N 516

5/13/08 Post
Treatment Radium
Sample Collected
at Kitchen Sink

DRAW A SKETCH BELOW SHOWING LOCATION OF WELL IN RELATION TO NEARBY TOWNS AND ROADS AND GIVE DISTANCE FROM WELL TO NEAREST ROAD JUNCTION

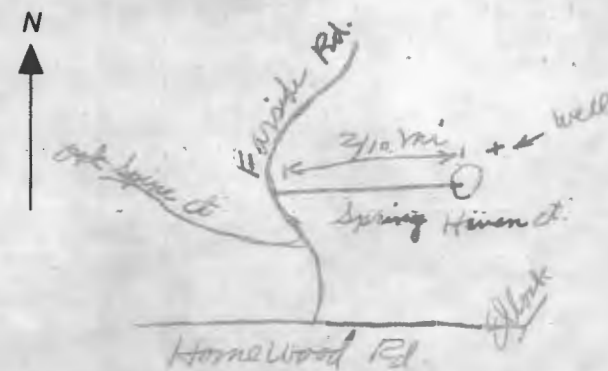

NOT @ SCALE.

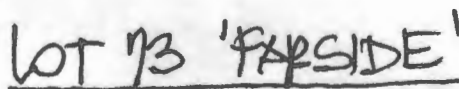

OWNER: MR. & MRS. S.F. HSU
4922 TEN MILLS RD.
COLUMBIA, MD. 21044
730.9074.

Review OK'd 2/6/86 (BA)

Well Permit No. HO - 811305
Location of property (road) SPRING HAVEN CT.
Subdivision FAR SIDE Lot 73 Block _____ Plat _____ Sec. _____
Well Driller JOSEPH MAYNE Owner HSU, F.S.

Depth of well 245
Distance of measuring point (M.P.) above ground 1
Static water level (S.W.L.) below M.P. 28

Time pump started 10:45 Pumping rate 10
Total time 30 min to reach pumping water level 22 ft. below M.P.

[illegible]

8:10 AM - 3 hrs.
9:30 AM - Grout
Review
Pump
very
OK
OK 10
Bn

FIELD DATA SHEET
HOWARD COUNTY WELL YIELD TEST

Well Permit No. HO - 81-1306
Location of property (road) Spring Haven Court
Subdivision Fairside Lot 13 Block _____ Plat _____ Sec. _____
Well Driller Frank Thomas Owner F. L. Jones

Depth of well 245
Distance of measuring point (M.P.) above ground 1
Static water level (S.W.L.) below M.P. 28

∴ High rate pumping -- reservoir drawdown

Time pump started 10:45 Pumping rate 10
Total time 30 min to reach pumping water level 72 ft. below M.P.

11. Recovery pump test data - observations to be recorded every 15 minutes

[illegible]

**HOWARD COUNTY HEALTH DEPARTMENT
BUREAU OF ENVIRONMENTAL HEALTH
WATER AND SEWERAGE PROGRAM
TEL: (410)313-2640 FAX: (410)313-2648**

Information Form for the Installation of the Well Pump, Pitless Adapter, and Supply Piping

NOTE: The installer is responsible for requesting an inspection prior to 9 am on the day of the desired inspection. No work is to be covered until approved by the Health Department. All installations must comply with the National Standard Plumbing Code (NSPC, as amended locally) and COMAR 26.04.04 (MD Well Construction Regulations). Submission of a complete form is required prior to Use and Occupancy approval.

Company Name: WTC III Plumbing Telephone #: 410-489-4457
Address: 1820 Gillis Fille Rd.
Woodbine MD 21717

(Must circle one) Licensed Plumber Licensed Well Driller Licensed Well Pump Installer
License # and name of individual responsible for the field installation:

Name (Print): William T. Cumberland III License# 7979

*A licensed individual must perform the actual installation. Apprentices must be under the direct supervision of a licensed journeyman or master plumber, pump installer or well driller. Licenses may be subjected to field verification.

Name of Property Owner: Bernie Dancel Telephone #: _____
Subdivision: Fair Side Lot #: 73 Well Tag #: HO-81-1306
Site Address: 1143 Spring Haven Court
Ellicott City MD

Submersible Pump Data	Pitless Adapter	Well Cap and Electric Conduit
Make: <u>Myers</u>	Make: <u>Howard</u>	Two piece watertight cap: <u>yes</u>
Model #: _____	Model #: _____	Screened, vented well cap: <u>yes</u>
Pump Capacity <u>8</u> GPM	Depth <u>5 ft</u> (36" min)	Cap secured to casing: <u>yes</u>
Well Yield: <u>10</u> GPM	NSF approved: <u>yes</u>	Conduit min 18" B.G.: <u>yes</u>
Depth of well encountered at time of pump installation: _____ (feet)		Conduit secured to well cap: <u>yes</u>

If pump capacity exceeds well yield, a low water cut off switch is required by NSPC 1990 Section 17.8.4
Torque arrestors or Cable guards are required - Must circle one
Safety rope, if used, attached to inside of well casing with eye bolt _____

Piping to house

Type: 1 in
PSI: 110 (160 psi min)
Depth of supply line: 5 ft (36" min)

House Connection

PVC sleeved to undisturbed soil at wall penetration: yes
Approximate length of sleeve: 6 ft
Sleeve caulked and sealed properly: yes

The water supply line is required to be at least ten feet from the septic tank, pump chamber, sewage piping, distribution box, drainfields, and sewage reserve area. If this cannot be accomplished, contact this office for approval prior to installation.

Signature of company representative responsible for installation: William T. Cumberland III

5-14-08
date

For Health Department Use Only - Not to be completed by Installer

Date Insp. Requested: _____ Date Insp. Approved: 5/13/08 BR
Inspection Data: Pitless adapter and water supply line at least 36" below grade _____
Two piece cap installed and attached to casing securely _____
Elec. conduit extends at least 18" below grade/attached to cap properly _____
Safety rope installed inside of well casing _____
Correct well tag attached properly and casing 8" above finished grade _____
Water supply line sleeved adequately at house connection _____
Adequate grout observed below pitless adapter _____