


SOIL PROFILE

0

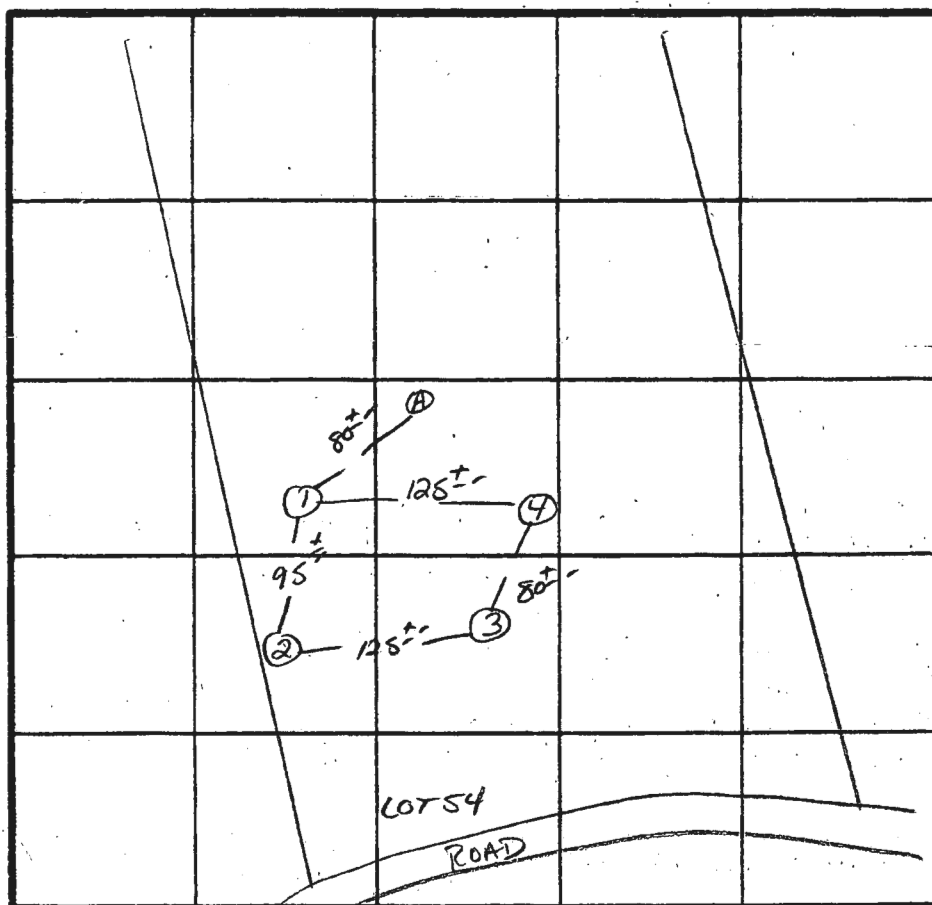

INDICATE NORTH - NAME ADJOINING ROADWAY AS BASE LINE.

X PERC  
17 MIN  
220 #/BR  
INLET 3.5'  
BOTTOM 6.0'

| DATE   | TEST NO. | DEPTH      | PRE-WET                               |      | TEST - 1" DROP |      | TIME   |
|--------|----------|------------|---------------------------------------|------|----------------|------|--------|
|        |          |            | START                                 | STOP | START          | STOP |        |
| 4/9/87 | 1S       | 5'         | 1:34                                  | 1:39 | 1:39           | 1:50 | 11 MIN |
|        | 1V       | 11'        | HARD BOTTOM / UNIFORM SOIL below 4.5' |      |                |      |        |
|        | 2S       | 4'         | 1:38                                  | 1:44 | 1:44           | 2:02 | 18 MIN |
|        | 2M       | 8'         | 1:41                                  | 1:44 | 1:44           | 1:52 | 8 MIN  |
|        | 2V       | 12'        | HARD BOTTOM / UNIFORM SOIL below 3.5' |      |                |      |        |
|        | 3V       | 9.5'       | HARD BOTTOM / UNIFORM SOIL below 4.5' |      |                |      |        |
|        | 4S       | 4'         | 1:55                                  | 2:05 | 2:05           | 2:25 | 20 MIN |
|        | 4V       | 8'         | HARD BOTTOM / UNIFORM SOIL below 3'   |      |                |      |        |
|        | A-       | ROCK AT 3' |                                       |      |                |      |        |
|        |          |            |                                       |      |                |      |        |
|        |          |            |                                       |      |                |      |        |
REMARKS HOLES DIFF THAN PLAT / SHALLOW SYST - ONLY

TYPE OF SOIL CHESTER LOAM


TESTED BY S. Abel ALSO PRESENT SKIP, Rocky, Bill

By copy of this plan the HEALTH Dept. accepts this modification to the recorded sewage disposal easement

FIELD LOCATION OF  
PROPOSED SEPTIC EASEMENT  
LOT 686  
BURLEIGH MANOR  
SECTION 2  
2ND ELECTION DISTRICT  
HOWARD COUNTY, MARYLAND

NOTE:

⊗ = Stakes set for proposed septic area from plan furnished by Greenfield Homes.

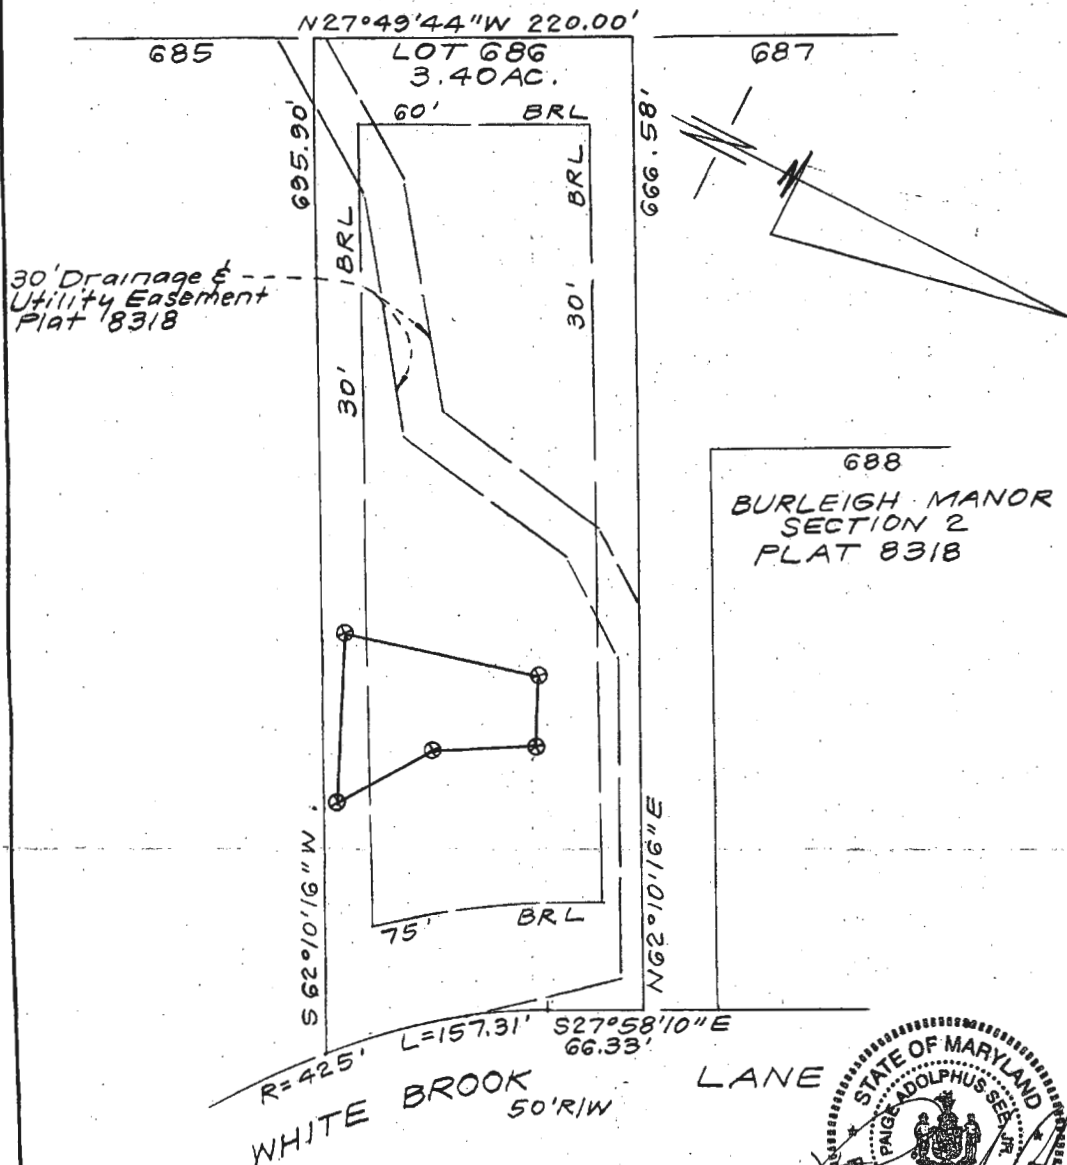

|                                                                                                                                                                           |                |               |              |
|---------------------------------------------------------------------------------------------------------------------------------------------------------------------------|----------------|---------------|--------------|
| <b>CLARK • FINEFROCK &amp; SACKETT, INC.</b><br>ENGINEERS • PLANNERS • SURVEYORS<br>7135 MINSTREL WAY COLUMBIA, MD. 21045<br>(410) 381-7500-DALTO. • (301) 821-8100-WASH. | DRAWN BY KWC   | SCALE 1"=100' | DATE 7-17-96 |
|                                                                                                                                                                           | CHECKED BY PAS | JOB NO.       | FILE NO.     |
|                                                                                                                                                                           | APPROVED BY    |               | 96-129-L     |