



**Building Permit Application**  
Howard County Maryland  
Department of Inspections, Licenses and Permits  
3430 Court House Drive  
Permits: 410-313-2455  
[www.howardcountymd.gov](http://www.howardcountymd.gov)

Date Received: 7/9/15

Permit No.: 719003580

Building Address: 614 Siding Court  
City: Schaumburg State: MD Zip Code: 21784  
Suite/Apt. #: \_\_\_\_\_ SDP/WP/BA #: \_\_\_\_\_  
Census Tract: \_\_\_\_\_ Subdivision: \_\_\_\_\_  
Section: \_\_\_\_\_ Area: \_\_\_\_\_ Lot: \_\_\_\_\_  
Tax Map: \_\_\_\_\_ Parcel: \_\_\_\_\_ Grid: \_\_\_\_\_  
Zoning: \_\_\_\_\_ Map Coordinates: \_\_\_\_\_ Lot Size: \_\_\_\_\_

Existing Use: Residential  
Proposed Use: Commercial  
Estimated Construction Cost: \$ 30,000  
Description of Work: Commercial building with 10,000 sq. ft. (10' x 17')

Occupant or Tenant: \_\_\_\_\_  
Was tenant space previously occupied? ☐ Yes ☒ No  
Contact Name: \_\_\_\_\_  
Address: \_\_\_\_\_  
City: \_\_\_\_\_ State: \_\_\_\_\_ Zip Code: \_\_\_\_\_  
Phone: \_\_\_\_\_ Fax: \_\_\_\_\_  
Email: \_\_\_\_\_

Property Owner's Name: Rachel L Stone, Inc.  
Address: 614 Siding Court  
City: Schaumburg State: MD Zip Code: 21784  
Phone: \_\_\_\_\_ Fax: \_\_\_\_\_  
Email: \_\_\_\_\_

**Applicant's Name & Mailing Address, (If other than stated herein)**  
Applicant's Name: \_\_\_\_\_  
Address: \_\_\_\_\_  
City: \_\_\_\_\_ State: \_\_\_\_\_ Zip Code: \_\_\_\_\_  
Phone: \_\_\_\_\_ Fax: \_\_\_\_\_  
Email: \_\_\_\_\_

Contractor Company: Bo Spivey Construction, Inc.  
Contact Person: Chris Spivey  
Address: 200 E. Main St.  
City: Frederick State: MD Zip Code: 21785  
License No.: 85772  
Phone: 410-313-0497 Fax: 410-313-8200  
Email: chris@spiveyco.com

Engineer/Architect Company: J.C. Architects  
Responsible Design Prof.: \_\_\_\_\_  
Address: \_\_\_\_\_  
City: \_\_\_\_\_ State: \_\_\_\_\_ Zip Code: \_\_\_\_\_  
Phone: 410-599-9007 Fax: \_\_\_\_\_  
Email: \_\_\_\_\_

Commercial Building Characteristics	Residential Building Characteristics
Height:	<input type="checkbox"/> SF Dwelling <input type="checkbox"/> SF Townhouse
No. of stories:	<b>Depth</b> <b>Width</b>
Gross area, sq. ft./floor:	1 <sup>st</sup> floor:
	2 <sup>nd</sup> floor:
Area of construction (sq. ft.):	Basement:
	<input type="checkbox"/> Finished Basement
Use group:	<input type="checkbox"/> Unfinished Basement
	<input type="checkbox"/> Crawl Space
<b>Construction type:</b>	<input type="checkbox"/> Slab on Grade
<input type="checkbox"/> Reinforced Concrete	No. of Bedrooms:
<input type="checkbox"/> Structural Steel	<b>Multi-family Dwelling</b>
<input type="checkbox"/> Masonry	No. of efficiency units:
<input type="checkbox"/> Wood Frame	No. of 1 BR units:
<input type="checkbox"/> State Certified Modular	No. of 2 BR units:
	No. of 3 BR units:
	Other Structure:
	Dimensions:
<input checked="" type="checkbox"/> <b>Roadside Tree Project Permit</b>	Footings:
<input type="checkbox"/> Yes <input checked="" type="checkbox"/> No	Roof:
<b>Roadside Tree Project Permit #</b>	<input type="checkbox"/> State Certified Modular
	<input type="checkbox"/> Manufactured Home

Utilities
<b>Water Supply</b>
<input type="checkbox"/> Public
<input type="checkbox"/> Private
<b>Sewage Disposal</b>
<input type="checkbox"/> Public
<input type="checkbox"/> Private
Electric: <input type="checkbox"/> Yes <input type="checkbox"/> No
Gas: <input type="checkbox"/> Yes <input type="checkbox"/> No
<b>Heating System</b>
<input type="checkbox"/> Electric <input type="checkbox"/> Oil
<input type="checkbox"/> Natural Gas <input type="checkbox"/> Propane Gas
<input type="checkbox"/> Other:
<b>Sprinkler System:</b>
<input type="checkbox"/> Yes <input type="checkbox"/> No
<b>Grading Permit Number:</b>
<b>Building Shell Permit Number:</b>

THE UNDERSIGNED HEREBY CERTIFIES AND AGREES AS FOLLOWS: (1) THAT HE/SHE IS AUTHORIZED TO MAKE THIS APPLICATION; (2) THAT THE INFORMATION IS CORRECT; (3) THAT HE/SHE WILL COMPLY WITH ALL REGULATIONS OF HOWARD-COUNTY WHICH ARE APPLICABLE THERETO; (4) THAT HE/SHE WILL PERFORM NO WORK ON THE ABOVE REFERENCED PROPERTY NOT SPECIFICALLY DESCRIBED IN THIS APPLICATION; (5) THAT HE/SHE GRANTS COUNTY OFFICIALS THE RIGHT TO ENTER ONTO THIS PROPERTY FOR THE PURPOSE OF INSPECTING THE WORK PERMITTED AND POSTING NOTICES.

Applicant's Signature \_\_\_\_\_

Print Name \_\_\_\_\_

Email Address \_\_\_\_\_

Date \_\_\_\_\_

Title/Company \_\_\_\_\_

Checks Payable to: DIRECTOR OF FINANCE OF HOWARD COUNTY

\*\*PLEASE WRITE NEATLY & LEGIBLY\*\*

-FOR OFFICE USE ONLY-

AGENCY	DATE	SIGNATURE OF APPROVAL
State Highways		
Building Officials		
PSZA ( Zoning )		
PSZA ( Engineering )		
Health	10/4/15	H. Oswald

Is Sediment Control approval required for issuance? ☐ Yes ☒ No  
☐ CONTINGENCY CONSTRUCTION START

DPZ SETBACK INFORMATION
Front:
Rear:
Side:
Side St.:
All minimum setbacks met? <input type="checkbox"/> Yes <input type="checkbox"/> No
Is Entrance Permit Required? <input type="checkbox"/> Yes <input type="checkbox"/> No
Historic District? <input type="checkbox"/> Yes <input type="checkbox"/> No
Lot Coverage for New Town Zone:
SDP/Red-line approval date:


Filing Fee	\$ 35
Permit Fee	\$
Tech Fee	\$
Excise Tax	\$
PSFS	\$
Guaranty Fund	\$
Add'l per Fee	\$
Total Fees	\$
Sub-Total Paid	\$
Balance Due	\$
Check	# 107155

Distribution of Copies: White: Building Officials Green: PSZA,Zoning

Yellow: PSZA,Engineering

Pink: Health

Gold: SHA

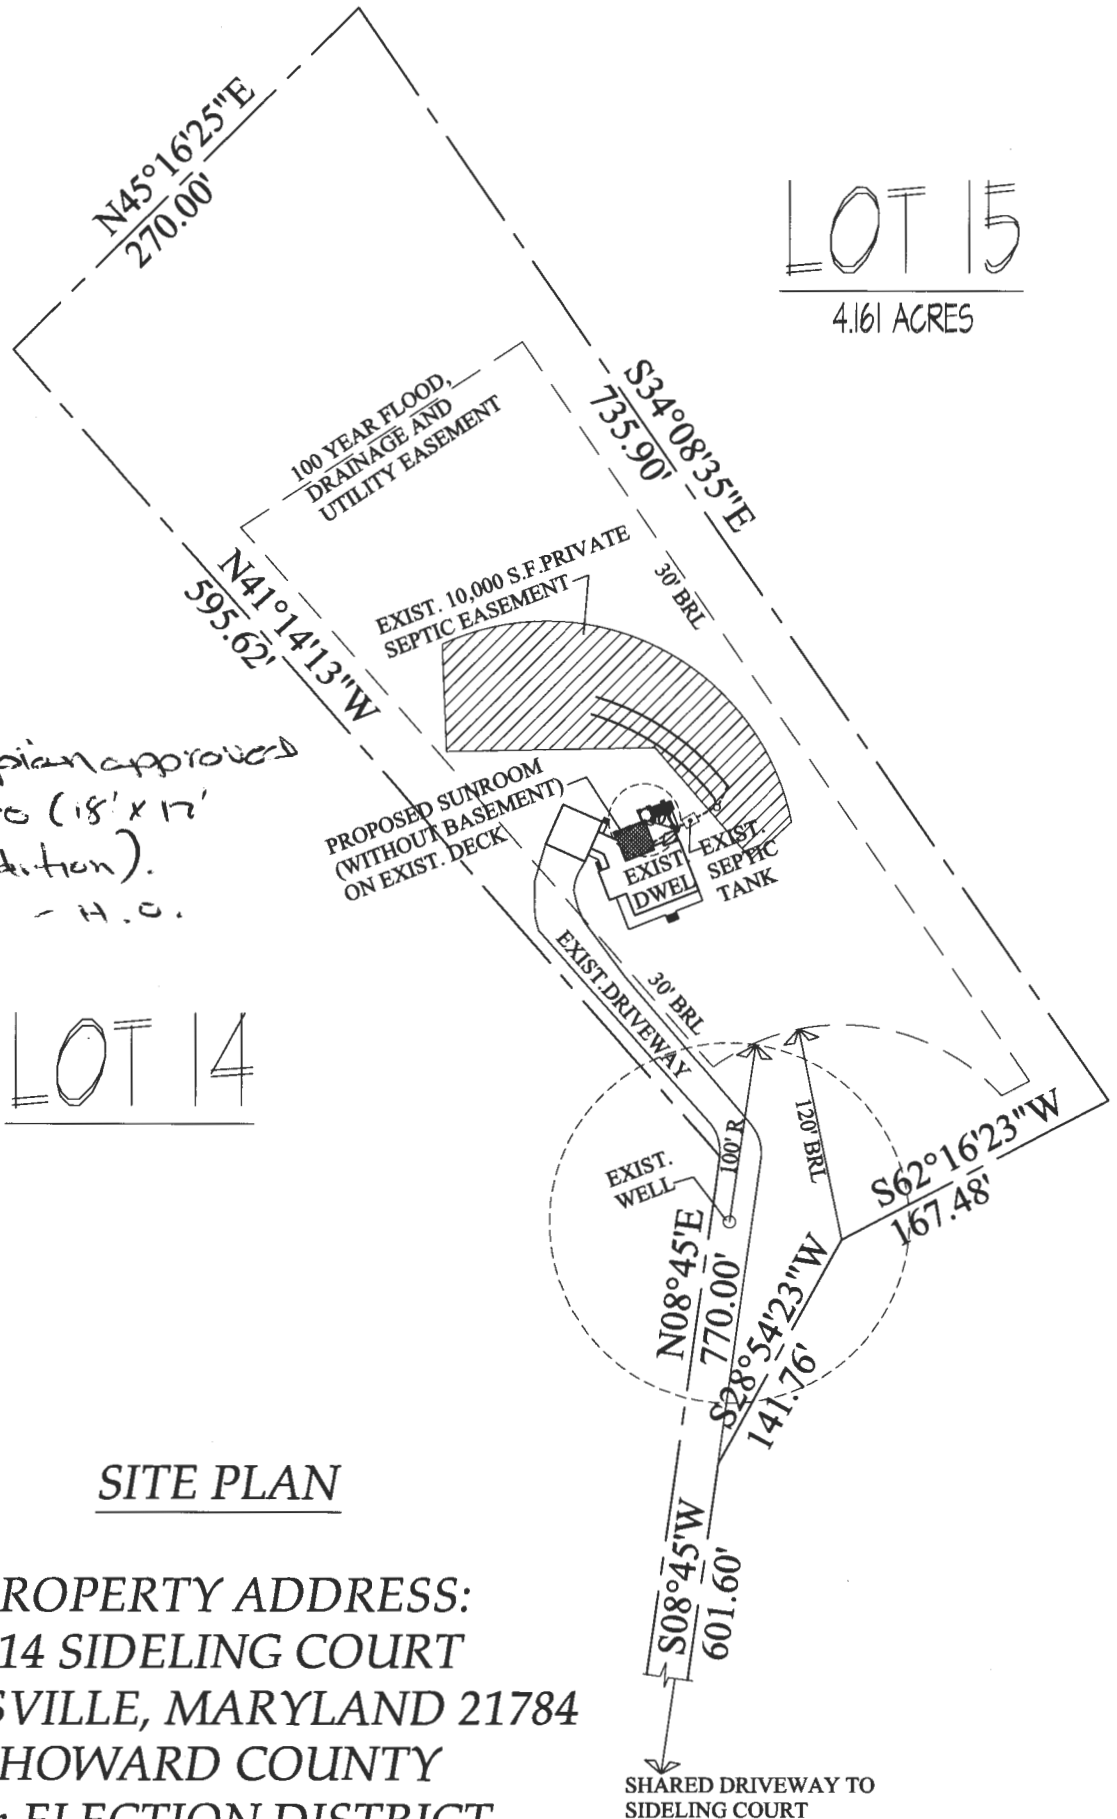

12/16/15 - Site plan approved  
for B15003880 (18' x 17'  
sunroom addition).  
- H.C.

### SITE PLAN

PROPERTY ADDRESS:  
614 SIDELING COURT  
SYKESVILLE, MARYLAND 21784  
HOWARD COUNTY  
4th ELECTION DISTRICT

SCALE: 1"=100' DATE: SEPTEMBER 21, 2015

## Oswald, Hank

---

**From:** Oswald, Hank  
**Sent:** Monday, September 21, 2015 11:58 AM  
**To:** 'CHRISBSQUARE@GMAIL.COM'  
**Subject:** Sunroom\_614 Sideling Court\_B15003880  
**Attachments:** A49164\_04-\_614\_SIDEILING\_COURT.pdf; W and S Setback Requirements.pdf; BP Response Letter\_FPs of Existing and proposed renovations plus site plan revision\_2015\_B15003880.pdf


CHRISTOPHER WILHELM:

Attach, please find the BP response letter for 614 Sideling Court.

Should you have any questions, please don't hesitate to ask.

Hank

Hank Oswald, L.E.H.S.  
Howard County Health Department  
Bureau of Environmental Health  
Well & Septic Program  
8930 Stanford Boulevard  
Columbia, MD 21045  
410.313.1786 (Office)  
410.313.2648 (Fax)

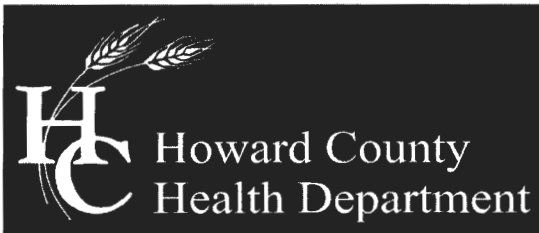

**Bureau of Environmental Health**

8930 Stanford Boulevard, Columbia, MD 21045

Main: 410-313-2640 | Fax: 410-313-2648

TDD 410-313-2323 | Toll Free 1-866-313-6300

[www.hchealth.org](http://www.hchealth.org)

Facebook: [www.facebook.com/hocohealth](https://www.facebook.com/hocohealth)

Twitter: HowardCoHealthDep

**Maura J. Rossman, M.D., Health Officer**

September 21, 2015

CHRISTOPHER S WILHELM  
B SQUARE CONSTRUCTION INC  
2420 ALEES DRIVE  
NEW WINDSOR, MD 21776-0000

*Sent via email to: **CHRISBSQUARE@GMAIL.COM***

**RE: B15003880**  
614 Sideling Court  
Sykesville, MD 21784

CHRISTOPHER S WILHELM:

This letter is in response to building permit **B15003880**. The application describes an 18.3 ft X 17 ft sunroom addition. Upon review the building permit and site plan, the submittal did not include a copy of the floor plans of the existing house plus proposed changes. The house floor plan (basement, first and second floor) may be hand drawn. Floor plans are needed to determine if the septic system is sized properly.

Additionally, the site plan must include any onsite well and all septic system components (tank, trench and reserve area) to ensure setback requirements are being met. Please refer to the "as-built" drawing of the septic system (attachment, pages 1 -3) for their locations and include them in the revised site plan drawing. Also, please find a copy of the setback requirements (attachment).

Building permit approval is being placed on hold until floor plans and revised site plan drawing have been forwarded to the Health Department. Should you have any questions, please don't hesitate to ask.


Respectfully,

*Hank Oswald*

Hank Oswald, L.E.H.S  
Bureau of Environmental Health  
Well & Septic Program



# MORRIS ADDITION

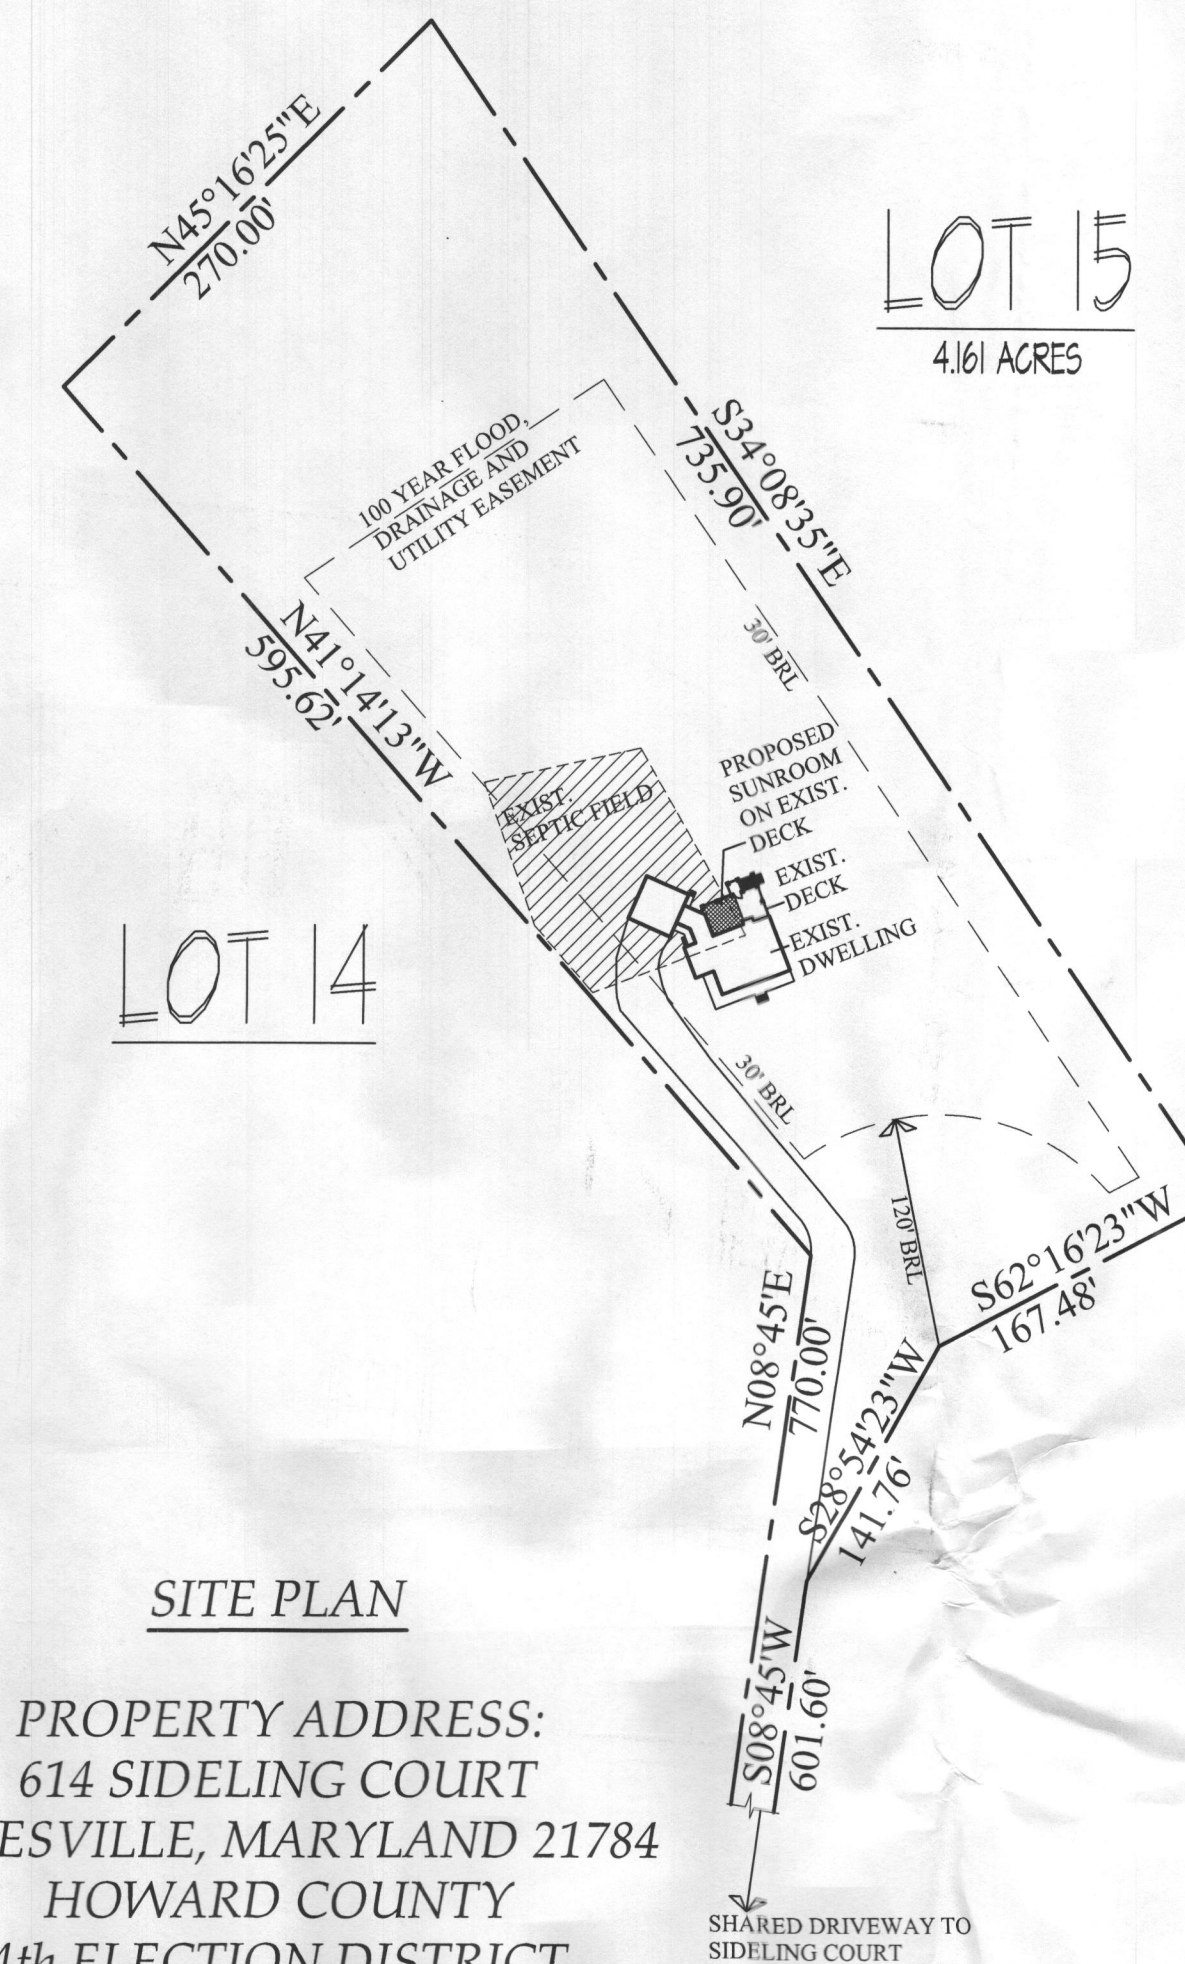

PROPERTY ADDRESS:  
614 SIDELING COURT  
SYKESVILLE, MARYLAND 21784  
HOWARD COUNTY  
4th ELECTION DISTRICT  
SCALE: 1"=100' DATE: SEPTEMBER 1, 2015

USE	LIVE LOAD	DEAD LOAD	TOTAL
ROOF TRUSSES	30	10 (top & bottom)	50
RAFTERS	30	10	40
ATTICS WITHOUT STORAGE <sup>b</sup>	10	5	15
ATTICS WITH LIMITED STORAGE <sup>bg</sup>	20	10	30
HABITABLE ATTICS AND ATTICS SERVED WITH FIXED STAIRS	30	10	40
BALCONIES (EXTERIOR) AND DECKS <sup>d</sup>	40	10	50
FIRE ESCAPES	40	10	50
GUARDRAILS AND HANDRAILS <sup>d</sup>	200 <sup>h</sup>		
GUARDRAIL IN-FILL COMPONENTS <sup>f</sup>	50 <sup>h</sup>		
PASSENGER VEHICLE GARAGES <sup>a</sup>	50	50	100
ROOMS OTHER THAN SLEEPING ROOMS	40 <sup>a</sup>	10	50
SLEEPING ROOMS	30	10	40
STAIRS	40 <sup>c</sup>	20	60

ASSUMED SAIL BEARING CAPACITY: 2000 PSF

- a. Elevated garage floors shall be capable of supporting a 2,000-pound load applied over a 20-square-inch area.
- b. Uninhabitable attics without storage are those where the maximum clear height between joists and rafters is less than 42 inches, or where there are not two or more adjacent trusses with web configurations capable of accommodating an assumed rectangle 42 inches high by 24 inches in width, or greater, within the plane of the trusses. This live load need not be assumed to act concurrently with any other live load requirements.
- c. Individual stair treads shall be designed for the uniformly distributed live load or a 300-pound concentrated load acting over an area of 4 square inches, whichever produces the greater stresses.
- d. A single concentrated load applied in any direction at any point along the top.
- e. See Section R502.2.2 for decks attached to exterior walls.
- f. Guard Infill Components (all those except the handrail) balusters and panel fillers shall be designed to withstand a horizontally applied normal load of 50 pounds on an area equal to 1 square foot. This load need not be assumed to act concurrently with any other live load requirement.
- g. Uninhabitable attics with limited storage are those where the maximum clear height between joists and rafters is 42 inches or greater, or where
- there are two or more adjacent trusses with web configurations capable of accommodating an assumed rectangle 42 inches in height by 24 inches in width, or greater, within the plane of the trusses.
- The live load need only be applied to those portions of the joists or truss bottom chords where all of the following conditions are met:
  1. The attic area is accessible from an opening not less than 20 inches in width by 30 inches in length that is located where the clear height in the attic is a minimum of 30 inches.
  2. The slopes of the joists or truss bottom chords are no greater than 2 inches vertical to 12 units horizontal.
  3. Required insulation depth is less than the joist or truss bottom chord member depth.
- The remaining portions of the joists or truss bottom chords shall be designed for a uniformly distributed concurrent live load of not less than 10 lb/ft<sup>2</sup>.
- h. Glazing used in handrail assemblies and guards shall be designed with a safety factor of 4. The safety factor shall be applied to each of the concentrated loads applied to the top of the rail, and to the load on the infill components. These loads shall be determined independent of one another, and loads are assumed not to occur with any other live load.

### ADOPTED CODES

- International Building Code, 2015 Edition
- International Residential Code for One and Two Family Dwellings, 2015 Edition
- International Mechanical Code, 2015 Edition
- International Energy Conservation Code, 2015 Edition
- The Life Safety Code, 2015 Edition
- 2011 National Electrical Code with Local Amendments (NFPA 70)
- 2009 National Standard Plumbing Code Illustrated
- 2009 National Fuel Gas Code (NFPA 54)
- International Property Maintenance Code 2006

ENERGY COMPLIANCE: PRESCRIPTIVE APPROACH SEE SHEET A-4A

PERMIT/PRICING SET  
SEPTEMBER 1, 2015

TABLE R301.2(1) CLIMATIC AND GEOGRAPHIC DESIGN CRITERIA


GROUND SNOW LOAD	WIND DESIGN		SEISMIC DESIGN CATEGORY	SUBJECT TO DAMAMGE FROM				WATER DESIGN TEMP	ICE BARRIER UNDERLAYMENT REQUIRED	FLOOD HAZARD	AIR FREEZING INDEX	MEAN ANNUAL TEMP
	Speed (mph)	Topographic effects		Weathering	Frost line depth	Termites	Decay					
25	115	NO	A	Severe	30"	Moderate Heavy	Slight Moderate	20 ° F	Yes	see flood maps	1500	55° F

## DRAWING INDEX

TITLE	SHEET	TITLE	SHEET
COVER SHEET	CS		
CONSTRUCTION NOTES	CN		
RIGHT AND LEFT REAR ELEVATIONS	EX-1		
EXISTING FOUNDATION PLAN	EX-2		
EXISTING FIRST FLOOR PLAN	EX-3		
EXISTING SECOND FLOOR PLAN/SECTION	EX-4		
RIGHT AND REAR ELEVATIONS	A-1		
FIRST FLOOR PLAN AND SECTION A	A-2		
SECOND FLOOR PLAN	A-3		
APA NARROW WALL DETAILS	A-4A		
WALL BRACING PLANS AND CHARTS	A-4B		
WALL BRACING FIRST FLOOR PLAN	A-4C		

## SQ. FOOTAGE

BASEMENT	0
FIRST FLOOR	298
SECOND FLOOR	0
<hr/>	
TOTAL	298

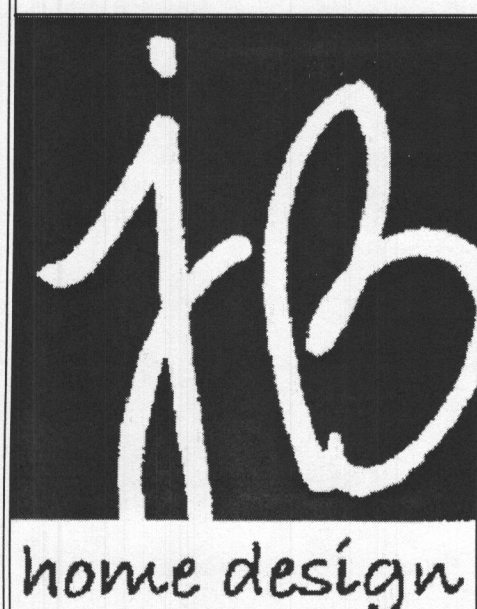

**JB HOME DESIGN, LLC**

9416 CONCORD COURT  
BALTIMORE, MARYLAND 21234  
OFFICE (410) 599-9587  
FAX (410) 663-4069  
EMAIL: JON@JBHOMEDSIGN.COM



GENERAL

61. ALL NOTES APPLY TO EACH AND EVERY SUBCONTRACTOR. READ AND REVIEW EACH NOTE CAREFULLY FOR ITS APPLICABILITY TO THE WORK.

62. BUILDING CODE REFERENCES HEREUNDER AND ON THE PLANS REFER TO THE 2015 INTERNATIONAL RESIDENTIAL CODE (IRC) AND OTHER INTERNATIONAL CODES, AS APPLICABLE, UNLESS OTHERWISE NOTED (N10.)

63. CONTRACTOR WILL PROVIDE THE GENERAL BUILDING PERMIT ONLY. EACH SUBCONTRACTOR SHALL SECURE ALL OTHER REQUIRED PERMITS PRIOR TO COMMENCING ANY WORK AND SHALL BE SOLELY RESPONSIBLE FOR OBTAINING AND PASSING, WITHOUT DELAY TO CONTRACTOR, ALL INSPECTIONS AND APPROVALS REQUIRED BY LAW OR ANY STORM WATER OR DUST CONTROL REQUIREMENTS AND ANY INSPECTIONS AND APPROVALS REQUIRED BY CONTRACTOR OR ANY AGENT OF CONTRACTOR.

64. PERFORM ALL WORK IN COMPLIANCE WITH APPLICABLE LAWS, FREE FROM NONCONFORMANCE, IN A FIRST-CLASS, GOOD, AND WORKMANLIKE MANNER ACCORDING TO THE HIGHEST STANDARDS OF SUBCONTRACTORS' TRADE AND IN STRICT CONFORMANCE WITH SUBCONTRACTOR'S OBLIGATIONS UNDER ITS AGREEMENT.

65. THE CONTRACT DOCUMENTS OUTLINE SALIENT MINIMUM REQUIREMENTS BUT DO NOT SPECIFY ALL LABOR, MATERIAL, TOOLS EQUIPMENT, UTILITIES, SERVICES AND OTHER ITEMS NECESSARY TO COMPLETE AND FULL EXECUTE THE WORK.

66. WORK NOT SPECIFICALLY COVERED IN THE CONTRACT DOCUMENTS, BUT WHICH IS REASONABLY INFERRABLE FROM OR CUSTOMARILY PERFORMED BY ANY SUBCONTRACTOR OF THE SAME OR SIMILAR TRADE PERFORMING WORK OF THE TYPE SHOWN OR INCLUDED IN THE CONTRACT DOCUMENTS, INCLUDING DETAILS OR ITEMS OF THE WORK WHICH ARE NOT SPECIFICALLY COVERED ON OR IN THE CONTRACT DOCUMENTS, SHALL BE FURNISHED AND INSTALLED AT NO EXTRA COST.

67. ALL MATERIAL SUPPLIED SHALL BE NEW, THE BEST OF ITS KIND AND FROM THE SAME MANUFACTURER (AND SAME MANUFACTURING RUN WHERE APPLICABLE). ALL MATERIALS SHALL BE SUITABLE FOR THE USES INTENDED AND CONDITIONS ANTICIPATED. FURNISH, HANDLE AND INSTALL MATERIAL IN ACCORDANCE WITH THE TERMS OF ITS LISTING OR APPROVAL, THE MANUFACTURER'S WRITTEN INSTALLATION INSTRUCTIONS, GUIDELINES AND RECOMMENDATIONS AND APPLICABLE LAWS AND STANDARDS.

68. SUBCONTRACTOR SHALL PROTECT THE WORK, PROPERTY AND MATERIAL OF OTHER PERSONS BEFORE PROCEEDING WITH ANY WORK AND AT ALL TIMES DURING THE PERFORMANCE OF ITS WORK.

69. DRAWN DIMENSIONS TAKE PRECEDENCE OVER DRAWN INFORMATION - DO NOT SCALE DIMENSIONS. ALL DIMENSIONS ARE SHOWN TO FACE OF STUDS. ALL EXTERIOR STUD WALLS ARE 5 1/2" WIDE, ALL INTERIOR STUD WALLS ARE 3 1/2" WIDE (N10).

70. SUBCONTRACTOR SHALL VERIFY ALL DIMENSIONS BEFORE COMMENCING ANY WORK. BRING ALL ERRORS OR OMISSIONS TO THE IMMEDIATE ATTENTION OF CONTRACTOR BEFORE COMMENCING ANY WORK. SUBCONTRACTOR SHALL BEAR ALL COSTS AND EXPENSES FOR CORRECTING WORK COMMENCED WITHOUT VERIFYING DIMENSIONS OR WITHOUT HAVING A RESOLUTION TO ANY ERROR OR OMISSION.

71. REMOVE ALL WASTE MATERIAL AND TRASH DAILY. CLEAN THE WORK AREA DAILY. IMMEDIATELY AFTER COMPLETING WORK ON ANY HOME, REMOVE ALL TOOLS, EQUIPMENT AND EXCESS OR NONCONFORMING MATERIAL AND SHALL LEAVE THE HOME IN A BROOM CLEAN, NEAT, SAFE, SECURE AND SANITARY CONDITION.

SAFETY

51. EVERY SUBCONTRACTOR AND EACH OF ITS AGENTS SHALL COMPLY WITH ALL HEALTH, SAFETY AND ENVIRONMENTAL LAWS, RULES, REGULATIONS AND REQUIREMENTS. EACH SUBCONTRACTOR UNDERSTANDS AND AGREES THAT SUBCONTRACTOR IS SOLELY LIABLE AND SOLELY RESPONSIBLE FOR THE HEALTH AND SAFETY OF ITS AGENTS AND THAT SUBCONTRACTOR POSSESSES THE AUTHORITY, EXPERTISE, CONTROL AND MEANS TO CARRY OUT SUCH RESPONSIBILITY.

52. CEILING HEIGHTS SHALL COMPLY WITH SECTION R305. WHERE UNFINISHED, CEILING HEIGHTS SHALL ALLOW FOR 1" MINIMUM FOR FINISHES TO COMPLY.

53. PROVIDE TEMPERED GLASS IN LOCATIONS DESIGNATED AS BEING HAZARDOUS UNDER SECTION R308.4 CONFORMING WITH THE REQUIREMENTS THEREIN.

54. PROVIDE A SOLID CORE WOOD DOOR NOT LESS THAN 1-3/8" THICKNESS BETWEEN THE GARAGE AND THE RESIDENCE (R3023.1). PROVIDE AN AUTOMATIC DOOR CLOSER.

55. PROVIDE 5/8" TYPE "X" GYPSUM WALLBOARD FOR ALL WALLS AND CEILINGS SEPARATING THE GARAGE AND ANY HABITABLE OR USEABLE SPACE, INCLUDING ATTIC SPACE, AND THE STRUCTURE SUPPORTING THE SEPARATION (R302). DUCTWORK IN THE GARAGE OR PENETRATING ANY WALL OR CEILING BETWEEN THE GARAGE AND ANY HABITABLE OR USEABLE SPACE SHALL BE CONSTRUCTED OF NOT LESS THAN 26 GAUGE STEEL.

56. WINDOW WELLS SHALL BE OF GALVANIZED STEEL OR REINFORCED CONCRETE UNO. AND BE OF SUFFICIENT STRENGTH TO RESIST BACKFILL PRESSURES AND SHALL HAVE MINIMUM HORIZONTAL AREA OF 9 SF, WITH A MINIMUM HORIZONTAL PROJECTION AND WIDTH OF 36" (R310). PROVIDE A PERMANENTLY AFFIXED LADDER WHERE WINDOW DEPTH EXCEEDS 44". TOP OF WELL SHALL EXTEND NOT LESS THAN 3" ABOVE FINISHED GRADE AND BOTTOM OF WELL SHALL EXTEND NOT LESS THAN 9" BELOW WINDOW SILL. PROVIDE DRAINAGE BY CONNECTING TO THE BUILDING FOUNDATION DRAINAGE SYSTEM OR APPROVED ALTERNATIVE METHOD.

57. STAIRWAYS, RAMPS EXTERIOR EXIT BALCONIES, HALLWAYS AND DOORS SHALL COMPLY WITH THE REQUIREMENTS OF SECTION R311. STAIR TREADS AND RISERS SHALL HAVE MAXIMUM RISER HEIGHT OF 1 3/4" AND MINIMUM TREAD DEPTH OF 10". RISER HEIGHTS AND TREAD DEPTH SHALL NOT VARY MORE THAN 3/8". EACH EXTERIOR DOOR SHALL HAVE A FLOOR OR LANDING ON EACH SIDE. THE LANDING AT ANY EXTERIOR DOOR SHALL NOT BE MORE THAN 1 3/4" BELOW THE TOP OF THE DOOR THRESHOLD PROVIDED THE DOOR DOES NOT SWING OVER THE LANDING.

58. PROVIDE AN INTERCONNECTED SMOKE DETECTOR SYSTEM, HAVING A SMOKE ALARM IN EACH SLEEPING ROOM, OUTSIDE OF EACH SEPARATE SLEEPING AREA IN THE IMMEDIATE VICINITY OF THE BEDROOMS AND ON EACH ADDITIONAL STORY INCLUDING EASEMENTS (R314).

59. PROVIDE AN INTERCONNECTED CARBON MONOXIDE ("CO") DETECTION SYSTEM, HAVING A CO ALARM WITHIN 10' OF THE ENTRANCE OF EVERY ROOM INTENDED TO BE LAWFULLY USED FOR SLEEPING PURPOSES, TYPICALLY IN A CENTRAL LOCATION SUCH AS A HALLWAY, AND ON EACH FLOOR LEVEL INTENDED TO BE LAWFULLY USED FOR PURPOSES, INCLUDING THE BASEMENT, THAT DOES NOT HAVE A ROOM INTENDED TO BE LAWFULLY USED FOR SLEEPING PURPOSES. CO ALARMS SHALL HAVE PERMANENT CO SENSOR OR REPLACEABLE CO SENSOR WITH END OF LIFE INDICATOR (R315).

510. PROVIDE A CRAWL SPACE ACCESS OPENING AND PANEL NOT LESS THAN 18"x24" (R408). SEE SECTION M305.1.4 FOR ACCESS REQUIREMENTS WHERE MECHANICAL EQUIPMENT IS LOCATED UNDER FLOORS.

511. PROVIDE A MINIMUM OF 3" BETWEEN ANY RECESSED LIGHT, FAN OR ANY OTHER HEAT PRODUCING OR EMANATING DEVICE AND COMBUSTIBLE INSULATION, UNLESS APPROPRIATELY LISTED FOR LESS CLEARANCE.

512. PROVIDE DRAFTSTOPPING AND FIREBLOCKING PER THE MOST STRINGENT APPLICABLE REQUIREMENTS THEREUNDER THE IRC, THE INTERNATIONAL MECHANICAL CODE (IMC), THE INTERNATIONAL PLUMBING CODE (IPC), THE NATIONAL ELECTRICAL CODE (NEC) AND THE INTERNATIONAL ENERGY CONSERVATION CODE (IECC). FIREBLOCKING SHALL BE PROVIDED TO CUT OFF ALL CONCEALED DRAFT OPENINGS (BOTH VERTICAL AND HORIZONTAL) AND TO FORM AN EFFECTIVE FIRE BARRIER BETWEEN STORIES, AND BETWEEN A TOP STORY AND THE ROOF SPACE. FIREBLOCKING SHALL BE SPECIFICALLY PROVIDED AT THE LOCATIONS DESIGNATED IN SECTION R302.11.

513. PROVIDE AN ATTIC ACCESS OPENING AND PANEL NOT LESS THAN 22" X 30" IN A READILY ACCESSIBLE LOCATION, PREFERABLY A SECONDARY BEDROOM (R301). PROVIDE NOT LESS THAN 30" OF UNOBSTRUCTED HEADROOM ABOVE THE OPENING. PROVIDE GASKET FOR ACCESS PANEL (IECC 402.2.4). REFER TO SECTIONS M305 AND M306 FOR MECHANICAL ACCESS AND CLEARANCE REQUIREMENTS.

CONCRETE AND MASONRY

C1. COMPLY WITH APPLICABLE REQUIREMENTS SET FORTH IN THE IRC AND THE IBC.

C2. REFER TO THE STRUCTURAL PLANS FOR STRUCTURAL CONCRETE AND MASONRY REQUIREMENTS.

C3. UNO. ON THE STRUCTURAL PLANS OR NOTES, THE MINIMUM SPECIFIED 28 DAY COMPRESSIVE STRENGTH FOR CONCRETE COMPONENTS EXPOSED TO MODERATE OR SEVERE WEATHERING POTENTIAL SHALL BE:

PORCHES, PATIOS, DRIVEWAYS, GARAGE FLOOR SLABS AND WALKWAYS EXPOSED TO THE WEATHER - 3500 PSI.  
BASEMENT WALLS, FOUNDATION WALLS AND OTHER WALLS EXPOSED TO THE WEATHER - 3,000 PSI, AIR ENTRAINED 5 TO 7 PERCENT.  
BASEMENT SLABS AND INTERIOR SLABS ON GRADE, EXCEPT GARAGE FLOOR SLABS - 3,000 PSI.  
REFER TO STRUCTURAL PLANS AND NOTES FOR STRUCTURAL CONCRETE REQUIREMENTS. (R402)

C4. SLOPE ALL EXTERIOR CONCRETE SURFACES NOT LESS THAN 1/8" AND NOT MORE THAN 1/4" PER FOOT AWAY FROM HOUSE. SLOPE GARAGE FLOORS APPROXIMATELY 4" REAR TO FRONT TO FACILITATE THE MOVEMENT OF LIQUIDS TOWARD THE MAIN VEHICLE ENTRY DOORWAY (R304.1).

C5. FOUNDATION WALLS SHALL BE CONSTRUCTED IN ACCORDANCE WITH SECTION R404 AND ACI 318 AND SHALL EXTEND A MINIMUM OF 6" ABOVE GRADE AT ALL POINTS, 4" WHERE MASONRY VENEER IS USED.

C6. BASEMENT CONCRETE FLOORS SHALL BE PLACED OVER A MINIMUM 6-MIL POLYETHYLENE VAPOR RETARDER COMPLYING WITH ASTM E 1745, WITH JOINTS LAPPED NOT LESS THAN 12" OVER PREPARED 4" THICK BASE COURSE PER SECTION R306.2.

C7. CONCRETE FLOORS AND FOUNDATIONS SHALL BE MADE LEVEL WITHIN 1/2" IN 20' BUT NO MORE THAN 1" ACROSS THE FULL WIDTH OR LENGTH UNO. OR SPECIFICALLY DESIGNED FOR DRAINAGE.

C8. MASONRY AND STONE VENEER (INCLUDING MANUFACTURED) MATERIAL AND INSTALLATION SHALL COMPLY WITH SECTION 103.1. THE MASONRY OR STONE MANUFACTURER'S WRITTEN INSTALLATION INSTRUCTIONS AND RECOMMENDATIONS, THE MASONRY OR STONE MANUFACTURER'S WRITTEN CODE EVALUATION/APPROVAL DOCUMENTS AND THE REQUIREMENTS SET FORTH BY THE BRICK INDUSTRY ASSOCIATION FOR BRICK.

C9. PROVIDE A MINIMUM 6" BY 4" BY 5/16" GALVANIZED STEEL ANGLE TO SUPPORT EXTERIOR MASONRY VENEERS UNO. ON THE STRUCTURAL PLANS (R103).

C10. ATTACH EXTERIOR MASONRY VENEER WITH GALVANIZED TIES, SPACED NOT MORE THAN 24" ON CENTER HORIZONTALLY AND VERTICALLY AND SHALL SUPPORT NO MORE THAN 2.61 SF. OF WALL AREA (R103.7). PROVIDE FLASHING AND KNEEHOLES AS SHOWN IN FIGURE R103.7.

C11. MINIMUM SOIL CAPACITY IS ASSIGNED TO BE 2000 PSF AT ALL WALL AND PIER FOOTINGS. IT IS THE OWNER'S RESPONSIBILITY TO VERIFY BEARING CAPACITY AND TO NOTIFY THE DESIGNER IF THE CAPACITY IS LESS THAN 2000 PSF.

WOOD, METAL AND PLASTIC

M1. COMPLY WITH APPLICABLE REQUIREMENTS SET FORTH IN THE IRC AND THE IBC.

M2. WOOD MEMBERS AND PRODUCTS SHALL BE IDENTIFIED BY GRADE MARK OR CERTIFICATE OF INSPECTION ISSUED BY AN APPROVED AGENCY.

M3. REFER TO THE STRUCTURAL PLANS FOR STRUCTURAL FRAMING AND SHEATHING REQUIREMENTS.

M4. FASTENERS AND CONNECTORS IN CONTACT WITH PRESERVATIVE-TREATED OR FIRE-RETARDANT TREATED WOOD SHALL BE OF HOT DIPPED ZINC-COATED GALVANIZED STEEL UNLESS OTHERWISE PERMITTED UNDER SECTION R313.

M5. DO NOT CUT, SPLICE, NOTCH, OR OTHERWISE ALTER ANY SAWN LUMBER IN EXCESS OF THE LIMITATIONS SET FORTH IN SECTIONS R502, R602 AND R802 WITHOUT THE WRITTEN APPROVAL OF THE ENGINEER OF RECORD.

M6. DO NOT CUT, SPLICE, NOTCH, OR OTHERWISE ALTER ANY ENGINEERED WOOD PRODUCT OR TRUSS WITHOUT THE WRITTEN APPROVAL OF THE MANUFACTURER OR ENGINEER OF RECORD, UNLESS THE EFFECTS OF ANY SUCH PENETRATION IS CONSIDERED IN ITS DESIGN BY THE MANUFACTURER OR ENGINEER OF RECORD (R502 AND R802).

M7. ENDS OF EACH JOIST, SEAM, OR GIRDER SHALL BEAR NOT LESS THAN 1 1/2" ON WOOD OR METAL AND 3" ON CONCRETE (R502 AND R802).

M8. TRUSS SHOP DRAWINGS SHALL COMPLY WITH SECTIONS 502 AND 802 AND SHALL BE PROVIDED TO THE BUILDING OFFICIAL AND ENGINEER OF RECORD AND APPROVED BY BOTH PRIOR TO INSTALLATION. BRACE TRUSSES IN ACCORDANCE WITH TP114B UNO. ON THE SHOP DRAWINGS. TRUSS TO WALL AND TRUSS TIE DOWN CONNECTIONS SHALL COMPLY WITH R802. ALL PERMANENT AND TEMPORARY BRACING LOCATIONS SHALL BE PREMARKED BY THE TRUSS MANUFACTURER.

M9. WHERE FOUNDATION CRIPPLE WALLS EXCEED 4' IN HEIGHT, FRAME SUCH WALLS WITH STUDS HAVING THE SIZE REQUIRED FOR AN ADDITIONAL STORY (R602).

M10. PROVIDE BACKING AND BLOCKING FOR RAILINGS AT STAIR OPENINGS AND ALONG WALLS WHERE RAILS MAY ATTACH, INCLUDING EXTERIOR RAILINGS, FOR BATHROOM ACCESSORIES, SHOWER DOORS, CLOSET ITEMS, SHELVING, HARDWARE AND OTHER ACCESSORIES, AT OR ALONG COVERED PORCH AND PATIO SOFFITS AND CANTILEVERED FLOORS AND ELSEWHERE AS REQUIRED OR DIRECTED. PROVIDE 3" MINIMUM OF BACKING AROUND DOOR AND WINDOW OPENINGS. PROVIDE DRYHALL BACKING ALONG ALL TUBS AND TUB DECKS, SHOWER PANS, AND SHOWER SEATS AND ELSEWHERE AS REQUIRED OR DIRECTED.

M11. SHEATH AND SEAL THE UNDERSIDE OF ALL CANTILEVERED FLOOR AREAS WITH EXTERIOR EXPOSURE RATED SHEATHING: WHERE WOOD SIDING, SHEATHING OR FRAMING IS WITHIN 6" OF GRADE, EACH SHALL BE PROTECTED AGAINST DECAY (R311). INSULATE CANTILEVERED FLOOR AREAS BEFORE CLOSING IN OR PROVIDE OPENING SUFFICIENT TO INSULATE AFTER THE FACT.

M12. FLOORS SHALL BE MADE LEVEL WITHIN 1/4" IN 20' BUT NO MORE THAN 1/2" ACROSS THE FULL WIDTH OR LENGTH.

M13. WOOD, HARDBOARD, FIBER CEMENT AND VINYL SIDING MATERIAL AND INSTALLATION SHALL COMPLY WITH SECTION 103.3 OR 103.10 AS APPLICABLE, THE SIDING MANUFACTURER'S WRITTEN INSTALLATION INSTRUCTIONS AND RECOMMENDATIONS, THE SIDING MANUFACTURER'S WRITTEN CODE EVALUATION/APPROVAL DOCUMENTS AND APPLICABLE RECOMMENDATIONS SET FORTH BY THE AMERICAN HARDBOARD ASSOCIATION OR THE VINYL SIDING INSTITUTE FOR HARDBOARD, PAINT AND/OR SEAL ALL WOOD AND HARDBOARD EDGES.

M14. FINISH CARPENTRY, MILLWORK AND CABINETRY INSTALLATION SHALL COMPLY WITH THE MILLWORK MANUFACTURER'S WRITTEN INSTALLATION INSTRUCTIONS AND RECOMMENDATIONS AND APPLICABLE ARCHITECTURAL.

THERMAL AND MOISTURE PROTECTION

T1. COMPLY WITH APPLICABLE REQUIREMENTS SET FORTH IN THE IRC, THE IECC, AND THE IMC.

T2. DURABLY SEAL THE BUILDING THERMAL ENVELOPE TO LIMIT INFILTRATION. SEAL ALL JOINTS, SEAMS, AND PENETRATIONS WITH DURABLE CAULKS, SEALANTS OR GASKETS, WEATHERSTRIPS, AIR BARRIERS, FILMS AND/ OR SELF-ADHESIVE FLASHING, EACH AS APPROPRIATE TO THE APPLICABLE CONDITION. THESE INCLUDE JOINTS, SEAMS AND PENETRATIONS THROUGH BETWEEN, AROUND OR ALONG CONDITIONED AND UNCONDITIONED SPACES WITHIN THE HOUSE, INCLUDING, AT A MINIMUM, GARAGE AND CONDITIONED SPACE, TUBS AND SHOWERS, ATTIC AND CRAWL SPACE ACCESSSES, WINDOW AND DOOR ASSEMBLIES, AND THEIR RESPECTIVE JAMBS AND FRAMING, RECESSED LIGHTS, PLUMBING, HVAC AND ELECTRICAL PENETRATIONS, CHIMNEYS, DROPPED CEILINGS, KNEE WALLS, RIMBOARD, SILL PLATES, BLOCKINGS AND OTHER SOURCES OF INFILTRATION. (N102.4 AND IECC 402). REFER TO THERMAL BY-PASS PLANS. VERIFY AIR SEALING THROUGH POST ROUGH-IN TEST OR THROUGH VISUAL INSPECTION (N102.4 AND IECC 402.4).

T3. A PERMANENT CERTIFICATE SHALL BE COMPLETED AND POSTED ON OR IN THE ELECTRICAL DISTRIBUTION PANEL. THIS CERTIFICATE SHOULD NOT COVER OR OBSTRUCT CIRCUIT DIRECTORY AND SHALL LIST THE PREDOMINANT INSULATION R-VALUES OF THE VARIOUS COMPONENTS INSTALLED IN THE HOME. THIS CERTIFICATE SHOULD ALSO LIST THE U-FACTORS AND SOLAR HEAT GAIN COEFFICIENT OF PENETRATION (IECC 401).

T4. FURNISH AND INSTALL THE FOLLOWING MINIMUM INSULATION THERMAL RESISTANCE AS SET FORTH BELOW. INSTALL IN ACCORDANCE WITH THE INSULATION MANUFACTURER'S WRITTEN INSTALLATION INSTRUCTIONS AND RECOMMENDATIONS AND THE RECOMMENDATIONS SET FORTH BY THE NORTH AMERICAN INSULATION MANUFACTURER'S ASSOCIATION.

A. R-20	2x6 EXTERIOR WALLS AND RIM BOARDS
B. R-49	ROOF AREAS
C. R-49	CATHEDRAL ROOF AND BAY WINDOW CEILINGS
D. R-19	CANTILEVERS AND FLOORS OF LIVING AREAS OVER UNHEATED SPACES
E. R-10/3	BASEMENT AND CRAWL SPACE WALLS
F. R-10	FROST WALL AND MOUNTAIN (A MIN. OF 24" XPS)
G. 0.35	MAXIMUM U-FACTOR LOWE MINIMUM

T5. FOR BASEMENT WALLS, WHEN OF CAST-IN-PLACE CONCRETE, THE APPLICATION OF ANY VAPOR RETARDER WITH OR OVER INSULATION SHALL BE DELAYED UNTIL THE WALL HAS CURED AND DRIED. VAPOR RETARDERS USED WITH INSULATION IN SUCH WALLS SHALL BE A CLASS III.

T6. INSULATE ALL SUPPLY DUCTS IN UNCONDITIONED SPACES WITH A MINIMUM R-8. INSULATE ALL OTHER DUCTS WITH A MINIMUM R-6. INSULATING DUCTS COMPLETELY INSIDE THE BUILDING THERMAL ENVELOPE IS NOT REQUIRED (IECC 403).

T7. ANY WATER OR WASTE PIPE INSTALLED IN AN EXTERIOR WALL, ATTIC, OR CRAWL SPACE SHALL BE PROTECTED FROM FREEZING BY INSULATION OR HEAT OR BOTH (F2603). PIPE INSULATION IN ANY ATTIC OR CRAWL SPACE SHALL BE PIPE INSULATION.

T8. BATHROOMS, WATER CLOSET COMPARTMENTS, LAUNDRY ROOMS AND OTHER SIMILAR ROOMS NOT HAVING OPERABLE WINDOWS SHALL BE PROVIDED WITH A MECHANICAL FAN HAVING A VENTILATION RATE IN ACCORDANCE WITH MECH. EXHAUST DIRECTLY TO THE OUTSIDE. RECIRCULATING FANS ARE PROHIBITED. (R303)

T9. DAMP PROOF FOUNDATION WALLS THAT RETAIN EARTH AND ENCLOSE HABITABLE SPACE AND CRAWL SPACE WALLS. IN AREAS WHERE A HIGH WATER TABLE OR OTHER SEVERE SOIL-WATER CONDITIONS EXIST, ALL SUCH WALLS SHALL BE WATERPROOFED (R406). DAMPROOF ALL FOUNDATION WALLS THAT ENCLOSE ANY CRAWL SPACES. REFER TO THE PROJECT SOILS REPORT FOR ADDITIONAL REQUIREMENTS.

T10. FULLY COVER THE GROUND SURFACE OF CRAWL SPACES AND UNDER FLOOR SPACES WITH A 10-MIL MINIMUM CLASS I VAPOR RETARDER COMPLYING WITH ASTM E 1745, WITH JOINTS LAPPED NOT LESS THAN 12" AND SEALED (SHEATHING TAPE OR EQUAL) (R408). SEAL AROUND SUMP PITS, COLUING, PLUMBING AND OTHER PENETRATIONS. EXTEND UP THE WALL NOT LESS THAN 12" AND ATTACH CONTINUOUSLY.

T11. CRAWL SPACES AND UNDER FLOOR AREAS SHALL BE SUPPLIED WITH A CONDITIONED AIR AND/OR CONTINUOUS MECHANICAL VENTILATION AS SHOWN ON THE PLANS (R408.3). THE GROUND SURFACE SHALL BE COVERED AS NOTED UNDER T10 AND THE WALLS INSULATED AS NOTED UNDER T4.

T12. FULLY REMOVE AND/OR CLEAN ALL DEBRIS, WASTE, VEGETATION AND OTHER MATERIAL FROM BENEATH ANY AT GRADE BELOW GRADE FLOOR AREA OR CRAWL SPACE (R408).

T13. PROVIDE WEATHER-RESISTANT SHEATHING PAPER BENEATH STUCCO, CULTURED STONE, SIDING AND MASONRY AS SET FORTH IN TABLE R103.4. SHEATHING PAPER SHALL BE SINGLE PLY ASPHALT-SATURATED KRAFT GRADE D BREATHER TYPE PAPER, HAVING A 60 MINUTE WATER RESISTANCE RATING UNDER ASTM D 719. PROVIDE 2 LAYERS BEHIND STUCCO AND CULTURED STONE AND 1 LAYER BEHIND SIDING AND MASONRY. APPROVED HOUSEWRAP MAY BE SUBSTITUTED FOR 1 LAYER ONLY AND SHALL HAVE SHEATHING PAPER PLACED OVER IT WHEN UNDER STUCCO OR MANUFACTURED STONE.

T14. INSTALL EXTERIOR WINDOWS AND DOORS IN STRICT ACCORDANCE WITH THE MANUFACTURER'S WRITTEN INSTALLATION INSTRUCTIONS, GUIDELINES AND RECOMMENDATIONS AND ASTM E 212. PROVIDE PAN FLASHING FOR ALL EXTERIOR DOORS.

T15. PROVIDE DURABLE WEATHER STRIPPING FOR ALL EXTERIOR DOORS AND WINDOWS.


T16. PROVIDE FLASHING IN SUCH MANNER AS TO PREVENT ENTRY OF WATER INTO THE WALL ASSEMBLY, WALL CAVITY OR ROOF ASSEMBLY, AND PENETRATION OF WATER TO THE BUILDING STRUCTURAL FRAMING COMPONENTS. FLASH AND SEAL ALL EXTERIOR WINDOWS, DOORS, OPENINGS, PENETRATIONS AND JOINTS SO AS TO PREVENT MOISTURE FROM PASSING THROUGH BEYOND OR AROUND AND TO MAKE SUCH LEAKPROOF. PROVIDE MANUFACTURED FLASHINGS AT ALL PENETRATIONS. ALL MEMBRANES, BARRIERS, PAPERS, FELTS AND FLASHINGS SHALL BE LAPPED IN A SHEDDING MANNER. PROVIDE FLASHING AS SPECIFICALLY DENOTED IN SECTIONS R103, R403 AND R405.

T17. ROOF ASSEMBLIES SHALL COMPLY WITH THE REQUIREMENTS SET FORTH IN CHAPTER 9, ROOF COVERING MATERIALS AND INSTALLATION SHALL COMPLY WITH THE ROOFING MANUFACTURER'S WRITTEN INSTALLATION INSTRUCTIONS, THE ROOF COVERING MANUFACTURER'S WRITTEN CODE EVALUATION/APPROVAL DOCUMENTS AND RECOMMENDATIONS AND THE REQUIREMENTS SET FORTH BY THE NATIONAL ROOFING CONTRACTORS ASSOCIATION, THE ASPHALT ROOFING MANUFACTURER'S ASSOCIATION, AND THE ROOF TILE INSTITUTE FOR EACH APPLICABLE COVERING. UNDERLAYMENT SHALL COMPLY WITH SECTION 905 AND WHEN OF ASPHALT SATURATED OR SBS MODIFIED FELT SHALL BE REINFORCED POLYESTER OR FIBERGLASS.


T18. PROVIDE ROOF FLASHING PER SECTION R405 PER TYPE OF COVERING. FOR TILE ROOFS, ROOF VALLEY AND SIDEWALL FLASHINGS SHALL BE DOUBLE RAISED RIBBED. PROVIDE DRIP EDGES AT ROOF EAVES AND RAKES FOR ALL COMPOSITION ROOF COVERINGS AND WHERE REQUIRED OR RECOMMENDED FOR TILE ROOFS BY THE ROOF COVERING MANUFACTURER. PROVIDE KICK-OUT DIVERTER FLASHING AT ALL EAVE TO SIDE WALL JUNCTURES. FLASHING TO DIVERTE WATER OFF THE FACE OF ANY SIDE WALL 4" MINIMUM.

T19. PROVIDE ATTIC VENTILATION PER SECTION R306 (CONFIRM MANUFACTURER'S NET FREE AREA). SOFFIT, EAVE, AND CORNICE VENTS SHALL BE PROVIDED WITH A MANUFACTURED WEATHERPROOF INSULATION BARRIER (NONORGANIC) DESIGNED TO PROVIDE A MINIMUM OF 1" FREE SPACE BETWEEN INSULATION BARRIER AND UNDERS



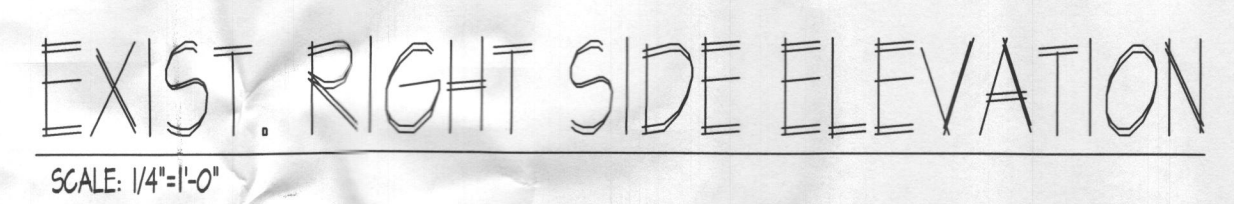



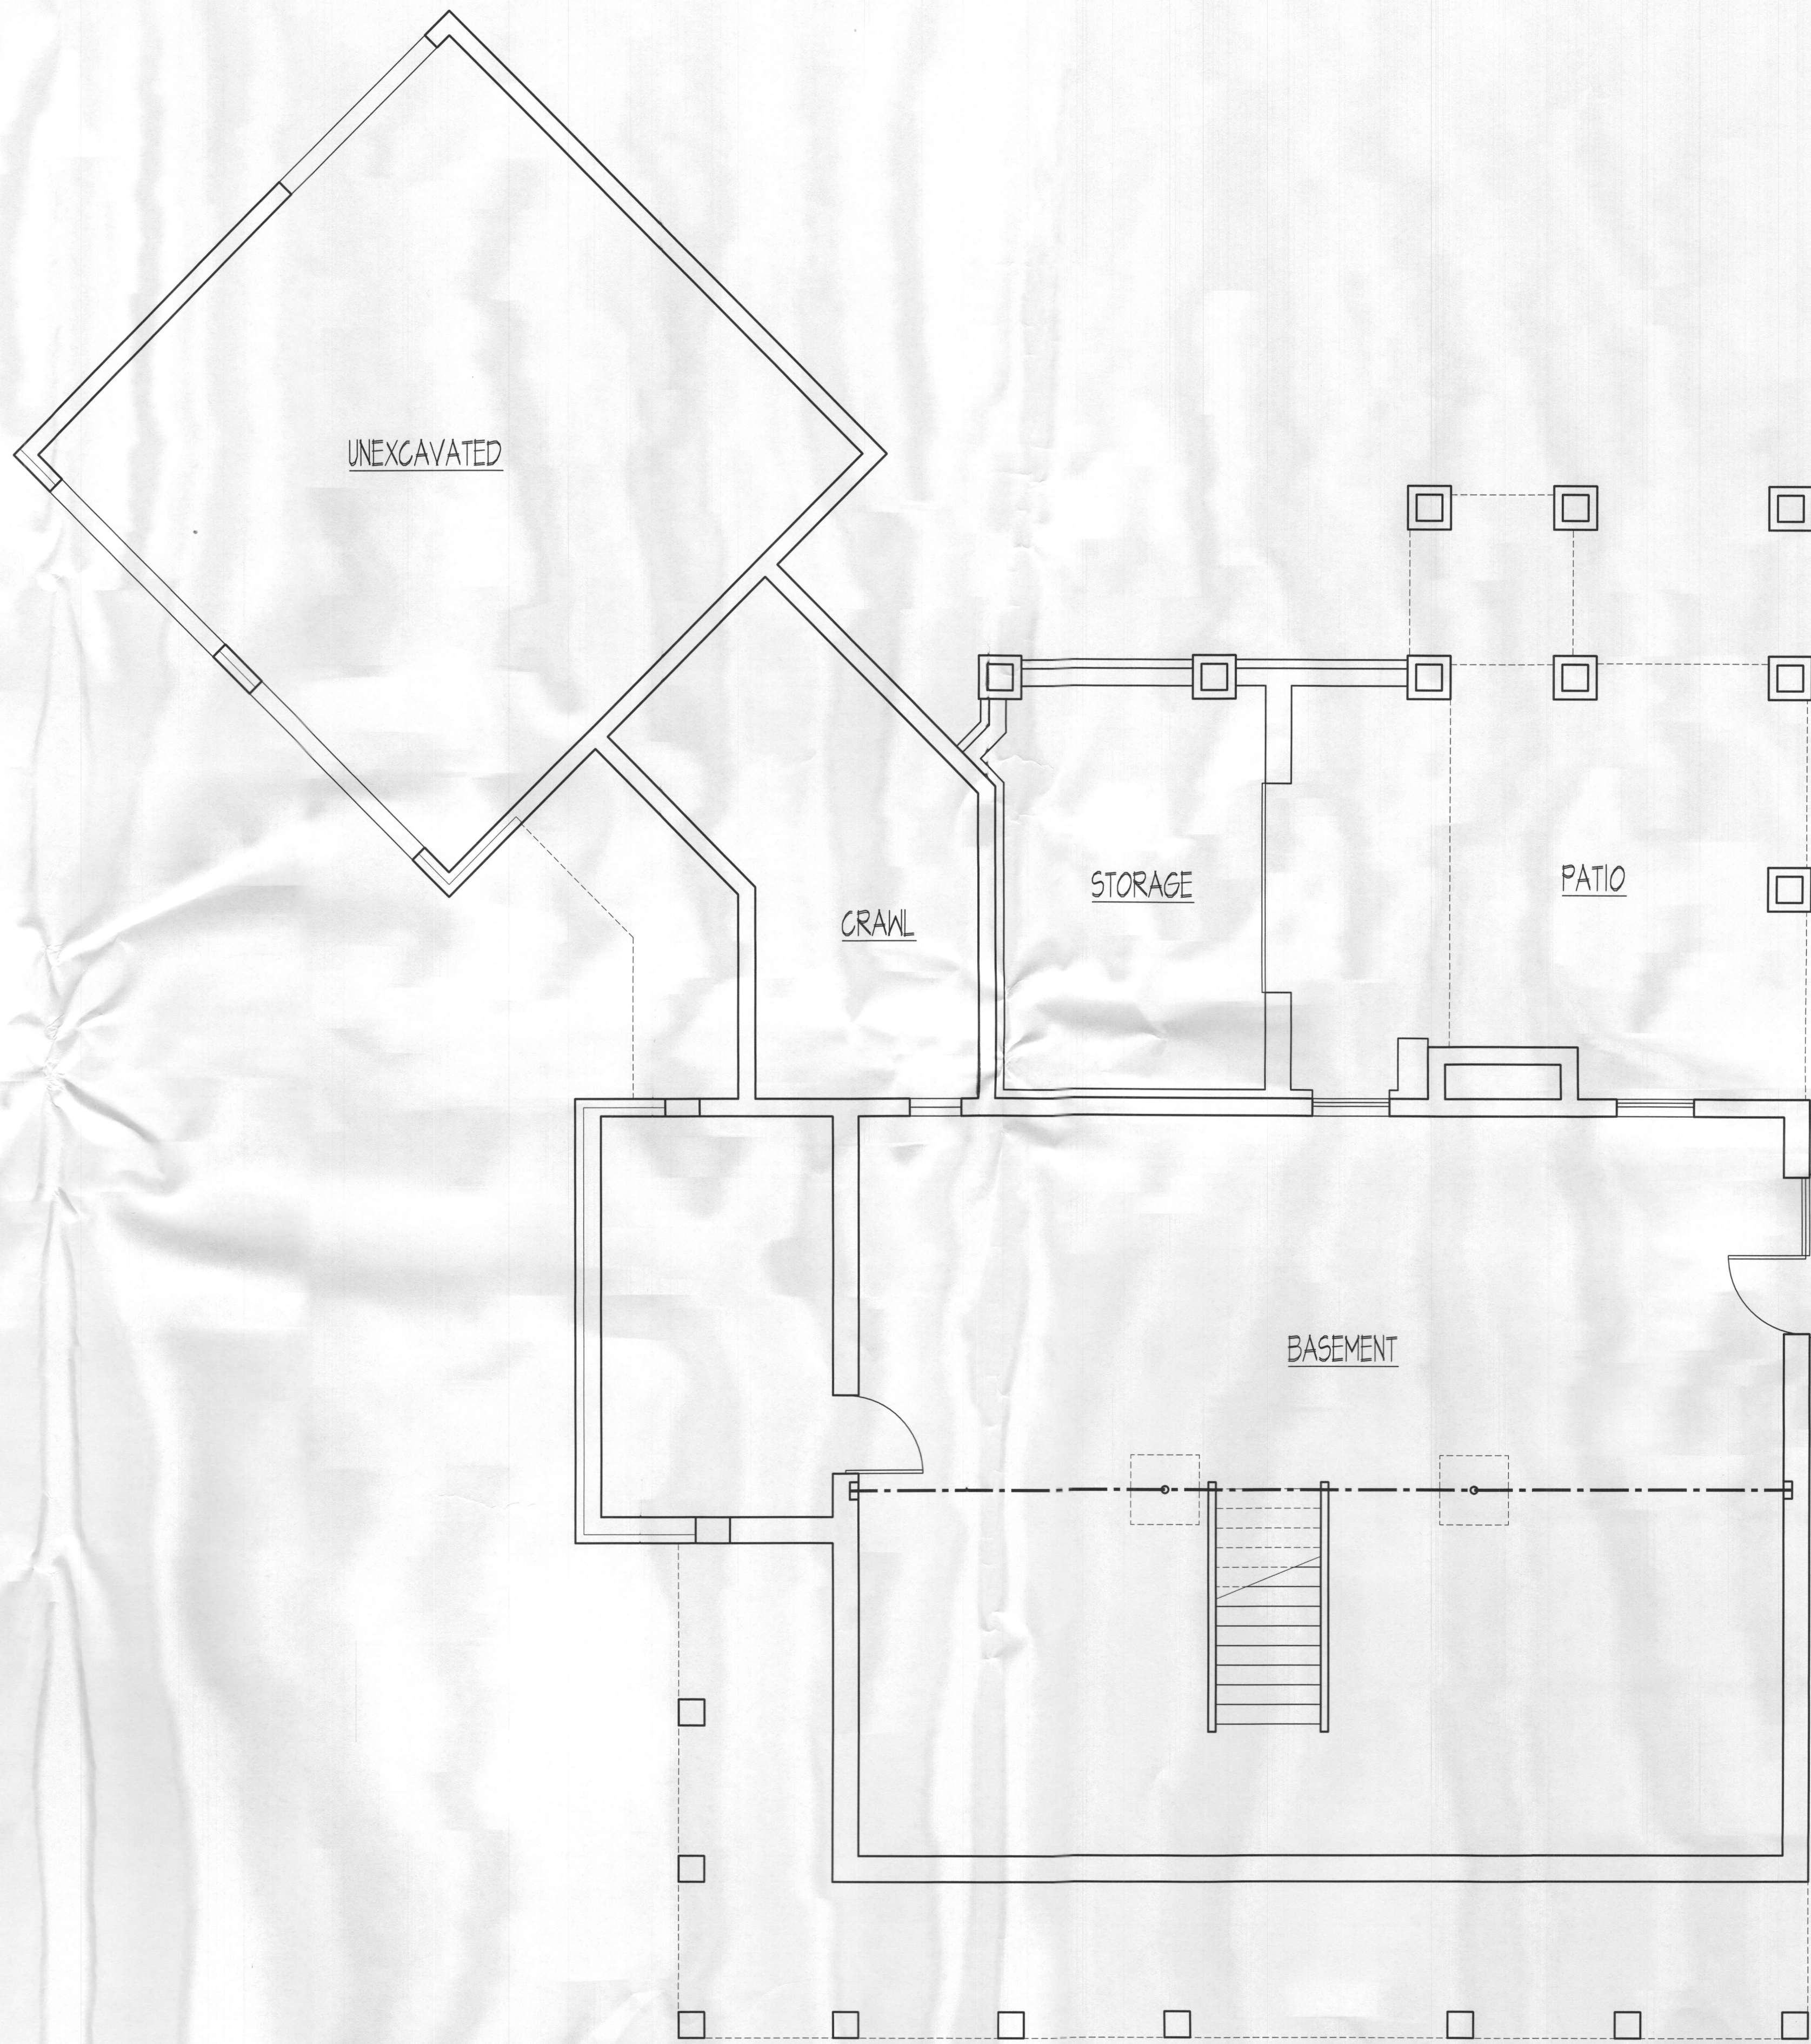


EXIST. FOUNDATION PLAN  
SCALE: 1/4"=1'-0"



**JB HOME DESIGN, LLC**  
446 CONCORD COURT  
BALTIMORE, MARYLAND 21234  
OFFICE (410) 594-6571  
FAX (410) 665-4068  
EMAIL: J@JBHOMEDSIGN.COM

CONTENTS			
EXIST. FOUNDATION PLAN			
SCALE:	1/4" = 1'-0"	DATE:	
DRWN:		PRJ. NO.:	
PROJECT TITLE:			
MORRIS ADDITION			

ISSUE	PERMITTING SET	
	NO. 01/16	DATE 01/16
SHEET NO.	EX-2	