

4536		SEQUENCE NO. (DENY USE ONLY)		STATE OF MARYLAND WELL COMPLETION REPORT FILL IN THIS FORM COMPLETELY PLEASE PRINT OR TYPE		THIS REPORT MUST BE SUBMITTED WITHIN 45 DAYS AFTER WELL IS COMPLETED.	
1 2 3 4 5 6 (THIS NUMBER IS TO BE PUNCHED IN COLS. 3-6 ON ALL CARDS)		ST/CO USE ONLY DATE Received		DATE WELL COMPLETED		Depth of Well	
8 13		15 20		22 27 28		28 29 30 31 32 33 34 35 36 37	
OWNER <u>VENEZA</u>		last name		first name		TOWN <u>Glenwood</u>	
STREET OR RFD <u>3920 Sharp Rd</u>		SUBDIVISION <u>HILL SUBDIVISION</u>		SECTION		LOT	
WELL LOG Not required for driven wells STATE THE KIND OF FORMATIONS PENETRATED, THEIR COLOR, DEPTH, THICKNESS AND IF WATER BEARING		DESCRIPTION (Use additional sheets if needed)		FEET FROM TO		Check if water bearing	
Dirt		0 9					
Soft Br. mica		9 40					
Soft Br. Mica		40 41		X			
Soft Br. Mica		41 84					
Blue & Br. Sand- stone		84 96					
Br. Sandstone		96 97		X			
Blue Sandstone		97 190					
Br. Sandstone		190 191		X			
Blue Sandstone		191 227					
GROUTING RECORD		WELL HAS BEEN GROUTED (Circle Appropriate Box)		yes ☒ Y no ☐ N		C 3	
TYPE OF GROUTING MATERIAL		CEMENT ☒ CM BENTONITE CLAY ☐ BC					
NO. OF BAGS <u>14</u>		NO. OF POUNDS <u>1,316</u>					
GALLONS OF WATER		DEPTH OF GROUT SEAL (to nearest foot)					
from <u>0</u> ft. to <u>85</u> ft.							
casing types insert appropriate code below		CASING RECORD		ST CO PL OT		PUMPING TEST	
MAIN CASING TYPE		Nominal diameter top (main) casing (nearest inch)		Total depth of main casing (nearest foot)		HOURS PUMPED (nearest hour)	
S T 6 8 7						PUMPING RATE (gal. per min. to nearest gal.)	
OTHER CASING (if used) diameter inch depth (feet)						METHOD USED TO MEASURE PUMPING RATE <u>Flowmeter</u>	
screen type or open hole insert appropriate code below		SCREEN RECORD		ST BR HO PL OT		WATER LEVEL (distance from land surface)	
C 2		DEPTH (nearest ft.)				BEFORE PUMPING	
H O 8 7 2 2 7						WHEN PUMPING	
C 2						TYPE OF PUMP USED (for test)	
						A air P piston T turbine	
						C centrifugal R rotary O other (describe below)	
						J jet S submersible	
CIRCLE APPROPRIATE LETTER		PUMP INSTALLED		YES NO			
A A WELL WAS ABANDONED AND SEALED WHEN THIS WELL WAS COMPLETED		DRILLER WILL INSTALL PUMP (CIRCLE) (YES or NO)		IF DRILLER INSTALLS PUMP, THIS SECTION MUST BE COMPLETED FOR ALL WELLS EXCEPT HOME USE			
E ELECTRIC LOG OBTAINED		TYPE OF PUMP INSTALLED		PLACE (A,C,J,P,R,S,O) IN BOX - SEE ABOVE:			
P TEST WELL CONVERTED TO PRODUCTION WELL		CAPACITY: GALLONS PER MINUTE (to nearest gallon)		PUMP HORSE POWER			
I HEREBY CERTIFY THAT THIS WELL HAS BEEN CONSTRUCTED IN ACCORDANCE WITH COMAR 26.04.04 "WELL CONSTRUCTION" AND IN CONFORMANCE WITH ALL CONDITIONS STATED IN THE ABOVE CAPTIONED PERMIT, AND THAT THE INFORMATION PRESENTED HEREIN IS ACCURATE AND COMPLETE TO THE BEST OF MY KNOWLEDGE.		PUMP COLUMN LENGTH (nearest ft.)		CASING HEIGHT (circle appropriate box and enter casing height)			
DRILLERS IDENT. NO. <u>256</u>		LAND SURFACE		2 (nearest foot)			
DANA KYKER JR. II		LOCATION OF WELL ON LOT		SHOW PERMANENT STRUCTURE SUCH AS BUILDING, SEPTIC TANKS, AND/OR LANDMARKS AND INDICATE NOT LESS THAN TWO DISTANCES (MEASUREMENTS TO WELL)			
DRILLERS SIGNATURE (MUST MATCH SIGNATURE ON APPLICATION)		TELESCOPE CASING		LOG INDICATOR			
SITE SUPERVISOR (sign. of driller or journeyman responsible for sitework if different from permittee)		OEP USE ONLY (NOT TO BE FILLED IN BY DRILLER)		OTHER DATA			

B1

8587

SEQUENCE NO.
(DP USE ONLY)

STATE OF MARYLAND
PERMIT TO DRILL WELL
please print or type

STATE PERMIT NUMBER
40-88-1665
fill in this form completely

Date Received (APA)
02/11/91

OWNER INFORMATION
VENEZA TOM
3920 SHARP ROAD
GLENWOOD MD
Last Name First Name Street or RFD Town State Zip

B3 LOCATION OF WELL
HOWARD
COUNTY
TILL
SUBDIVISION
SECTION 44 46 LOT 48 50
GLENWOOD
NEAREST TOWN
MILES FROM TOWN (enter 0 if in town) 2 MI

DRILLER INFORMATION
DANA KUKOS JR II
Westminster Rotary Well Drilling
20 Bon 861 Westminster MD 21157
Dana Kukos Jr II 2/7/91
Driller's Name License No. 80 Firm Name Address Signature Date

B4 DIRECTION OF WELL FROM TOWN (CIRCLE BOX)
TOWN
NORTH
ON WHICH SIDE OF ROAD (CIRCLE APPROPRIATE BOX)
SHARP ROAD
NEAR WHAT ROAD
DISTANCE FROM ROAD 30
ENTER FT or MI ET

B2 WELL INFORMATION
APPROX. PUMPING RATE (GAL. PER MIN.) 5
AVERAGE DAILY QUANTITY NEEDED (GAL. PER DAY) 400

USE FOR WATER (CIRCLE APPROPRIATE BOX)
D HOME (SINGLE OR DOUBLE HOUSEHOLD UNIT ONLY)
F FARMING (LIVESTOCK WATERING & AGRICULTURAL IRRIGATION)
I INDUSTRIAL, COMMERCIAL, STATE AND FEDERAL GOV. OTHER (REQUIRES APPROPRIATION PERMIT)
P PUBLIC OR PRIVATE WATER COMPANY (REQUIRES APPROPRIATION PERMIT AND STATE HEALTH DEPARTMENT APPROVAL)
T TEST, OBSERVATION, MONITORING (MAY REQUIRE APPROPRIATION PERMIT)

NOT TO BE FILLED IN BY DRILLER
HEALTH DEPARTMENT APPROVAL
Howard
COUNTY NAME
RW 468H
COUNTY NO.
STATE SIGNATURE
DATE ISSUED 02/12/91
CO SIGNATURE Mark E. Rifkin 8/12/91
NORTH GRID 521000
EAST GRID 0796000

APPROXIMATE DEPTH OF WELL 200 FEET
APPROXIMATE DIAMETER OF WELL 6 INCH

METHOD OF DRILLING (circle one)
BORED (or Augered) JETTED Jetted & DRIVEN
AIR-ROTARY AIR-PERCussion ROTARY (Hydraulic Rotary)
CABLE REVerse-ROTary Drive-POINT
other

REPLACEMENT OR DEEPEINED WELLS
(CIRCLE APPROPRIATE BOX)
N THIS WELL WILL NOT REPLACE AN EXISTING WELL
Y THIS WELL WILL REPLACE A WELL THAT WILL BE ABANDONED AND SEALED
THIS WELL WILL REPLACE A WELL THAT WILL BE USED AS A STANDBY
D THIS WELL WILL DEEPEIN AN EXISTING WELL
PERMIT NUMBER OF WELL TO BE REPLACED OR DEEPEINED (IF AVAILABLE) 41

SHOW MAJOR FEATURES OF BOX & LOCATE WELL WITH AN X
SOURCES OF DRILLING WATER
1. City
2.
3.
WRITE THE BOX NUMBER FROM THE MAP HERE
7906
5201
2/26/91 9:30-10:00
14 BAGS GROUT
87' CASING NOT OBS'D
85' GROUT
1 1/2' CASING
LOC. OK A.G.
VTAG OK
MR 2/26/91 Well

Not to be filled in by driller (OEP USE ONLY)
APPROP. PERMIT NUMBER
FORCE INITIALS IN BOX PERMIT NO. 40-88-1665
SPECIAL CONDITIONS
Tom Venezia H-442-1447

DRAW A SKETCH BELOW SHOWING LOCATION OF WELL IN RELATION TO NEARBY TOWNS AND ROADS AND GIVE DISTANCE FROM WELL TO NEAREST ROAD JUNCTION.
N
Sharp Road
21 FEB 1991 SHARP ROAD well
HEALTH DEPT
MONTGOMERY COUNTY
RECEIVED
X old well
Tobias

WATER WELL ABANDONMENT-SEALING REPORT FORM

SUBMIT COPIES OF COMPLETED FORM TO:

- * COUNTY ENVIRONMENT AGENCY (contact MDE, WMA if address needed)
- * WELL OWNER
- * MDE, WATER MANAGEMENT ADMINISTRATION, WELL PROGRAM

DATE WELL ABANDONED: 4/4/01 (month/day/year)

* PERMIT NUMBER OF ABANDONED WELL (if any)

* PERMIT NUMBER OF REPLACEMENT WELL

* PERSON ABANDONING WELL: Tom Venezia

* OWNER'S NAME: Tom Venezia

* WELL LOCATION: 3920 Sharp Road

COUNTY: Howard
NEAREST TOWN: Glenwood
TAX MAP 21 BLOCK 107 PARCEL 107
SUBDIVISION: Mill
SECTION: 4 LOT: 4

MARYLAND GRID COORDINATES

BOX NUMBER E 116
N 521

WELL DRILLERS LICENSE NUMBER: _____
CIRCLE: MWD/MSD/MGD

000	000

SHOW WELL LOCATION
BY X WITHIN BOX

* TYPE OF WELL BEING ABANDONED:

☒ DRILLED ☐ JETTED
☐ BORED/AUGURED ☐ HAND DUG
☐ OTHER (specify) _____

* USE CODE:

☒ DOMESTIC ☐ MUNICIPAL/PUBLIC
☐ IRRIGATION ☐ INDUSTRIAL
☐ TEST/OBSERVATION

* TYPE OF CASING:

☒ STEEL ☐ PLASTIC
☐ CONCRETE ☐ OTHER (specify) _____

* SIZE OF CASING: 6 INCHES IN DIAMETER

* DEPTH OF WELL: 60± FEET DEEP

* WAS ANY CASING REMOVED? ☐ YES ☒ NO
if yes, length removed, in feet: _____

* WAS CASING RIPPED OR PERFORATED? ☐ YES ☒ NO

LOG OF SEALING MATERIAL

MATERIAL	FEET	
	FROM	TO
clean brick	60	40
6000 psi concrete mix	40	5
Pit to remain	5	0

SIGNATURE MASTER WELL DRILLER OR SUPERVISING SANITARIAN

Mark E. Rifkin 989 San MWD/MSD/MGD
LICENSE # _____ CIRCLE ONE


4/4/01
DATE

Meet Driller 2/7/91 10AM

REPLACEMENT WELL SITE INSPECTION

OWNER Tom Vepesa / 442-1447 / 766-7444 DATE REQUESTED 2/6/91
ADDRESS 3920 Sharp Rd DRILLER Kyker
Dill Subdivision Lot 4 WELL TAG# _____
COUNTY# _____

LOCATION DIAGRAM

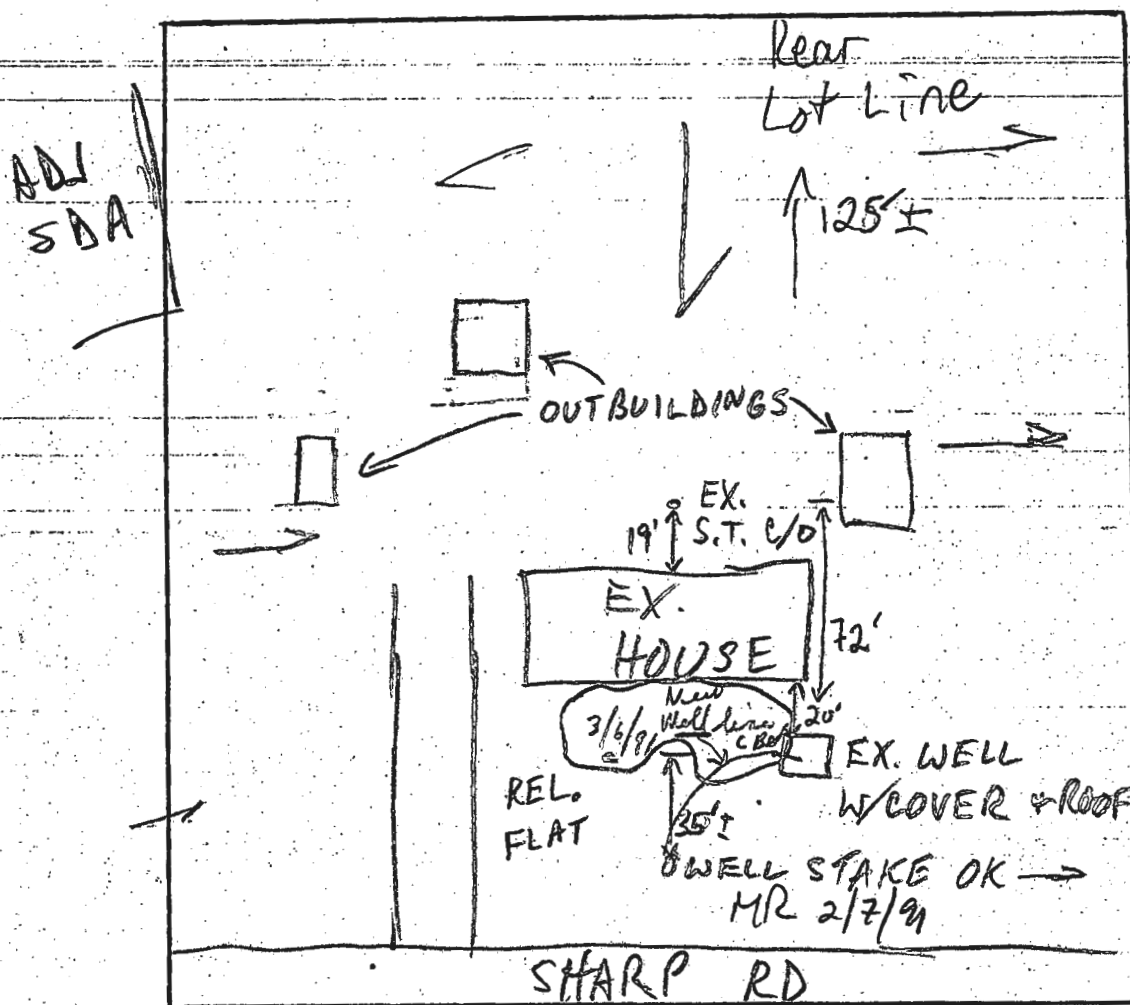

COMMENTS: 2/6/91 ~~THE~~ CONTAMINATION - NEEDS REPLACEMENT MR
2/7/91 OWNER NOT PRESENT, T/C W/ OWNER - FECAL CONTAM. SAMPLED TWICE
YCEHS 12/11/90 & 1/17/91; CONTAM. CONFIRMED; WELL IS 67'± DEEP;
CONTAM. POSS DUE TO PROXIMITY OF WELL TO S.T.; NEW SITE IN
FRONT DUE TO NEED FOR REPAIR AREA IN REAR, AND OWNER'S
DESIRE TO MINIMIZE WELL LINE COST. MR