


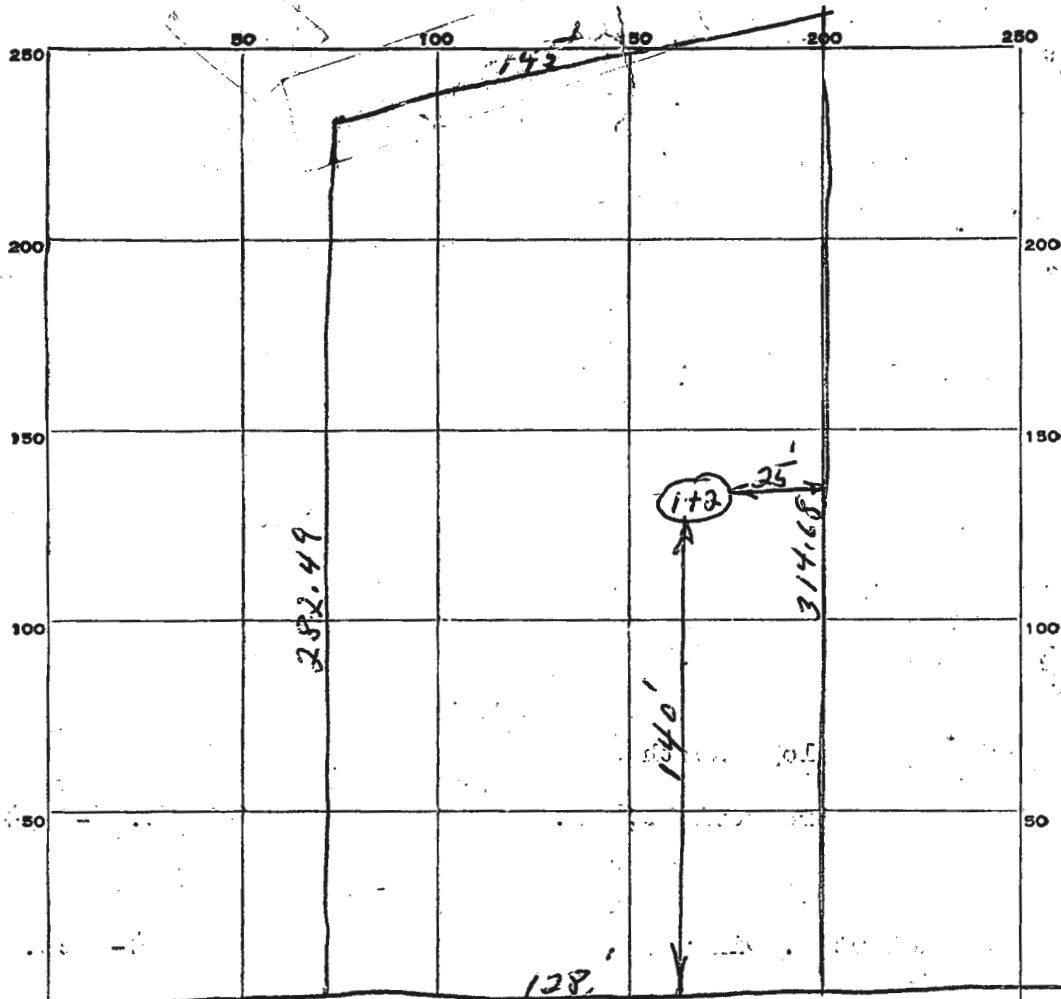

INDICATE NORTH. - NAME ADJOINING ROADWAY AS BASE LINE.

SHADY LANE

[illegible]

SOIL AUGER FINDING.

TESTED BY:

REMARKS.

1-15-63
ALSO PRESENT Floyd Heath LOT NO. 4-sec 3