

APPLICATION

PERCOLATION TESTING

HOWARD COUNTY HEALTH DEPARTMENT
BUREAU OF ENVIRONMENTAL HEALTH
P.O. BOX 476 ELLICOTT CITY, MARYLAND 21043
TELEPHONE: 461-9933

A 43007
P _____

DISTRICT 4
DATE 11-14-88

TO: THE COUNTY HEALTH OFFICER
ELLICOTT CITY, MARYLAND

I, HEREBY, APPLY FOR THE NECESSARY TEST IN ORDER TO CONSTRUCT (OR RECONSTRUCT) A SEWAGE DISPOSAL SYSTEM.

JOHN POND HAS BEEN TESTED AND IS NEXT TO "WATER" 6066" APRIL 1996
CHW

PROPERTY OWNER Rippeon
ADDRESS P.O. Box 122, Ellicott City PHONE _____
PROSPECTIVE BUYER Carman Associates
ADDRESS Box 122, Ellicott City, 854-6219 PHONE _____

PROPERTY LOCATION:

SUBDIVISION Country Springs LOT NO. 4415
ROAD AND DESCRIPTION Bushy Park Road

TAX MAP 14 PARCEL # 12
SIZE OF LOT 3.0+ acres TYPE BLDG. SFD
(SINGLE FAMILY DWELLING OR COMMERCIAL)

THE SYSTEM INSTALLED UNDER THIS APPLICATION IS ACCEPTABLE ONLY UNTIL PUBLIC FACILITIES BECOME AVAILABLE. I FULLY UNDERSTAND THE FEE CONNECTED WITH THE FILING OF THIS PERC TEST APPLICATION IS NON-REFUNDABLE UNDER ANY CIRCUMSTANCES. I ALSO AGREE TO COMPLY WITH ALL M.O.S.H.A. REQUIREMENTS IN TESTING THIS LOT.

(SIGNATURE OF APPLICANT)

APPROVED BY _____ FOR _____ DATE _____

REJECTED BY _____ FOR _____ DATE _____

HOLD PENDING FURTHER TESTS _____ DATE _____


REASONS FOR REJECTION OR HOLDING 11-15-88 Per Satisfactory - hold for PERC. Sahr

HD-216

THIS IS NOT A PERMIT

SOIL PROFILE

0	AP
6"	Yellow BR Silty CLAY loam 10-15% Frap
4.0	Yellow BR Silty SAND loam 20-25% Frap
4.5	

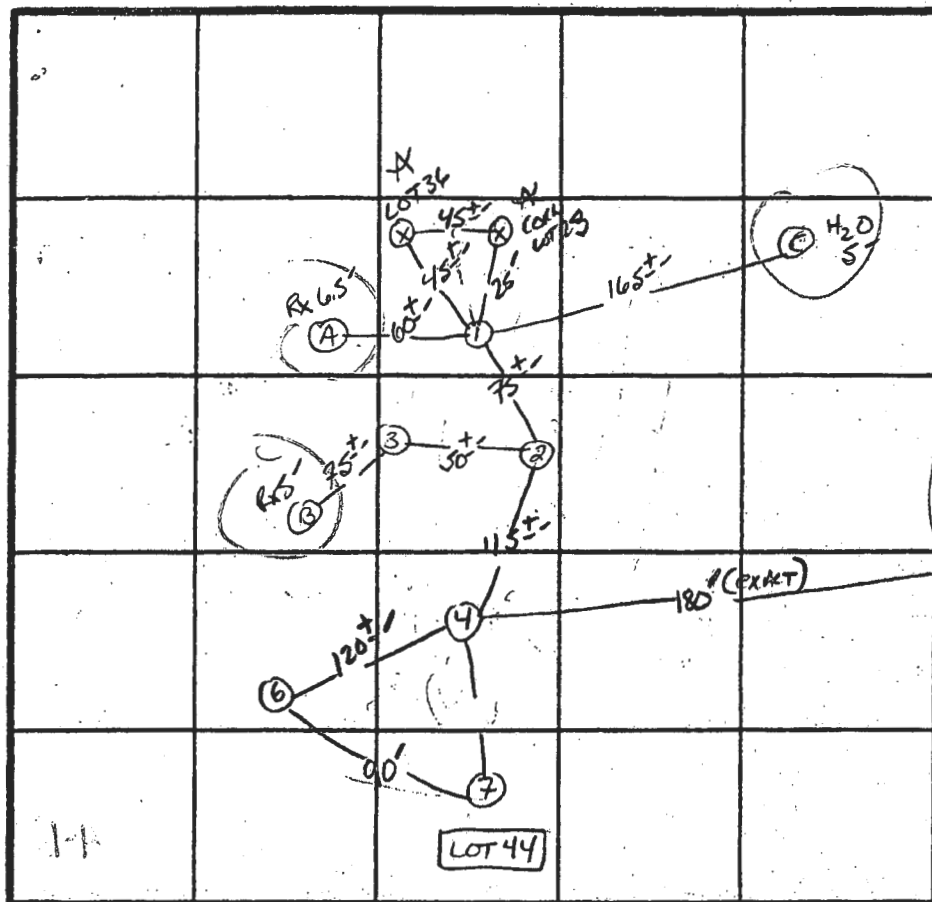

INDICATE NORTH - NAME ADJOINING ROADWAY AS BASE LINE.
BUSBY PARK Rd.

0	AP
6"	RED BR Silty CLAY loam 100% Frap
3.5	RED BR Silty SAND loam 15-20% Frap
13"	

DATE	TEST NO.	DEPTH	PRE-WET		TEST - 1" DROP		TIME
			START	STOP	START	STOP	
11/16/88	1 S	4.5'	10:33	10:48	10:48	11:14	26 min
	2 S	4.5'	10:39	10:44	10:44	10:55	11 min
	3 S	4.5'	10:42	10:59	10:59	11:32	33 min
	3 A	9.0'	10:42	10:56	10:56	11:20	24 min
	3 V	13'	Similar to Profile		Frap 30-	35% AT 5'	
	4 S	4.0'	10:49	10:52	10:52	10:57	5 min
	4 V	13'	AS profiled				
	6 S	4.0'	11:04	11:07	11:07	11:12	5 min
	6 V	13'	Similar to Profile #1				
	7 S						
	7 V						
	A	RX 6.5' CLAY 6.5'					
	B	RX 5.0' STR. 3.5'					
	C	H ₂ O 5' MOTTLES AT 3'					

REMARKS Shallow, Syst only - Holes NOT for PWT

TYPE OF SOIL Chert

TESTED BY S. Noel ALSO PRESENT Phil, Andrews,

Ruby, C. L. S. C.


 DENOTES SERVICE ESMT. (INSTALLATION AREA)
 ON LOT 14 FOR THE EXCLUSIVE USE;
 BENEFIT OF LOT 13 (APPROVED HON. CO. HEALTH DEPT.)

 DENOTES ACCESS ESMT. ON LOT 14 FOR THE
 EXCLUSIVE USE; BENEFIT OF LOT 15 FOR
 INCREASED BENEFIT OF SERVICE ESMT.
 (APPROVED HONOR. CO. HEALTH DEPT.)

 DENOTES SEPTIC RESERVE AREA
 SHOWN ON RECORD PLAN # 9650
 TO BE APPROPRIATED.

31.3

NOTE: ELEVATION SHOWN
~~FOR THE~~
 COUNTRY SURROUNDING
 PRELIMINARY PLAN

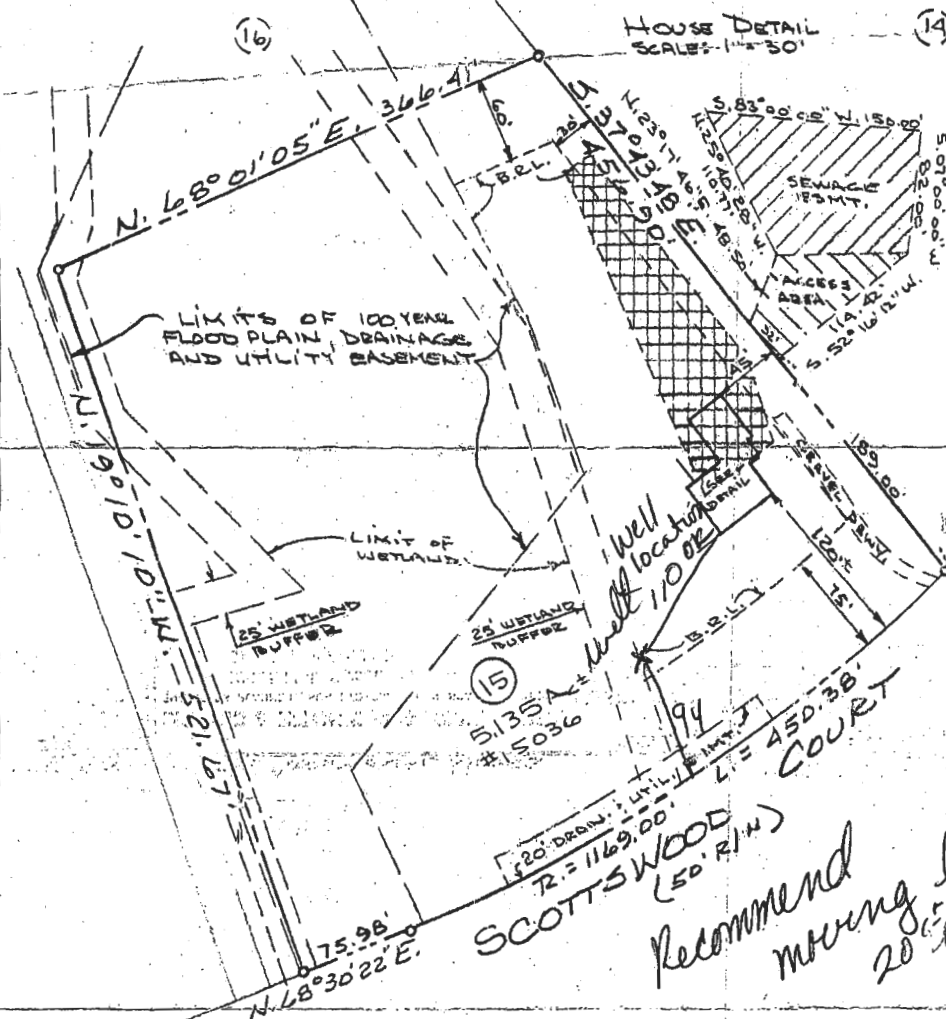

THIS IS TO CERTIFY THAT THE LAND SHOWN
HEREON IS NOT WITHIN THE FLOOD ZONES
AS SHOWN ON THE FLOOD INSURANCE
RATE MAPS AS PUBLISHED, DEC. 4, 1986



SEE REVERSE FOR ADDITIONAL NOTES



MORRIS & RITCHIE ASSOCIATES, INC.
ENGINEERS, PLANNERS, SURVEYORS, AND LANDSCAPE ARCHITECTS
139 N. Main Street, Suite 200
Bel Air, Maryland 21014
(410) 879-1690 - (410) 836-7560
Fax: (410) 879-1820

LOCATION TOP OF LINDSAY
LOT 10
RIPPLE - 142 1/2 ACRES
COUNTRY STORE
TOTAL 110 ACRES
MONTANA 59701

SCALE: 1" = 100'

DATE: 3-1-00

DRAWN BY: *GR*

DESIGN BY:

REVIEW BY: *GC*

JOB NO.: 10647

BK.#1 Pg#44

UPDATES: 7-12-00 (FIN. FL. ELEV. ONLY)

copy of Signed
Relinquishment



EX. POND
TO BE IMPROVED TO COMPLY
WITH CURRENT SCS
REQUIREMENTS

FAILED
3' x 3' x 2' GABION CHECK
DAM FOR WATER
QUALITY

WETLAND

WOOD COURT

100 YEAR FLOODPLAIN
DRAINAGE UTILITY
BASEMENT

SECTION