

DEPARTMENT OF INSPECTIONS, LICENSES AND PERMITS 3430 COURT HOUSE DRIVE ELLICOTT CITY, MD 21043 PERMITS (410) 313-2455 INSPECTIONS (410) 313-1810 AUTOMATED INFORMATION (410) 313-3800	HOWARD COUNTY PERMIT APPLICATION	PERMIT NUMBER B07003637
---	-------------------------------------	----------------------------

Building Address 13011 Wainwright Rd	Property Owner's Name
Suite/Apt. #: SDP/WP/Petition #:	Address
Census Tract Subdivision	City State Zip Code
Section Area Lot	Home Phone Work Phone
Tax Map Parcel Grid	Applicant's Name & Mailing Address, (if other than stated herein):
Zoning Map Coordinates Lot size	Phone Fax
Existing Use	Contractor Company Home owner to Contractor for
Proposed Use	Contact Person Self
Estimated Construction Cost \$	Address
Description of Work	City State Zip Code
	License No. Phone Fax
Occupant or Tenant	Engineer or Architect Company N/A
Contact Name	Contact Person
Address	Address
City State Zip Code	City State Zip Code
Phone Fax	Phone Fax

BUILDING DESCRIPTION - COMMERCIAL		BUILDING DESCRIPTION - RESIDENTIAL	
Building Characteristics	Utilities	Building Characteristics	Utilities
Height:	Water Supply: Public Private	SF Dwelling Depth Width	Water Supply: Public Private
No. of stories:	Sewage Disposal: Public Private	1st floor:	Sewage Disposal: Public Private
Gross area, sq. ft. per floor:	Electric Yes No Gas Yes No	2nd floor:	Electric Yes No Gas Yes No
Use group:	Heating System: Electric Oil Natural Gas Propane Gas	Basement:	Heating System: Electric Oil Natural Gas Propane Gas
Construction type: Reinforced Concrete Structural Steel Masonry Wood Frame State Certified Modular	Sprinkler system: N/A Full Partial Other Suppression # of Heads	Finished Basement Unfinished Basement Crawl space Slab on Grade No. of Bedrooms Height: Multi-family dwellings: No. of efficiency units: No. of 1 BR units: No. of 2 BR units: No. of 3 BR units: Other Structure: Dimensions: Footings: Roof Height: State Certified Modular Manufactured Home	Sprinkler system: N/A NFPA #13D NFPA #13R Other:

THE UNDERSIGNED HEREBY CERTIFIES AND AGREES AS FOLLOWS: (1) THAT HE/SHE IS AUTHORIZED TO MAKE THIS APPLICATION; (2) THAT THE INFORMATION IS CORRECT; (3) THAT HE/SHE WILL COMPLY WITH ALL REGULATIONS OF HOWARD COUNTY WHICH ARE APPLICABLE THERETO; (4) THAT HE/SHE WILL PERFORM NO WORK ON THE ABOVE REFERENCED PROPERTY NOT SPECIFICALLY DESCRIBED IN THIS APPLICATION; (5) THAT HE/SHE GRANTS COUNTY OFFICIALS THE RIGHT TO ENTER ONTO THIS PROPERTY FOR THE PURPOSE OF INSPECTING THE WORK PERMITTED AND POSTING NOTICES.

Applicant's Signature	Print Name
Title/Company	Date

Checks payable to: DIRECTOR OF FINANCE OF HOWARD COUNTY
** PLEASE WRITE NEATLY AND LEGIBLY. **
- FOR OFFICE USE ONLY -


AGENCY	DATE	SIGNATURE APPROVAL	DPZ SETBACK INFORMATION	PROPERTY ID#
Land Development, DPZ			Front: Filing fee \$	
State Highways			Rear: Permit fee \$	
Building Official			Side: Excise tax \$	
Dev. Engineering, DPZ			Side St.: Add'l per. fee \$	
Health 3/4/2008 RBurke			All minimum setbacks met? YES NO	
Fire Protection			Is Entrance Permit required? YES NO	
Is Sediment Control approval required prior to issuance? YES NO			Historic District? YES NO	
CONTINGENCY CONSTRUCTION START: ONE STOP SHOP:			Lot Coverage for New Town Zone	
Distribution of Copies: White: Building Official Green: LDD, DPZ Yellow: DED, DPZ Pink: Health Gold: SHA			SDP/Red-line approval date	Accepted by

11. THIS PLAT IS OF BENEFIT TO A CONSUMER ONLY INsofar AS IT IS REQUIRED BY A LENDER OR TITLE INSURANCE COMPANY OR ITS AGENT IN CONNECTION WITH CONTEMPLATED TRANSFER, FINANCING, OR REFINANCING.

3. THIS PLAT DOES NOT PROVIDE FOR THE ACCURATE IDENTIFICATION OF PROPERTY BOUNDARY LINES, BUT SUCH IDENTIFICATION MAY NOT BE REQUIRED FOR THE TRANSFER OF TITLE OR SECURED FINANCING OR REFINANCING.

4. ACCURACY OF BUILDING MEASUREMENTS: 0.1'
5. ACCURACY OF SETBACK DIMENSIONS: 0.5'
6. ACCURACY OF ELEVATIONS: 0.1'

THE PROPERTY SHOWN HEREON
LIES IN ZONE C AS SHOWN ON
FLOOD INSURANCE MAP NO.
NO: 240044 0037
DATED: DEC. 4, 1966

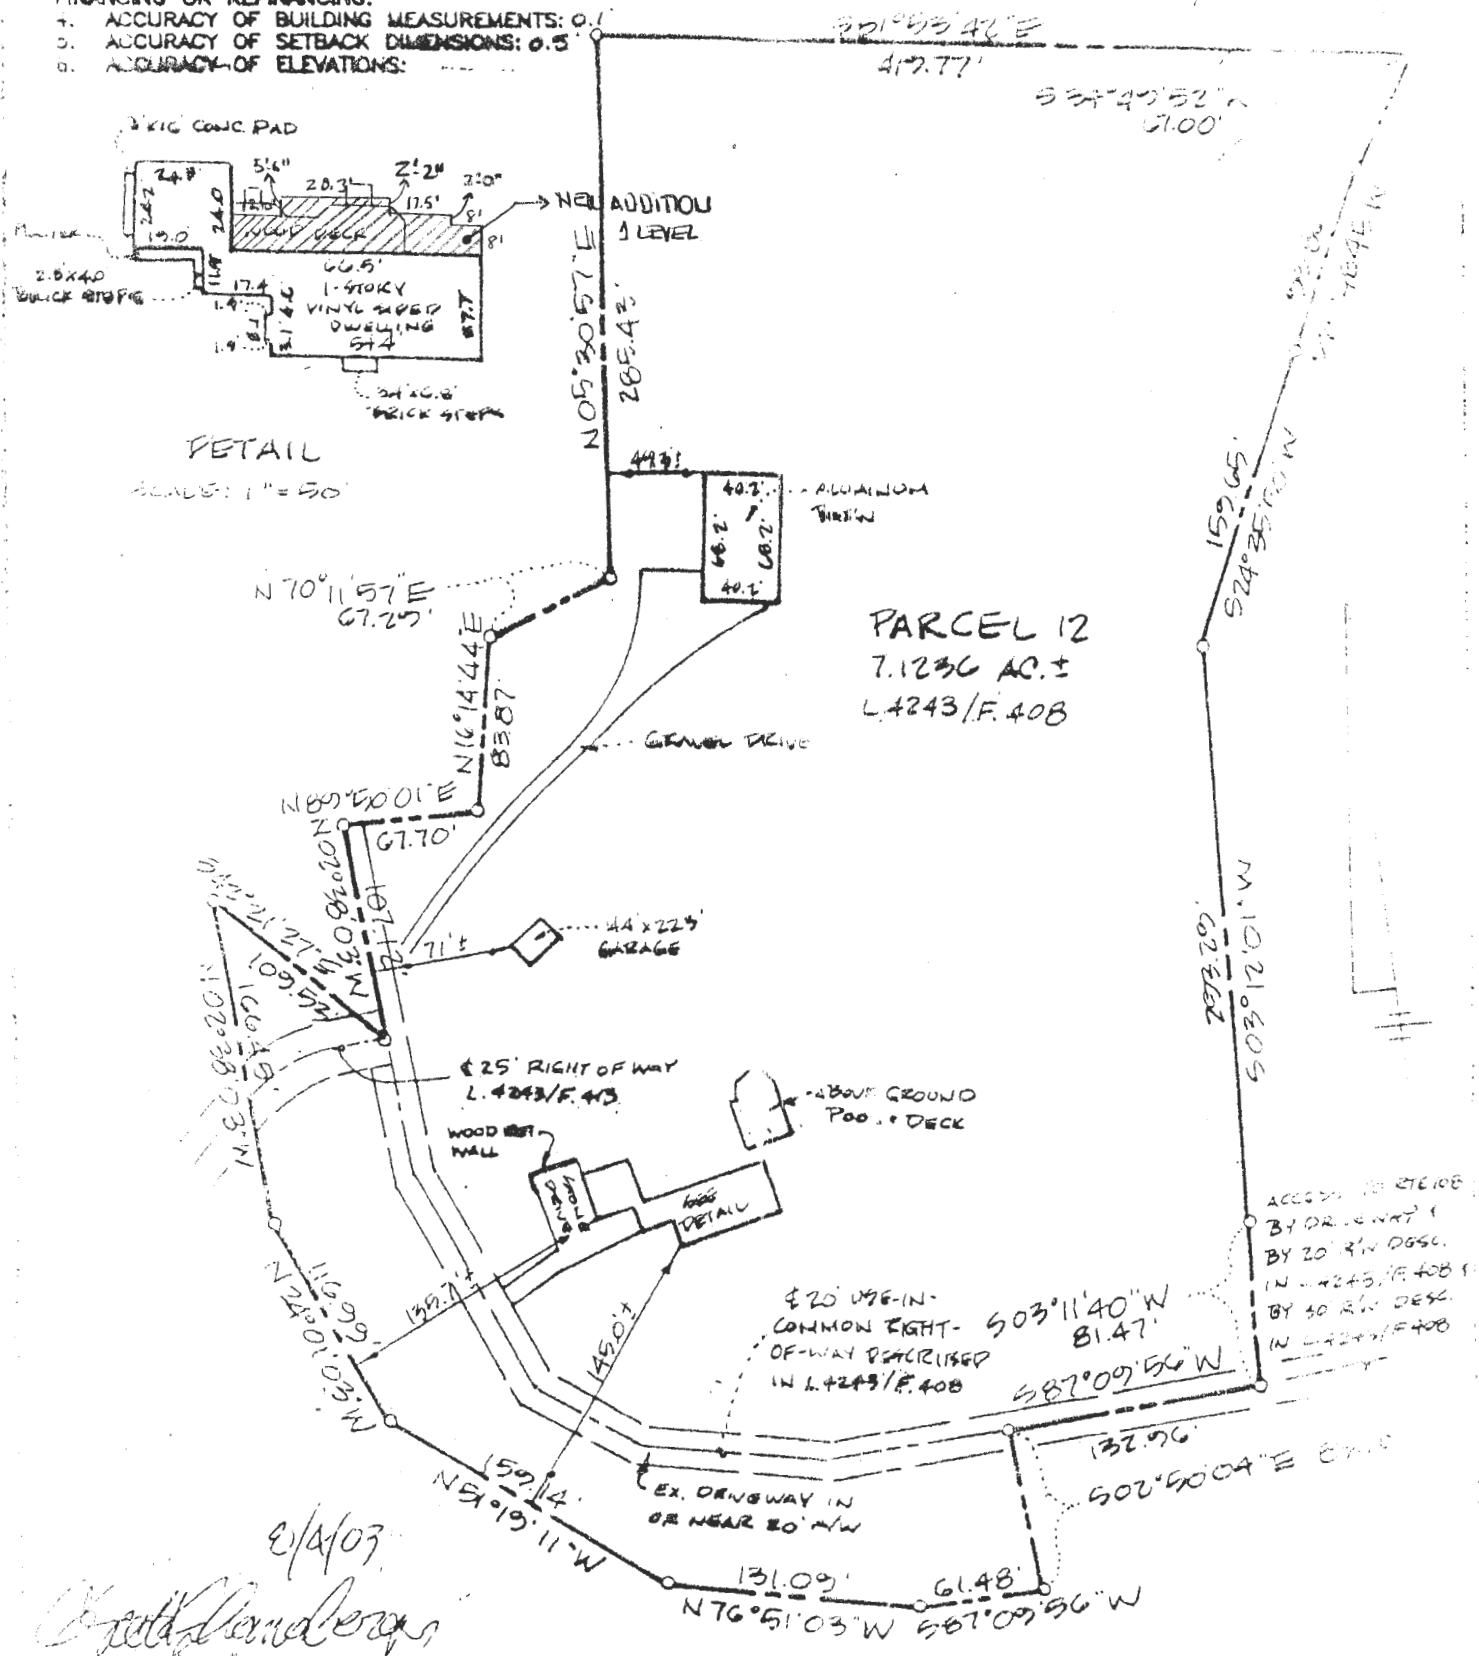

I HEREBY CERTIFY THAT I HAVE LOCATED THE IMPROVEMENTS AS SHOWN. THIS PLAT DOES NOT REPRESENT A BOUNDARY SURVEY AND CANNOT BE USED TO ESTABLISH PROPERTY LINES OR CORNERS.

L.4243/F.408

ELECTION DISTRICT: 5TH
COUNTY: HOWARD
SCALE: 1"=100'
DATE: 9/3/03

SHANABERGER • LANE
8722 TOWN • COUNTRY BLVD.
SUITE 201
ELLCOTT CITY, MD. 21043
(410)461-9563 FAX:461-9698

7. All fixtures and improvements are to remain
8. The residence will have 3 bedrooms Total after completion of addition
9. Existing total trench length is 123 feet which exceeds required length (Howard County Code 2006) by 65 feet.

NOTES

1. ALL EXISTING WELLS ON THE SUBJECT PROPERTY AND WITHIN 100 FEET OF SUBJECT PROPERTY BOUNDARIES ARE REPRESENTED TO THE BEST OF MY KNOWLEDGE AND BELIEF.
2. TOPOGRAPHY ON THIS PLAT IS FROM THE BUILDING PERMIT APPLICATION SITE PLAN FOR THE EXISTING RESIDENCE AND IS VERIFIED TO ACCURATELY REPRESENT THE RELATIVE ELEVATION CHANGES ON THE SUBJECT PROPERTY IN THE VICINITY OF THE DESCRIBED SEPTIC EASEMENT.
3. THE LOT SHOWN HEREON COMPLIES WITH THE MINIMUM OWNERSHIP WIDTH AND LOT AREA AS REQUIRED BY THE MARYLAND DEPARTMENT OF ENVIRONMENT.
4. ANY CHANGES TO A PRIVATE SEWAGE EASEMENT SHALL REQUIRE A REVISED PERCOLATION CERTIFICATION PLAN.
5. THIS AREA DESIGNATES A PRIVATE SEWAGE EASEMENT AS REQUIRED BY THE MARYLAND DEPARTMENT OF ENVIRONMENT FOR INDIVIDUAL SEWAGE DISPOSAL. IMPROVEMENTS OF ANY NATURE IN THIS EASEMENT ARE RESTRICTED. THIS EASEMENT SHALL BECOME NULL AND VOID UPON CONNECTION TO A PUBLIC SEWERAGE SYSTEM. THE COUNTY HEALTH OFFICER SHALL HAVE AUTHORITY TO GRANT ADJUSTMENTS TO THE PRIVATE SEWAGE EASEMENT. RECORDATION OF A REVISED SEWAGE EASEMENT SHALL NOT BE NECESSARY.
6. THE AREA OF THIS LOT WAS FIRST PERCOLATION TESTED FOR SUBDIVISION IN MARCH 1974.

OWNER/DEVELOPER:

Harold Goldstein / Janet Young
13011 Wainwright Road
Highland, Maryland 20777

Mr. Harold Goldstein
Po Box 308
Highland, MD 20777-0308

mailing
address:

Plat No. PC19702
PERCOLATION CERTIFICATION PLAN
13011 WAINWRIGHT ROAD

I CERTIFY THAT THE INFORMATION SHOWN HEREON IS BASED ON WORK PERFORMED IN MY PRESENCE OR BY MY DIRECTION, AND IS CORRECT TO THE BEST OF MY KNOWLEDGE AND BELIEF.

(SIGNATURE)

(DATE)


APPROVED FOR PRIVATE WATER AND PRIVATE SEWERAGE SYSTEMS.

B. Nyman for Peter Brilenson 2/29/2008

(SIGNATURE)

(DATE)

THIS PLAT IS NOT TO BE RELIED UPON FOR THE ESTABLISHMENT OR LOCATION OF FENCES, GARAGES, BUILDINGS, POOLS, BUILDING ADDITIONS OR OTHER EXISTING OR FUTURE IMPROVEMENTS.
THIS PLAT DOES NOT PROVIDE FOR THE ACCURATE IDENTIFICATION OF PROPERTY BOUNDARY LINES, BUT SUCH IDENTIFICATION MAY NOT BE REQUIRED FOR THE TRANSFER OF TITLE OR SECURED FINANCING OR REFINANCING.
1. ACCURACY OF BUILDING MEASUREMENTS: 0.1'
2. ACCURACY OF SETBACK DIMENSIONS: 0.3'
3. ACCURACY OF ELEVATIONS:

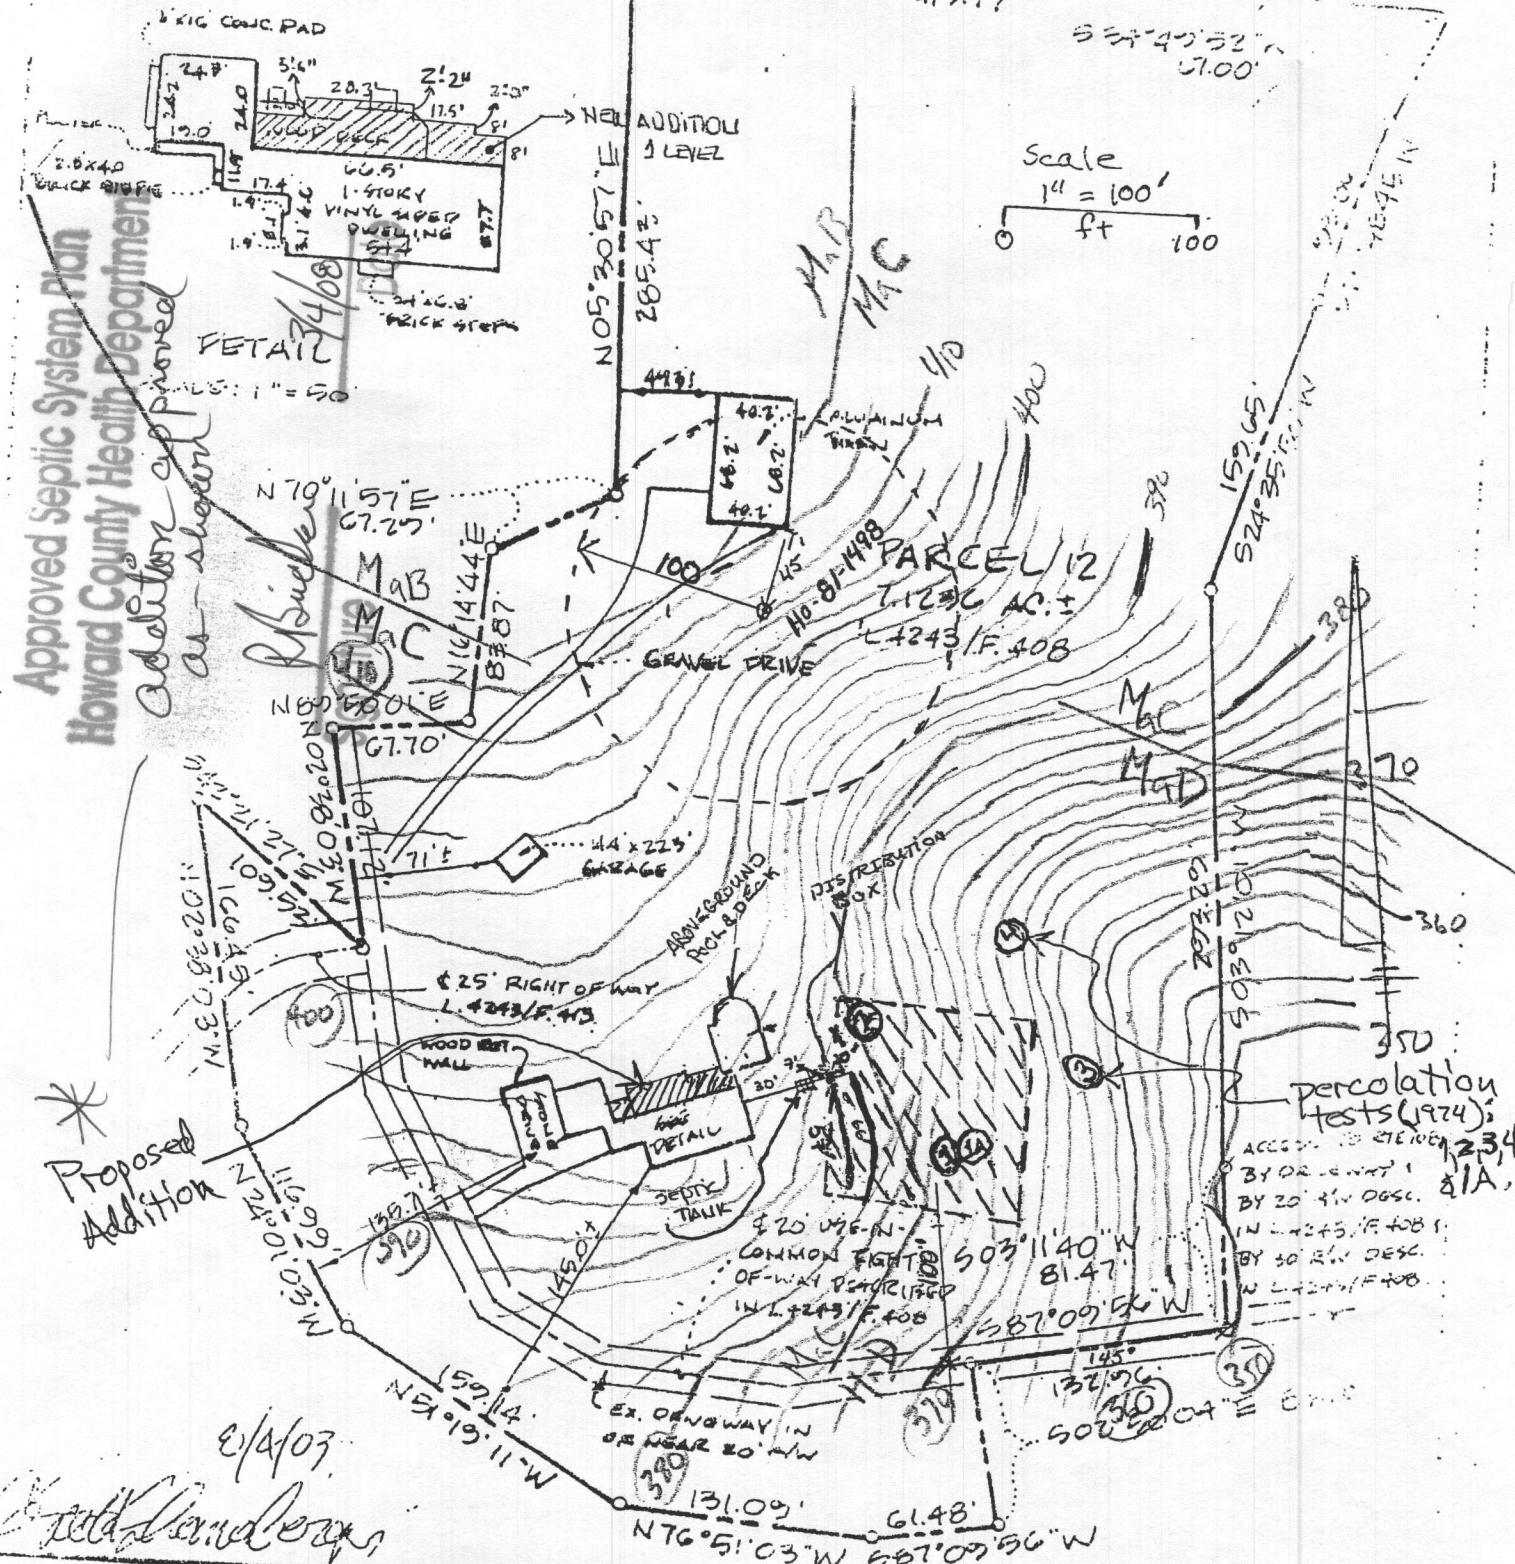


I HEREBY CERTIFY THAT I HAVE LOCATED THE IMPROVEMENTS AS SHOWN. THIS PLAT DOES NOT REPRESENT A BOUNDARY SURVEY AND CANNOT BE USED TO ESTABLISH PROPERTY LINES OR CORNERS.

FINAL LOCATION DRAWING

#13011 WAINWRIGHT RD.

PROPERTY OF
STEVEN G. & JOANNE M. COLLINS

EXIST./PROPOSED FIRST FLOOR PLAN
1/4"=1'-0"

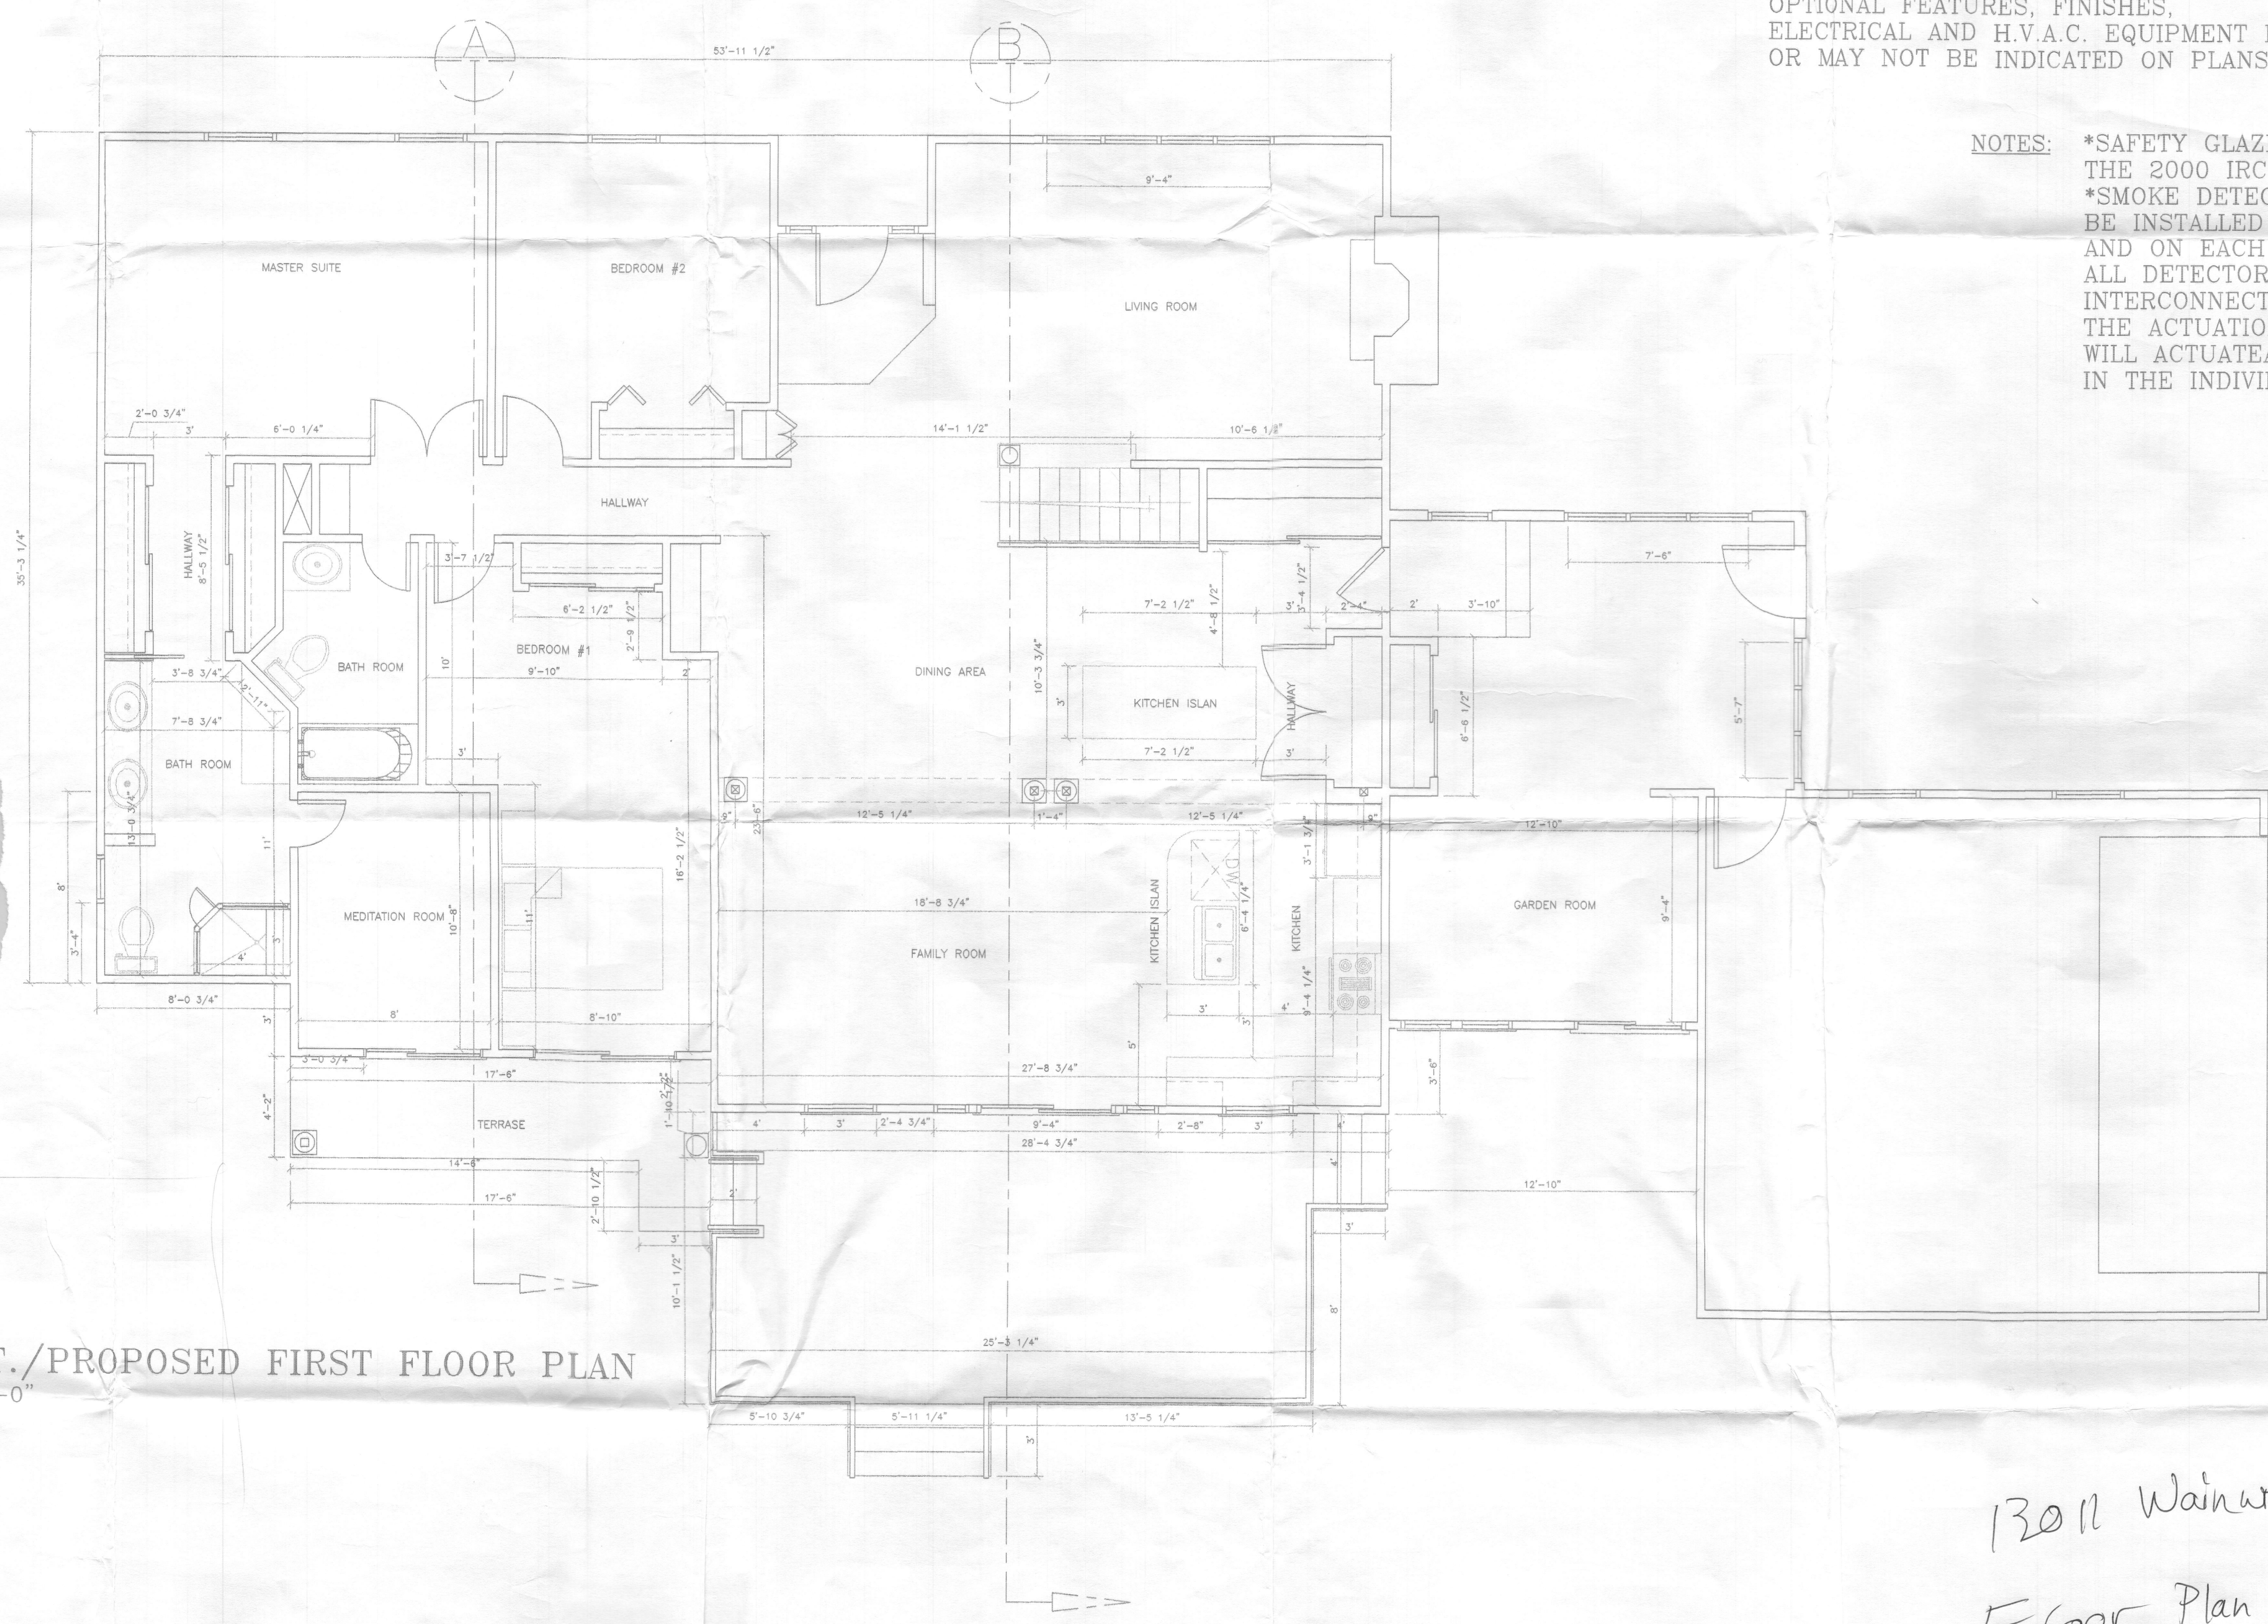

NOTE: THESE PLANS ARE FOR THE USE OF THE BUILDER IN FACILITATING CONSTRUCTION. ALL DIMENSIONS INDICATED ARE APPROXIMATE AND MAY VARY DUE TO ADJUSTMENTS REQUIRED IN THE FIELD. OPTIONAL FEATURES, FINISHES, ELECTRICAL AND H.V.A.C. EQUIPMENT MAY OR MAY NOT BE INDICATED ON PLANS.

NOTES: *SAFETY GLAZING TO MEET THE 2000 IRC CODE
*SMOKE DETECTORS SHALL BE INSTALLED IN EACH BEDROOM AND ON EACH FLOOR. ALL DETECTORS SHALL BE INTERCONNECTED SUCH THAT THE ACTUATION OF ONE ALARM WILL ACTUATE ALL THE ALARMS IN THE INDIVIDUAL UNIT.

13011 Wainwright
Floor Plan

A3	EXISTING FIRST FLOOR PLAN AND NEW FIRST FLOOR PLAN	13011 WAINWRIGHT RD. HIGHLAND, MARYLAND 20777 (Master Suite Addition and Kitchen Remodeling)	OWNER: MR. AND MRS. GOLDSTEIN BUILDER: DESIGN BY: DAMAT SERVICES INC.	DATE:	OCTOBER 02 - 2007 DRAWING BY: DAMAT Services Inc. Jorge Valverde
----	--	--	---	-------	--