
./	1-12 Lea APPLICATIO	N ( final 3) A 19/996
(	SEWAGE DISPOSAL TESTING	net 77 P
, ,	STATE OF MARYLAND - DEPARTMENT OF HEALTH	
	HOWARD COUNTY HEALTH DEPARTMENT	DISTRICT 5th
	ENVÌRONMENTAL HEALTH SERVICES  P. O. BÖX 476, ELLICOTT CITY, MARYLAND 21043	DATE 2-25-74
-	TELEPHONE: 465-5000, EXT. 358	( A)
4.222	127 July 100 128 Think Many 14 Pe	test possebly
	TO: THE COUNTY HEALTH OFFICER	
	ELLICOTT CITY, MARYLAND	
	I, HEREBY, APPLY FOR THE NECESSARY TEST IN ORDER TO CONDISPOSAL SYSTEM.	STRUCT (OR RECONSTRUCT) A SEWAGE
	Oskar Schulz Inc	
	PROPERTY OWNER Apple Development Company, Inc.	
	Address Box 145-A-RFD #1, I jamsy 11e, Md.	37/- 24-0 — PHONE 301/874-2835
į.	Highland, MAXXInnd/2077?	
	PROPERTY LOCATION: Highland Lake	ole -41 5 3 sec. 2
	SUBDIVISION Henry K. Owings Property	LOT NO. Lot -43 Phase 3
	ROAD AND DESCRIPTION Corner Road "E" Court "G"	Men Jot 124
	64 94 Miver Clyde Drive	
	SIZE OF LOT 42001 4+	TYPE BLDG. 3-4 B.R.
:	IF NOT SINGLE RESIDENCE DESCRIBE	NUMBER OF BEDROOMS
	/	
	THE SYSTEM INSTALLED UNDER THIS APPLICATION IS FACILITIES BECOME AVAILABLE.	ACCEPTABLE ONLY UNTIL PUBLIC
	SIGNATURE OF APPLICANT Kelly	
•	APPROVED BY Frank Sum FOR Drywell &	Let 11/26/82
	REJECTED BY	SYSTEMI
	HOLD PENDING FURTHER TESTS	SYSTEM) DATE
•	REASONS FOR REJECTION OR HOLDING	
		BLDG PERMIT SIGNED
		The following the second
•		Swif# 57739
/	THIS IS NOT A	PERMIT
	HILLS IN IAM I W	L F- NJ NA BI B

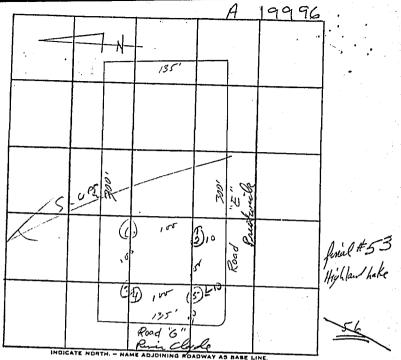

			TOASWAY AS BASE LINE.						
	DATE	TEST NO.	DEPTH	PRE-	WET	TEST -	" DROP STOP	TIME	I
	5/24/14	1	4/2)	, 12	15	115	124		. is
		سخ	101	112	,14	, 14	118	9-m	
		3	1131	118		<del>, '</del> :	,22	4m	4
		4	41	10			,21	3~	5 cm
			11/2/	2	Hem	3-11		7	-
		ا ما ً	12,1	Clan		L 51	/		
			7	1	7-0	<u> </u>	1		
									,:
wallpenic	73-	3712	42'ca	1e, 38/ 0	nsen	9 logs		10	- 0.00
				7=0		1 Kis-go	lovens	18	2-9-89
	REMARKS								

TYPE OF SOIL

TESTED BY RT.