

5/10/83  
p.m.

APPROVED  
5/10/83  
P 19996  
A 32335  
A 19996

# PERMIT

SEWAGE DISPOSAL SYSTEM

MARYLAND STATE DEPARTMENT OF HEALTH\*

HOWARD COUNTY  
BUREAU OF ENVIRONMENTAL HEALTH  
992-2330

ELLICOTT CITY

DISTRICT 5th

DATE Nov. 26, 1982

## INDEX

Oskar Schulz, Inc. IS PERMITTED TO INSTALL ☒ ALTER ☐  
ADDRESS 6610 Blackwatch Lane, Highland, Md. 20777 PHONE 988-9098  
SUBDIVISION High Lake Highland Lake ROAD 6605 Preswick Drive LOT 53, Soc.2  
PROPERTY OWNER Oskar Schulz, Inc. Robert Mc Grath  
ADDRESS 6610 Blackwatch Lane, Highland, Md.

IF GARBAGE GRINDER IS USED INCREASE SEPTIC TANK CAPACITY BY 50% AND ABSORPTION AREA BY 22%.

GARBAGE GRINDER? YES ☐ NO ☒

SEPTIC TANK CAPACITY 1250 GALLONS NUMBER OF BEDROOMS 4

125 sq. ft. per bedroom, inlet 4 ft. below original grade, max. depth 10 ft below

original grade. Effective area begins at 4 ft. below original grade.

NOTE: If trench is used to make up absorbent-area, run the trench on level ground and leave a 5 ft. earth buffer between drywell and trench. No trench is to exceed 100 ft.

in length. Trench inlet to be same as dry well, with 6 ft. of stone below distribution pipe. Call for inspection of trench before installing gravel in trench.

LOCATION: Place dry well 65 ft. from the right sideline and 135 ft. from the front lot line as seen when facing the lot from River Clyde Dr.

PLANS APPROVED BY Frank Skinner DATE 11/26/82

COVER NO WORK UNTIL INSPECTED AND APPROVED.

NEITHER THE HOWARD COUNTY COUNCIL NOR THE HEALTH DEPARTMENT IS RESPONSIBLE FOR THE SUCCESSFUL OPERATION OF ANY SYSTEM.

NOTE: IF TRENCH IS USED CALL FOR INSPECTION BEFORE AND AFTER PLACING GRAVEL IN TRENCH.

NOTE: NO DRY WELL SHALL EXCEED 15 FOOT IN DIAMETER. NO ABSORPTION TRENCH TO EXCEED 100 FEET IN LENGTH AND RETURNED 3/1/84

NOTE: ALL PIPE FROM HOUSE TO SEPTIC TANK MUST BE CAST IRON OR SCHEDULE 40 PVC OR ABS.


PERMIT VOID AFTER THREE YEARS.

NOTE: INSTALL STAND PIPE ON SEPTIC TANK AND DRY WELL. STAND PIPES MUST BE 6 INCHES IN DIAMETER, CAST IRON, CONCRETE OR TERRA COTTA, OR PVC OR ABS ACCEPTED. IF TOP OF SEPTIC TANK IS DEEPER THAN 3 FEET MANHOLE TO GRADE REQUIRED.

\*INSTALLER IS RESPONSIBLE FOR OBTAINING FINAL APPROVAL ON THIS PERMIT

\*CALL 992-2330 FOR INSPECTION OF SEPTIC SYSTEMS.

EH - 2-1082

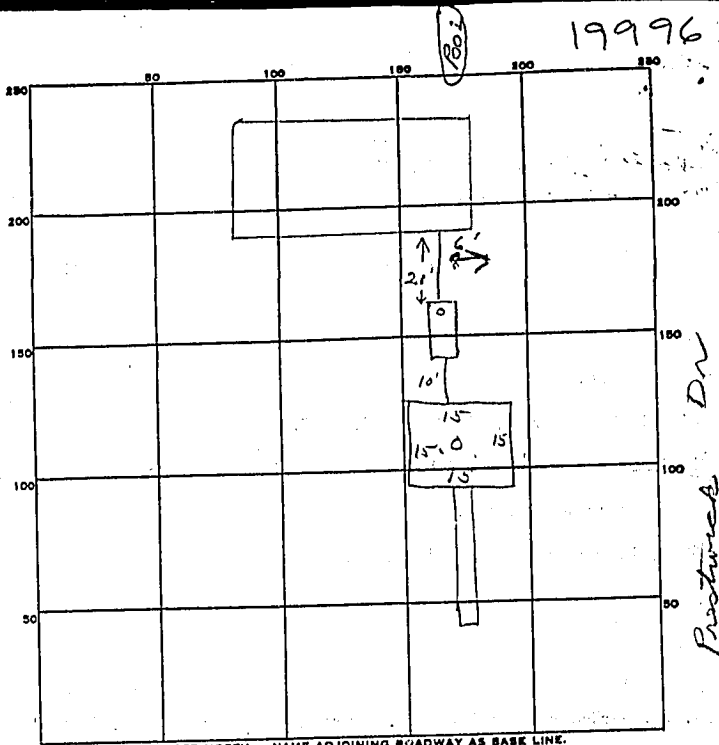

PERMIT CARD \_\_\_\_\_

SEPTIC TANK, LEVEL ✓ 1500 gal CLEANOUTS ST/DW

DISTRIBUTION BOX, LEVEL \_\_\_\_\_

TILE FIELD, DEPTH 10 FT. TRENCH WIDTH 2 FT.

GRAVEL DEPTH 6 FT IN. TOTAL LENGTH 49 FT.

NUMBER OF TRENCHES 1 TOTAL BOTTOM AREA 294

SEEPAGE PITS, INSIDE DIAMETER 6.0 FT. DEPTH BELOW INLET 6 FT.

ABSORBENT AREA 360 SQ. FT.

REMARKS 5/9/83 OK to cover trench to trench. OK to add  
stone in trench. 18

5/10/83 - STONE ADDED TO D11C1

360 + 294 = 654 SQ FT 0

500 SQ FT REQUIRED BY

DATE SYSTEM APPROVED 5/10/83

INSPECTOR Raymond Hodge