

APPLICATION

PERCOLATION TESTING

A 40875

P _____

HOWARD COUNTY HEALTH DEPARTMENT
BUREAU OF ENVIRONMENTAL HEALTH
P.O. BOX 476 ELLICOTT CITY, MARYLAND 21043
TELEPHONE: 461-9933

DISTRICT Fourth

DATE 12-15-87

TO: THE COUNTY HEALTH OFFICER
ELLICOTT CITY, MARYLAND

I, HEREBY, APPLY FOR THE NECESSARY TEST IN ORDER TO CONSTRUCT (OR RECONSTRUCT) A SEWAGE DISPOSAL SYSTEM.

PROPERTY OWNER Long Meadow Venturers STEVEN & JACQUELINE MANTUA

ADDRESS 7050 Oakland Mills Road Suite 100 PHONE 301-290-9494

PROSPECTIVE BUYER Columbia, MD 21046

ADDRESS Attention: Mr. Earl Armiger PHONE _____

PROPERTY LOCATION:

SUBDIVISION Foxmoor LOT NO. 22 LOT 10 Preliminary

ROAD AND DESCRIPTION End of Timberleigh Way (17700 Quail Covey Court)

TAX MAP 12 PARCEL # 16

SIZE OF LOT 3.0 Acres TYPE BLDG Single Family - 1/2 Bm
(SINGLE FAMILY DWELLING OR COMMERCIAL)

THE SYSTEM INSTALLED UNDER THIS APPLICATION IS ACCEPTABLE ONLY UNTIL PUBLIC FACILITIES BECOME AVAILABLE. I FULLY UNDERSTAND THE FEE CONNECTED WITH THE FILING OF THIS PERC TEST APPLICATION IS NON-REFUNDABLE UNDER ANY CIRCUMSTANCES. I ALSO AGREE TO COMPLY WITH ALL M.O.S.H.A. REQUIREMENTS IN TESTING THIS LOT.

(SIGNATURE OF APPLICANT)

APPROVED BY Ed Abel FOR Standard Times DATE 2-21-89

REJECTED BY _____ FOR _____ DATE _____

HOLD PENDING FURTHER TESTS _____ DATE _____


REASONS FOR REJECTION OR HOLDING 3-8-88 Per SATISFACTORY - Hold for PLAT SAG

Shallow Syst. TOP SEAM SPILL TANK, PEACE TANK IN High hole of Rope Field. (SA) 6-8-88 Per. holes to ADD Area or Subdivide FURTHER. SAG

THIS IS NOT A PERMIT

SOIL PROFILE

AP
Yell Br clayey loam.
20-25% frags
Yell Br to Brown silty loam.
35-45% frags
50% L
hole 2 at 11'

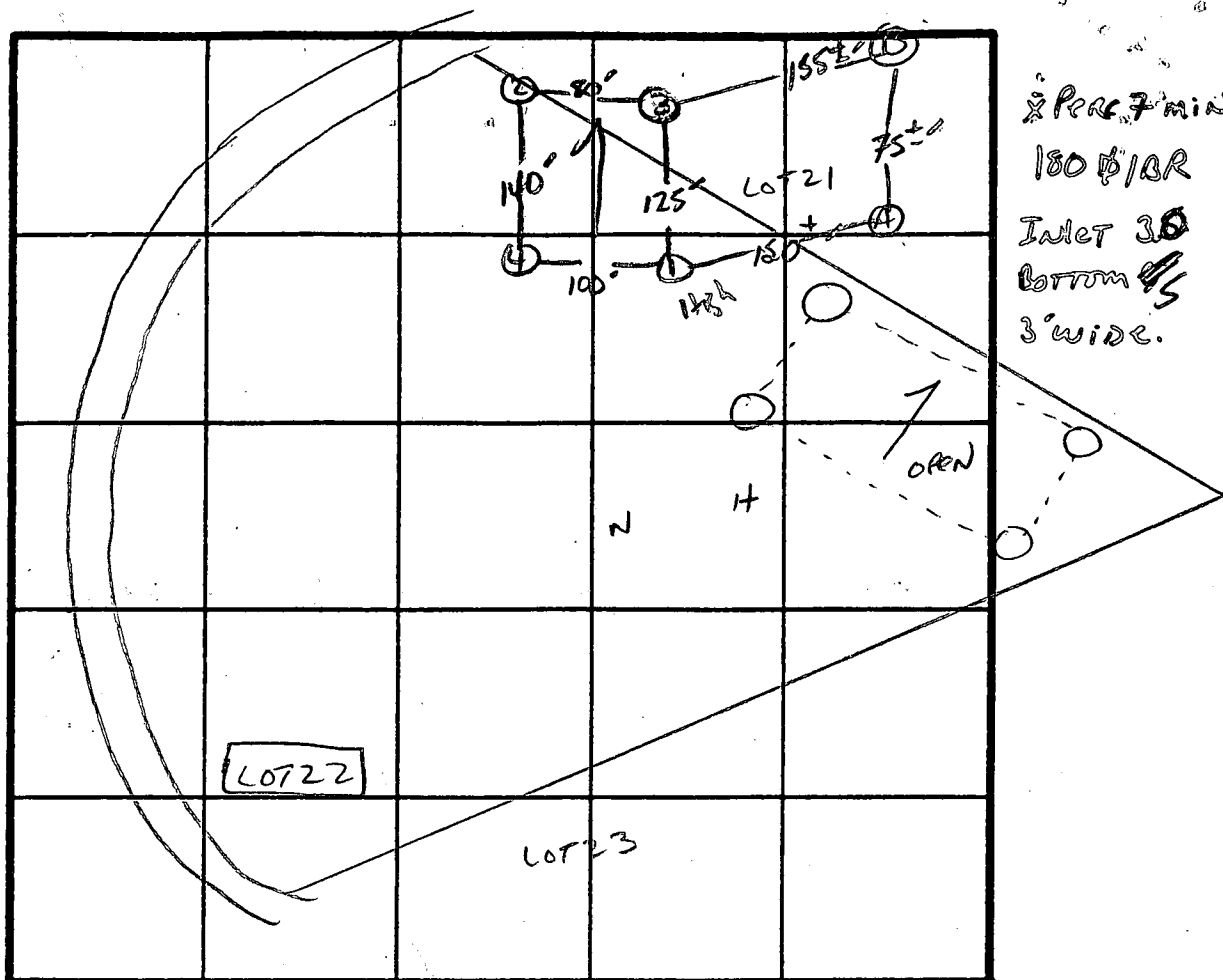

X = LOT 10

XX = LOT 9

INDICATE NORTH - NAME ADJOINING ROADWAY AS BASE LINE.


FLORENCE

DATE	TEST NO.	DEPTH	PRE-WET		TEST - 1" DROP		TIME
			START	STOP	START	STOP	
3/4/68	X 1S	4.5-8.0'	3:06	3:07	3:07	3:11	4 min
			2:39	3:02	3:02	3:09	7 min
	X 1V	11' HAND BOTTOM					
	2S	5'-8'	2:38	2:39	2:37	2:41	4 min
			2:37	2:43	2:43	2:55	12 min
	2V	12'	See profile				
	X 3S	4.5-8.5	2:44	2:46	2:46	2:51	5 min
			2:44	2:49	2:49	2:55	6 min
	X 3V	11.5	Same as #2				
	4S	4'-7.5'	3:12	3:14	3:14	3:19	5 min
			3:13	3:15	3:15	3:19	4 min
	4V	11'	HAND BOTTOM - MASSIVE		AT 10'		
6/8/68	X AS (12)	4'-8'	2:00	2:02	2:02	2:06	4 min
			2:02	2:03	2:03	2:06	3 min
	X BV	12' uniform soil below	3.0'				

REMARKS Notes Diff from last - Shallow Spst. only

TYPE OF SOIL Mt Ariz

TESTED BY S. Abel ALSO PRESENT Kenny - Drive

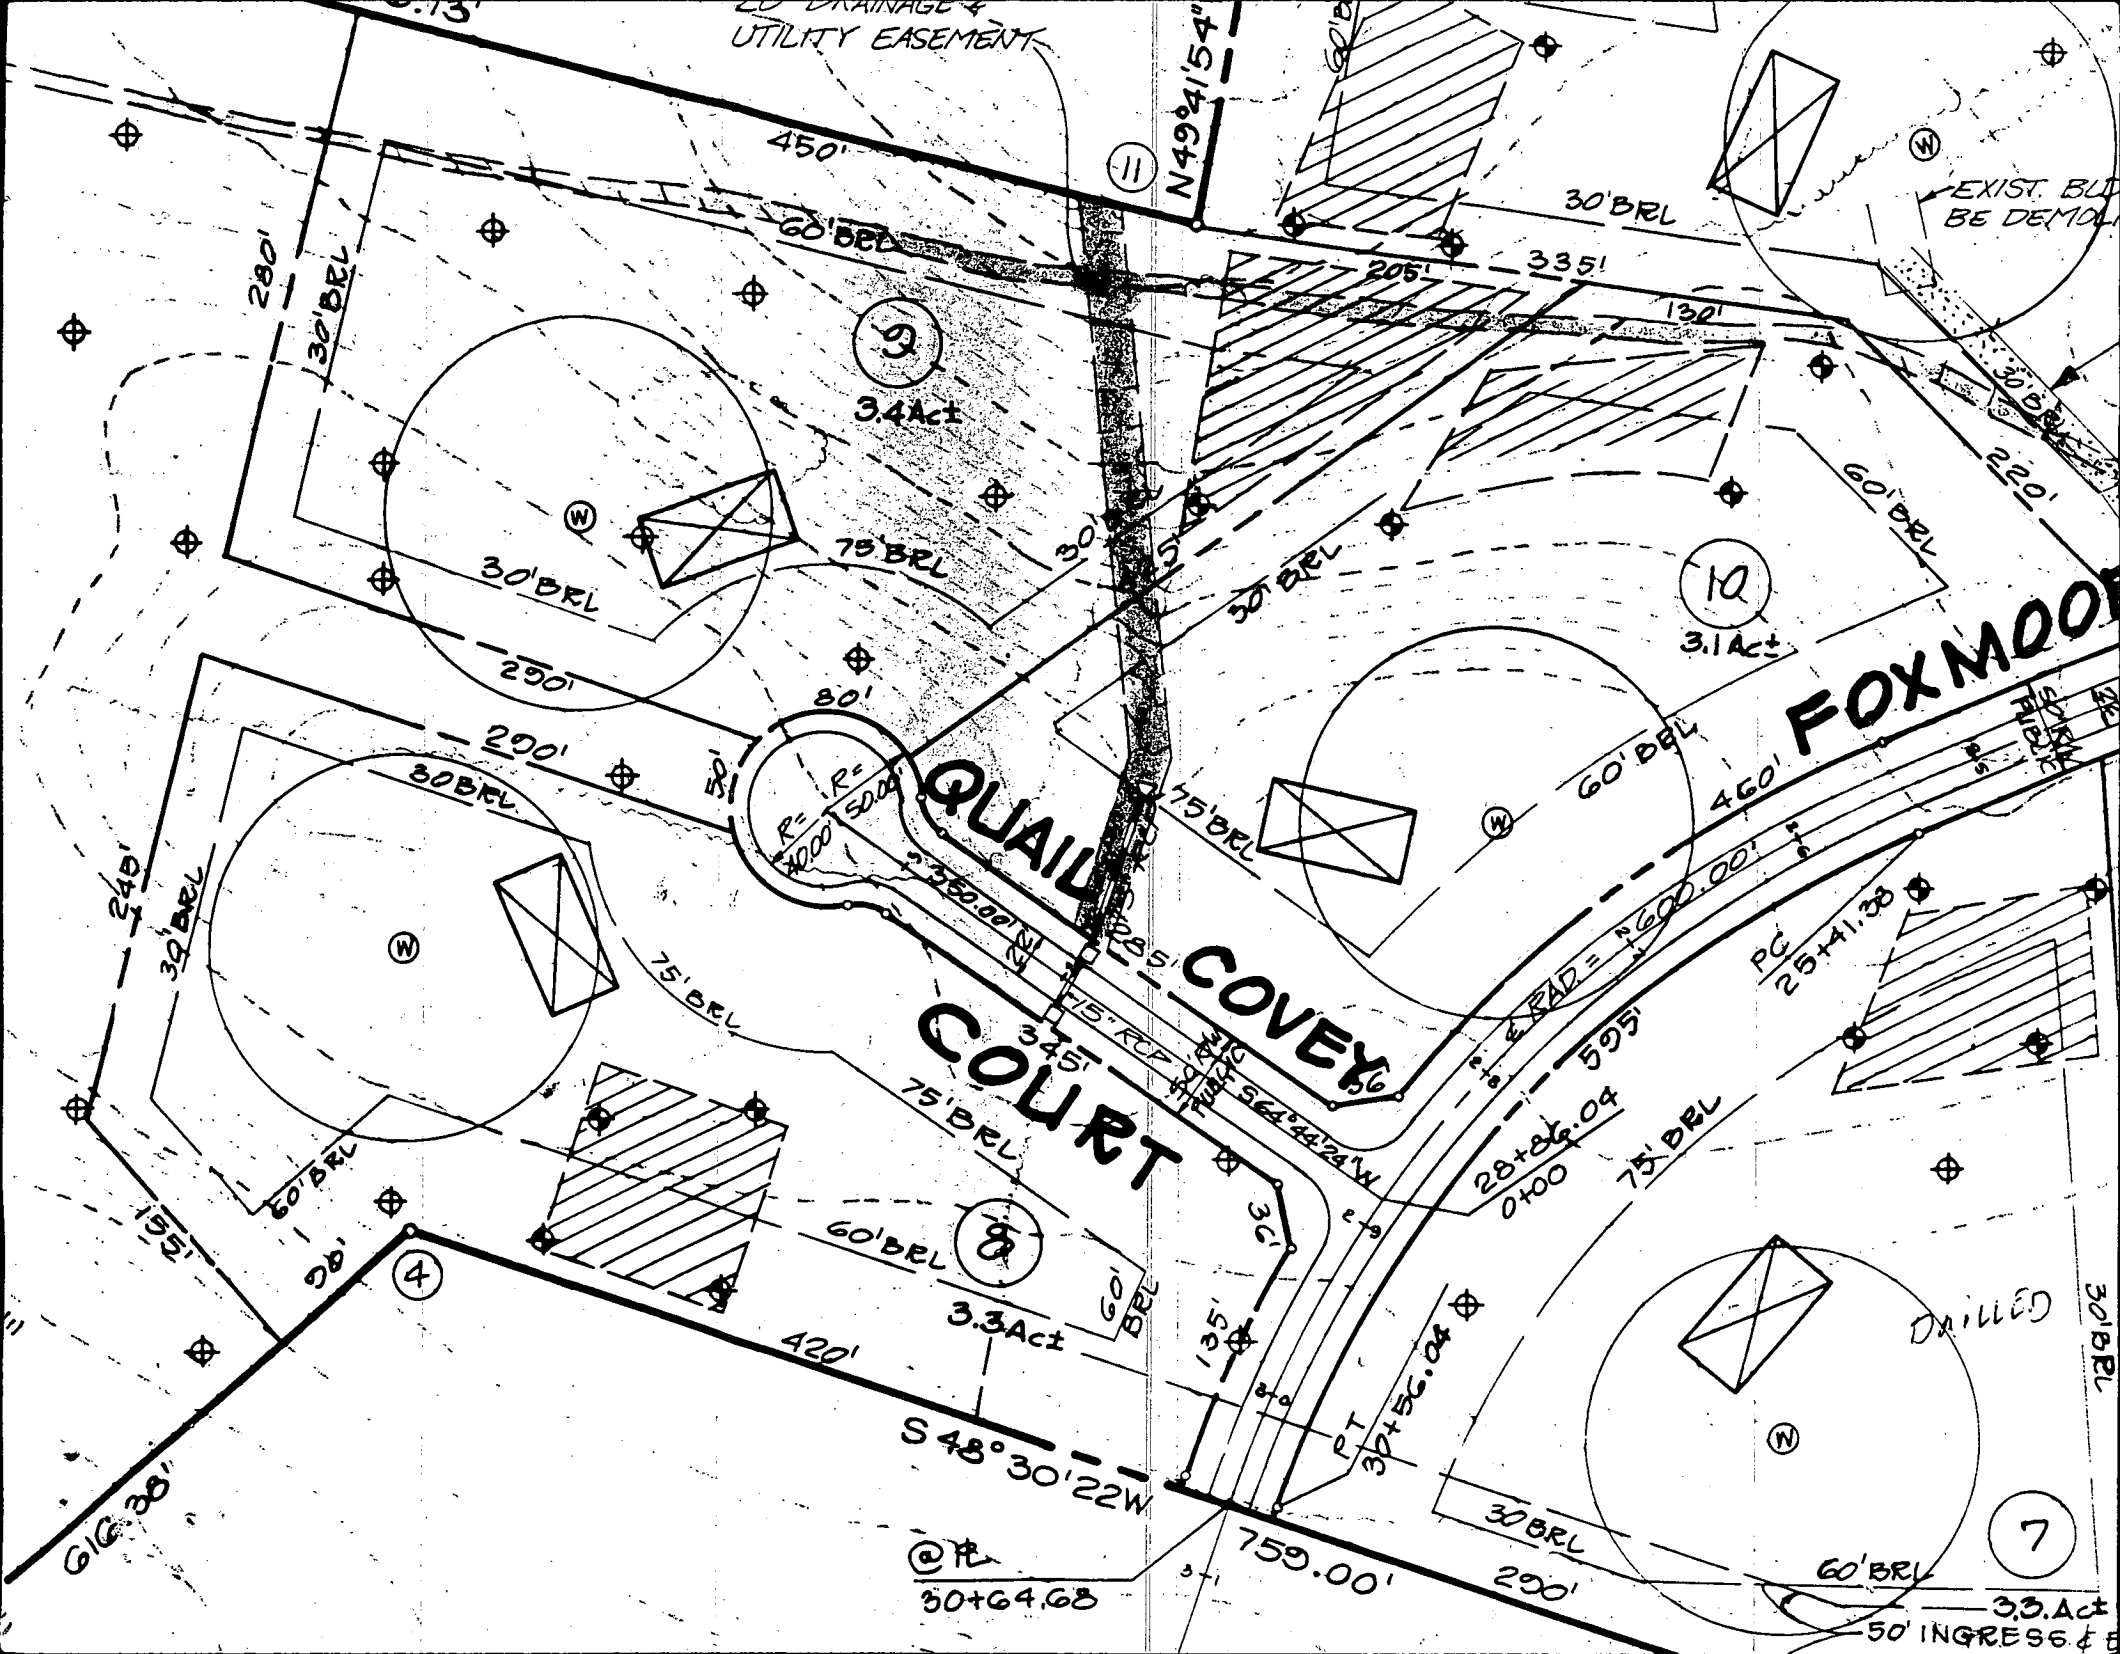

UTILITY EASEMENT

N 49° 41' 54" W

EXIST. BLDG
BE DEMOL.

FOXMOOR

QUAIL COURT

9

3.4 Act

10

3.1 Act

2

8

3.3 Act

4

7

DRILLED

S 48° 30' 22" W

PT
30+64.68

28+86.04
0+100

PC
25+41.38

PT
30+56.04

3.3 Act
50' INGRESS & E

CARL L. WHITE
604 / 359

4	93° 54' 27"	50.00	81.95	53.53	S 38° 47' 08" W	73
5	28° 30' 06"	625.00	310.90	158.74	S 06° 35' 51" E	307
6	48° 11' 23"	25.00	21.03	11.18	S 88° 50' 06" W	20
7	27° 11' 25"	50.00	23.73	12.09	N 80° 39' 56" W	23
8	49° 08' 50"	575.00	493.22	262.93	N 16° 55' 13" W	478
9	60° 06' 29"	50.00	52.45	28.93	S 38° 13' 20" E	50

Revised SDA
10-27-89
JEN

LOT 9
149,341 SQ. FT.
OR
3.428 AC.

LOT 10
134,629 SQ. FT.
OR
3.091 AC.

QUAIL COVEY COURT

DRIVE

MOOR

SEE SHEET