

MARYLAND DEPARTMENT OF THE ENVIRONMENT, WATER MANAGEMENT ADMINISTRATION
1800 Washington Blvd., Baltimore, Maryland 21230 (410) 537-3784

WATER WELL ABANDONMENT-SEALING REPORT FORM

SUBMIT COPIES OF COMPLETED FORM TO:

- * COUNTY ENVIRONMENTAL AGENCY (contact MDE, WMA if address needed)
- * WELL OWNER
- * MDE, WATER MANAGEMENT ADMINISTRATION, WELL PROGRAM

DATE WELL ABANDONED: 6-1-13 (month/day/year)

* PERMIT NUMBER OF ABANDONED WELL (if any) _____

* PERMIT NUMBER OF REPLACEMENT WELL: _____

* PERSON ABANDONING WELL: John [Signature] Grier WELL DRILLER'S LICENSE NUMBER: 086

CIRCLE: MWD / MSD / MGD

* OWNER'S NAME: Yoriko HARIKAYA

* WELL LOCATION: Prince Georges Howard Co.

COUNTY:

NEAREST TOWN: LAURET

TAX MAP 00410 BLOCK 0012 PARCEL 0688

SUBDIVISION: _____

SECTION: _____


LOT: _____

STREET ADDRESS: 10676 Old Bird Mill Rd.

LATITUDE 3 9.133202 Stanford

LONGITUDE 7 6.881227 RD

SITE LOCATION MAP

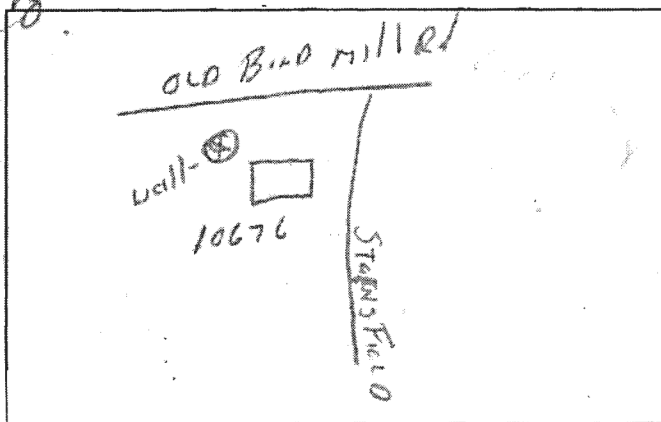

* TYPE OF WELL BEING ABANDONED:

☐ DRILLED

☐ JETTED

☐ BORED

☒ HAND DUG

☐ OTHER (specify) _____

* USE CODE:

☒ DOMESTIC

☐ MUNICIPAL/PUBLIC

☐ IRRIGATION

☐ INDUSTRIAL

☐ TEST/OBSERVATION

☐ GEOTHERMAL

* TYPE OF CASING:

☐ STEEL

☐ PLASTIC

☒ CONCRETE

☐ OTHER (specify) _____

SIZE OF CASING: 36 INCHES IN DIAMETER

DEPTH OF WELL: 30 FEET DEEP

WAS ANY CASING REMOVED? YES ☐ NO ☒

If yes, length removed, in feet: _____

WAS CASING RIPPED OR PERFORATED? YES ☐ NO ☒

LOG OF SEALING MATERIAL

MATERIAL	FEET	
	FROM	TO
Sand	20	5
Cement	5	2
Backfill	2	-

VOLUME OF MATERIAL USED

8 cubic yds of Sand
600 LBS of Portland Cement

SIGNATURE-MASTER WELL DRILLER OR SUPERVISING SANITARIAN LICENSE# MSD DFL

MWD / MSD / MGS

CIRCLE ONE

DATE 6/1/13

COUNTY