

APPLICATION

PERCOLATION TESTING

A 3884R

P _____

HOWARD COUNTY HEALTH DEPARTMENT
BUREAU OF ENVIRONMENTAL HEALTH
P.O. BOX 476 ELLICOTT CITY, MARYLAND 21043
TELEPHONE: 461-9933

DISTRICT _____

DATE 2/26/87

per 0270
BW

TO: THE COUNTY HEALTH OFFICER
ELLICOTT CITY, MARYLAND

I, HEREBY, APPLY FOR THE NECESSARY TEST IN ORDER TO CONSTRUCT (OR RECONSTRUCT) A SEWAGE DISPOSAL SYSTEM.

PROPERTY OWNER Royden A. Blunt JONATHAN SCOTT
c/o F.A.M. Equities, Inc. 233 E. Redwood Street.
ADDRESS Baltimore, MD 21202 PHONE _____

PROSPECTIVE BUYER F.A.M. Equities, Inc.
802 Garrett Bldg., 233 E. Redwood Street
ADDRESS Baltimore, MD 21202 PHONE 301-685-8588

PROPERTY LOCATION: Intersection of Rt. 32 and Folly Quarter Road

SUBDIVISION Ridgewood LOT NO. LOT 7 on Prelim

ROAD AND DESCRIPTION Public RT B 13327 Springwood Ct.

TAX MAP 22 PARCEL # 160

SIZE OF LOT 3.2 AC. TYPE BLDG. Single Family
(SINGLE FAMILY DWELLING OR COMMERCIAL)

THE SYSTEM INSTALLED UNDER THIS APPLICATION IS ACCEPTABLE ONLY UNTIL PUBLIC FACILITIES BECOME AVAILABLE. I FULLY UNDERSTAND THE

FEE CONNECTED WITH THE FILING OF THIS PERC TEST APPLICATION IS NON-REFUNDABLE UNDER ANY CIRCUMSTANCES. I ALSO AGREE TO COMPLY

WITH ALL M.O.S.H.A. REQUIREMENTS IN TESTING THIS LOT. Wigand H. Theimer (Agent for FAM Eq.)
(SIGNATURE OF APPLICANT)

APPROVED BY B. Nuyon FOR SHALLOW ONLY DATE 10/27/87

REJECTED BY _____ FOR _____ DATE _____

HOLD PENDING FURTHER TESTS _____ DATE _____


REASONS FOR REJECTION OR HOLDING FOR FIELD LOCATED HOLES
BUDG. PERMIT SIGNED
AND RETURNED 4-14-89

INITIAL SYSTEM DEEP, ALL REPAIRS SHALLOW
10/27/87 ALL SYSTEMS TO BE SHALLOW

THIS IS NOT A PERMIT

ALLOW ONLY
 NLET 3 1/2
 MAX D 5 1/2
 87 1/2
 7 1/2 3 1/2 min

NOTE: ALLOW BOTTOM OF PERC
 TO EXTEND TO W IN 25' OF

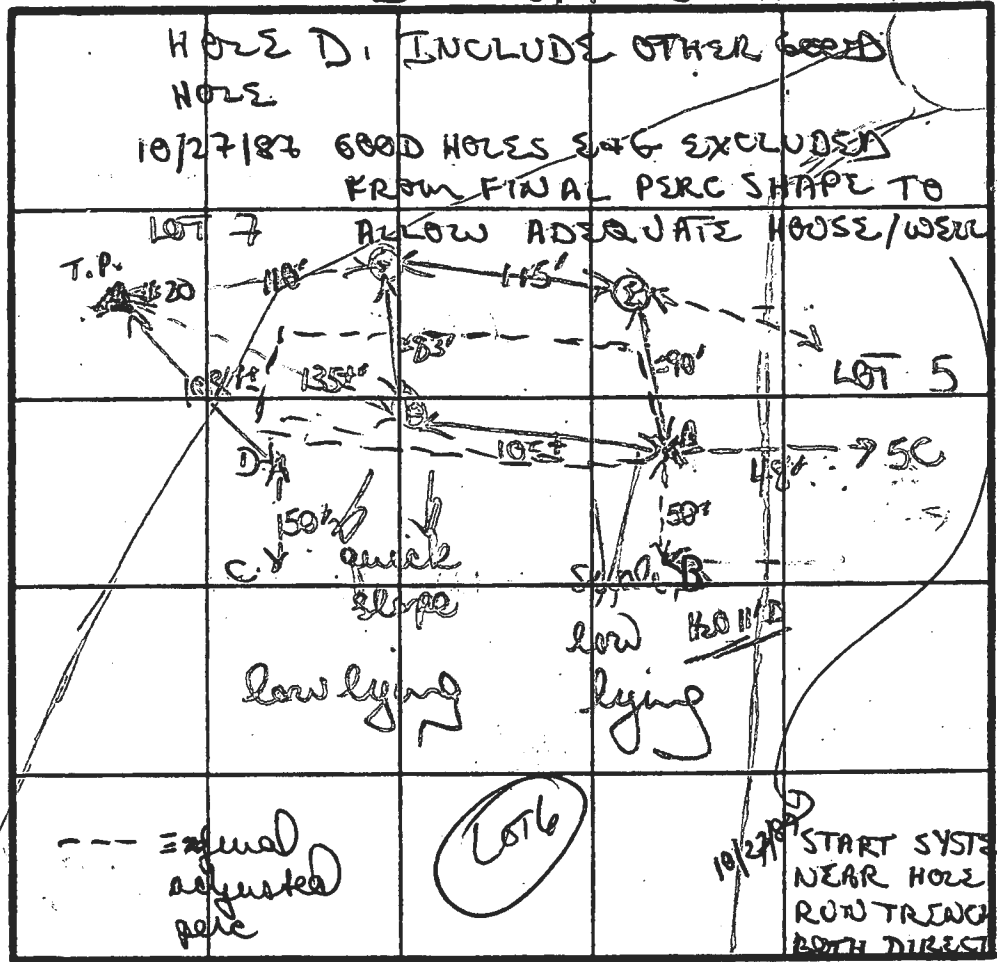

SOIL PROFILE
 orange/red clay silt
 patches of granite from 3'
 increasing to layers large frags
 9' hard

B
 orange/tan silty mic clay loam 3'
 to orange tan to grey silty mic loam w/ 5-10% weathered frags 4'
 11' H₂O 13' D

brown/grey silty mic loam w/ 10-15% weathered frags 7' to darker brown silty mic loam 8' H₂O 9' D

(F)
 orange/yell silty clay loam to grey brown silty mic loam w/ 10% weathered frags 12' D

DATE	TEST NO.	DEPTH	PRE-WET		TEST - 1" DROP		TIME
			START	STOP	START	STOP	
3/19/87	D	ROCK 9' (hard bottom)					
	C	H ₂ O 8' 9"					fail
	A	3 1/2' S	141	142	142	144	2 MIN
		6 1/2' M	141	142	142	144	2 MIN
		12' D	bottom (see profile)				
	B	3 1/2' S	DID NOT TEST				
		13' D	bottom H ₂ O 11' D				
	E	3 1/2' S	204	202	207	210	3 MIN
		7' M	204	206	206	209	3 MIN
		12' D	bottom (see profile)				

A
 brown to tan/grey silty mic loam w/ 5-10% weathered frags 3-6 + 4-12' D

perc field adjusted due to H₂O + rock
 REMARKS: Near lot line - check marks for house/well
 TYPE OF SOIL: orange/brown clay clay loam 3 1/2' mostly silty loam
 TESTED BY: B. Adams ALSO PRESENT: Alkal, Chin, Jeff

PRIVATE WELL & SEPTIC

NOTE:

A VACUUM BREAKER WILL BE
INSTALLED AS PER CODE

FOLLY

QUARTER RD.

LOT 6

LOT 7
(3.84 AC.)

EX. 100 YR. FLOOD
PLAIN DRAINAGE
UTILITY ESMT.

EX. 2.0' WIDE
DRAINAGE &
UTILITY ESMT.

LOT 8

FENCE DATA:

5' HIGH BOARD ON 80
FENCE AS PER CODE
(BY OWNER)

RESERVE AREA

POOL
(16' x 8')


FILTER PAD

WELL

SPRINGWOOD

COURT

SITE PLAN

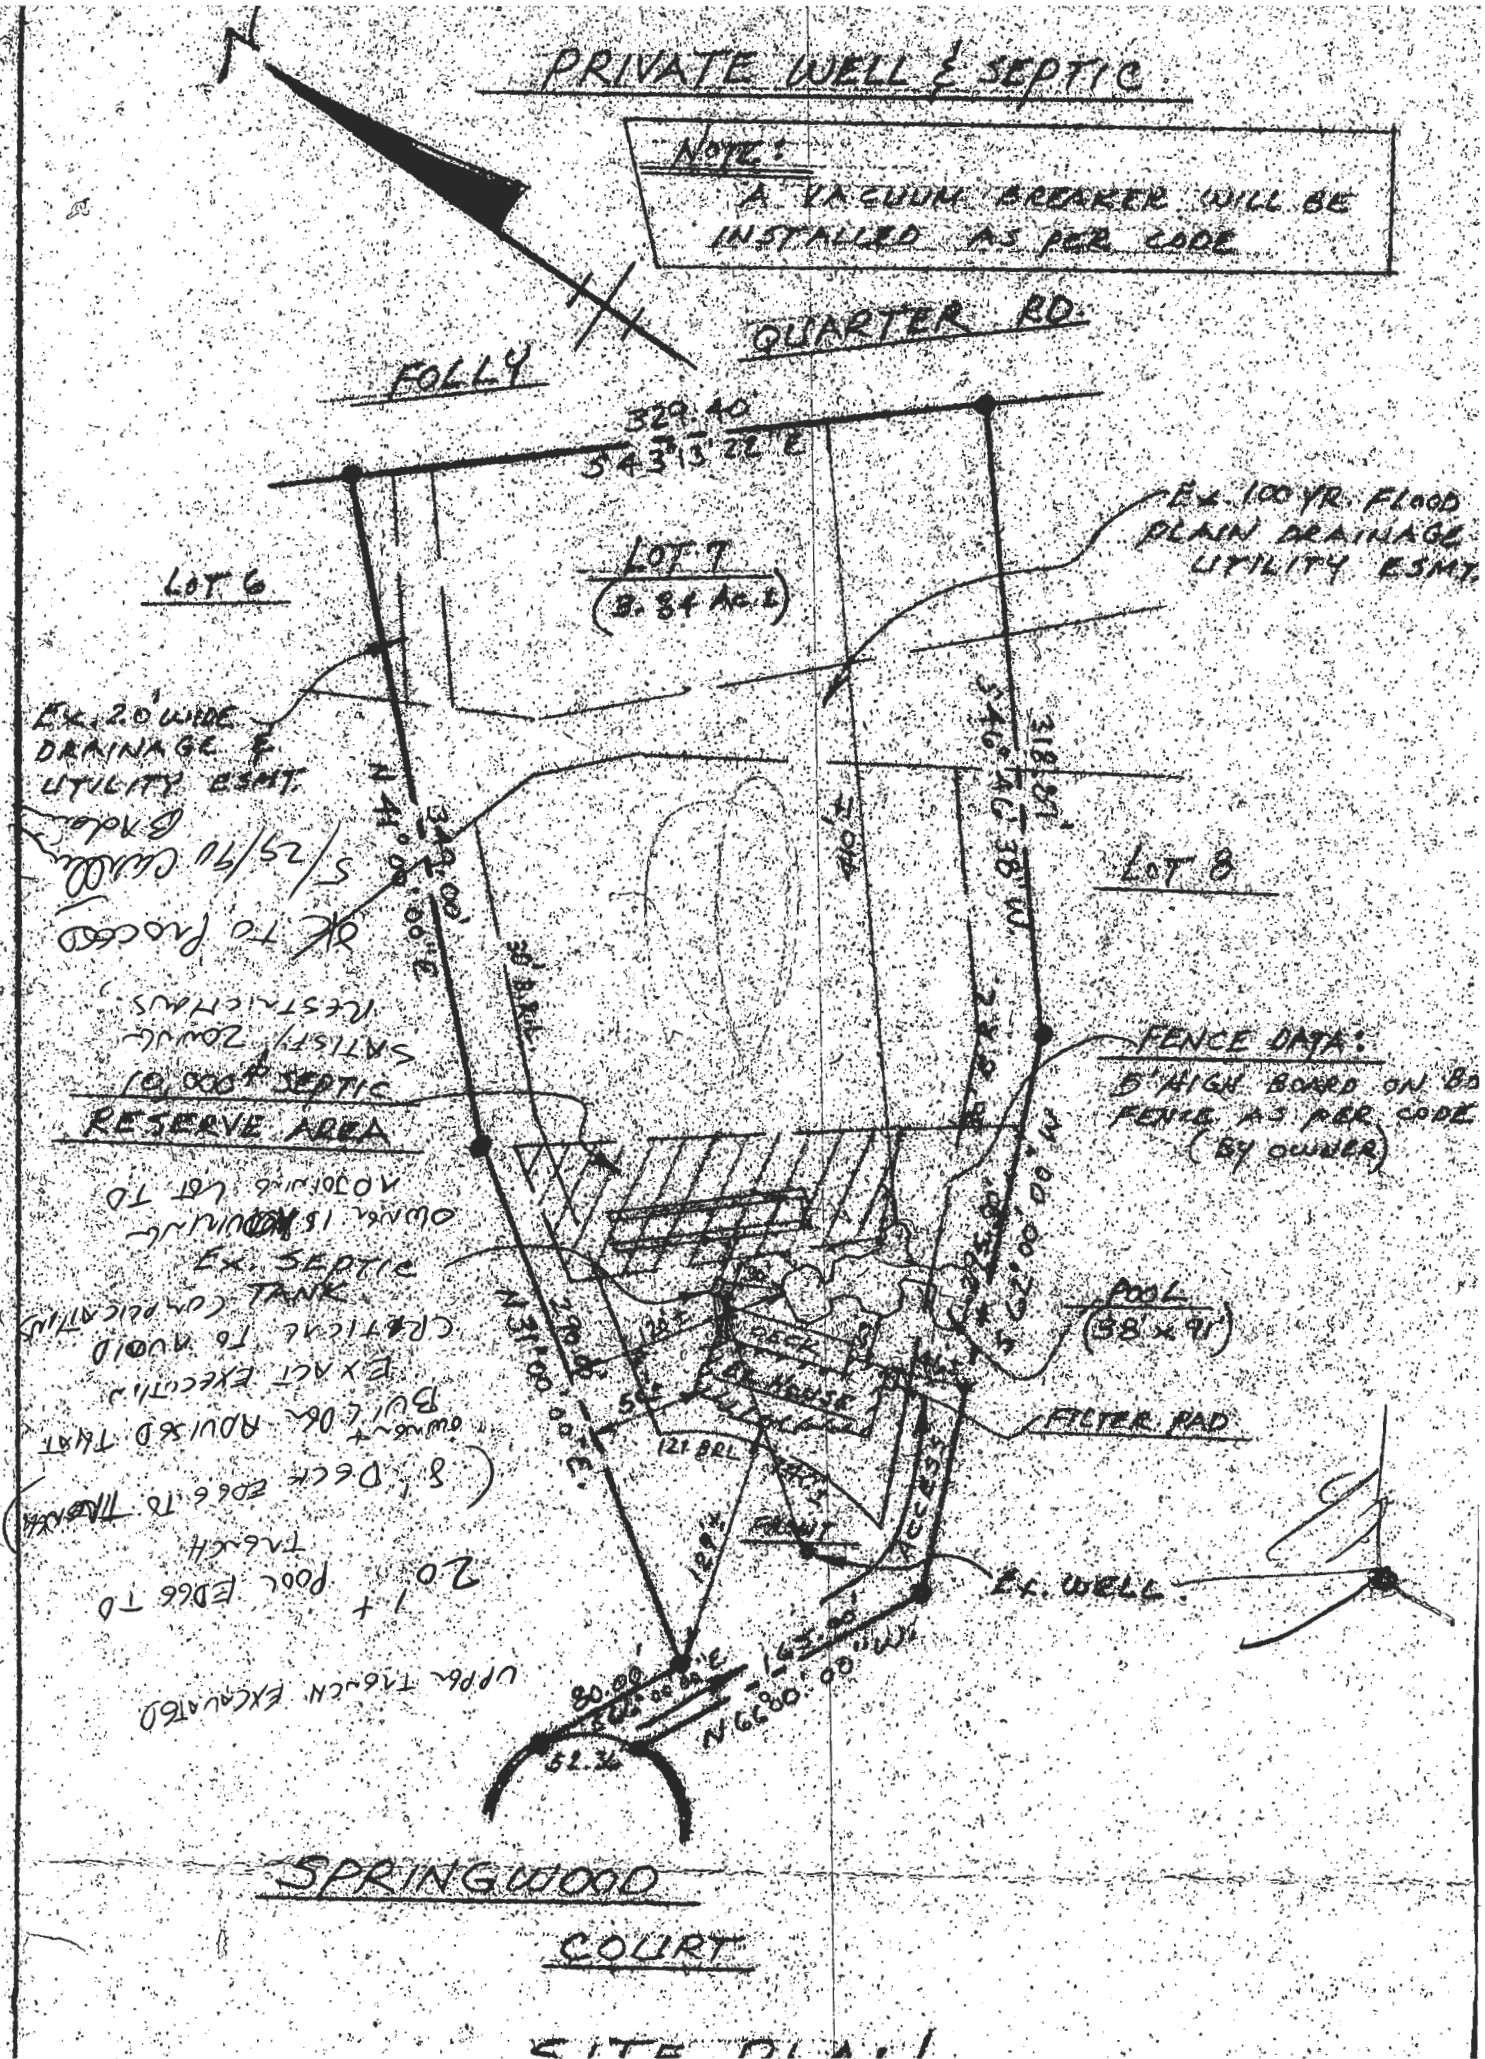

APPLICATION

PERCOLATION TESTING

HOWARD COUNTY HEALTH DEPARTMENT
BUREAU OF ENVIRONMENTAL HEALTH
P.O. BOX 476 ELLICOTT CITY, MARYLAND 21043
TELEPHONE: 461-9933

A 3884R

P _____

DISTRICT _____

DATE 2/26/87

TO: THE COUNTY HEALTH OFFICER
ELLICOTT CITY, MARYLAND

I HEREBY APPLY FOR THE NECESSARY TEST IN ORDER TO CONSTRUCT (OR RECONSTRUCT) A SEWAGE DISPOSAL SYSTEM.

PROPERTY OWNER Royden A. Blunt JONATHAN SCOTT
c/o F.A.M. Equities, Inc. 233 E. Redwood Street.
ADDRESS Baltimore, MD 21202 PHONE _____

PROSPECTIVE BUYER F.A.M. Equities, Inc.
802 Garrett Bldg., 233 E. Redwood Street
ADDRESS Baltimore, MD 21202 PHONE 301-685-8588

PROPERTY LOCATION: Intersection of Rt. 32 and Folly Quarter Road

SUBDIVISION Ridgewood LOT NO. LOT 7 on Prelim

ROAD AND DESCRIPTION Public CT B 13327 Springwood Ct.

TAX MAP 22 PARCEL # 160

SIZE OF LOT 3.2 AC. TYPE BLDG. Single Family
(SINGLE FAMILY DWELLING OR COMMERCIAL)

THE SYSTEM INSTALLED UNDER THIS APPLICATION IS ACCEPTABLE ONLY UNTIL PUBLIC FACILITIES BECOME AVAILABLE. I FULLY UNDERSTAND THE

FEE CONNECTED WITH THE FILING OF THIS PERC TEST APPLICATION IS NON-REFUNDABLE UNDER ANY CIRCUMSTANCES. I ALSO AGREE TO COMPLY

WITH ALL M.O.S.H.A. REQUIREMENTS IN TESTING THIS LOT. Wigand H. Theimer (Agent for FAM Etc.)
(SIGNATURE OF APPLICANT)

APPROVED BY B. Nixson FOR SHALLOW ONLY DATE 10/27/87

REJECTED BY _____ FOR _____ DATE _____

HOLD PENDING FURTHER TESTS _____ DATE _____

REASONS FOR REJECTION OR HOLDING FOR FIELD LOCATED HOLES BLDG. PERMIT SIGNED
AND RETURNED 4-14-89

INTTAE SYSTEM DEEP, ALL REPAIRS SHALL BE SHALLOW
10/27/87 ALL SYSTEMS TO BE SHALLOW

THIS IS NOT A PERMIT

SHALLOW ONLY
INLET 3 1/2
MAX D 5 1/2
187 1/2
X = 3 1/2 min

SOIL PROFILE

orange/red
clay silt
even
patches of
gravel
from 3'
↓
increasing
to layers
large frags
↓
hard


brown/grey
silty mica
lean

w/ 10-15%
silty mica
frags 7'
to darker
brown silty
mica lean
clay 8'
hard 9-12'

A
brown to
tan/grey
silty mica
lean

w/ 5-10%
silty mica
frags 3-6
+ 4-12' D

NOTE: ALLOW BOTTOM OF PERC
TO EXTEND TO W/ IN 25' OF

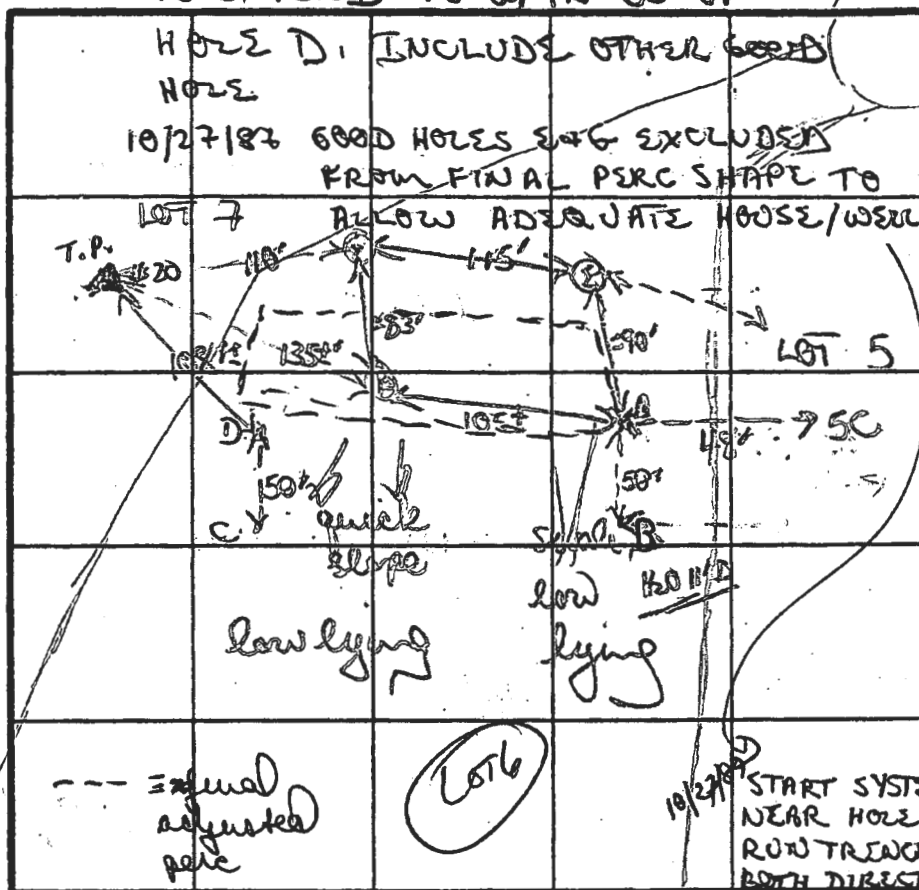

B
orange/tan
silty mica
clay lean
3'
to orange
tan to grey
silty mica
lean
w/ 5-10% sm
weathered
frags 4'
11' H2O
13'

F
orange/yellow
silty clay
lean 3'
to grey/
brown
silty mica
lean
w/ 10-20%
silty mica
12' D

INDICATE NORTH NAME ADJOINING ROADWAY AS BASE LINE.
FOREY QUINCY ROAD

DATE	TEST NO.	DEPTH	PRE-WET		TEST - 1" DROP		TIME
			START	STOP	START	STOP	
5/19/87	D	ROCK 9' (hard bottom)					
	C	H2O 8' 9"					fail
	A	3 1/2' S	141	142	142	144	2 min
		6 1/2' M	141	142	142	144	2 min
		12' D	bottom (see profile)				
	B	3 3/4' S	DID NOT TEST				
		13' D	bottom - H2O 11' D				
	E	3 1/2' S	204	207	207	210	3 min
		7' M	204	206	206	209	3 min
		12' D	bottom (see profile)				

REMARKS

perc field adjusted due to H2O + rock
Near lot line adjustments for house/well
orange/brown clay clay lean 3' mostly silty lean

TYPE OF SOIL

TESTED BY

B. N. N. N.

ALSO PRESENT

N. N. N. N. N. N.

APPLICATION

PERCOLATION TESTING

A 38841

P _____

HOWARD COUNTY HEALTH DEPARTMENT
BUREAU OF ENVIRONMENTAL HEALTH
P.O. BOX 476 ELLICOTT CITY, MARYLAND 21043
TELEPHONE: 461-9933

DISTRICT _____

DATE _____

TO: THE COUNTY HEALTH OFFICER
ELLICOTT CITY, MARYLAND

I, HEREBY, APPLY FOR THE NECESSARY TEST IN ORDER TO CONSTRUCT (OR RECONSTRUCT) A SEWAGE DISPOSAL SYSTEM.

PROPERTY OWNER _____

ADDRESS _____ PHONE _____

PROSPECTIVE BUYER _____

ADDRESS _____ PHONE _____

PROPERTY LOCATION:

SUBDIVISION RIDGEWOOD LOT NO. 6 (page 2)

ROAD AND DESCRIPTION _____

TAX MAP _____ PARCEL # _____

SIZE OF LOT _____ TYPE BLDG _____
(SINGLE FAMILY DWELLING OR COMMERCIAL)

THE SYSTEM INSTALLED UNDER THIS APPLICATION IS ACCEPTABLE ONLY UNTIL PUBLIC FACILITIES BECOME AVAILABLE. I FULLY UNDERSTAND THE FEE CONNECTED WITH THE FILING OF THIS PERC TEST APPLICATION IS NON-REFUNDABLE UNDER ANY CIRCUMSTANCES. I ALSO AGREE TO COMPLY WITH ALL M.O.S.H.A. REQUIREMENTS IN TESTING THIS LOT.

(SIGNATURE OF APPLICANT)

APPROVED BY _____ FOR _____ DATE _____

REJECTED BY _____ FOR _____ DATE _____

HOLD PENDING FURTHER TESTS _____ DATE _____

REASONS FOR REJECTION OR HOLDING _____

HD-216

THIS IS NOT A PERMIT

G
SOIL PROFILE

orange
brown
clay 3'
changing
to tan
brown
sandy
silty
red
↓

12'D

INDICATE NORTH - NAME ADJOINING ROADWAY AS BASE LINE.

DATE	TEST NO.	DEPTH	PRE-WET		TEST - 1" DROP		TIME
			START	STOP	START	STOP	
5/19/87	F	VISUAL ONLY					
		12'D (see profile)					
	G	4'S	217	222	222	228	6 min
		12'D bottom (see profile)					

REMARKS _____

TYPE OF SOIL _____

TESTED BY _____ ALSO PRESENT _____

P-88-27257



APPROVED FOR THE NATIONAL DEFENSE
 AUTHORITY
 1-18-88
 1-18-88

UNITED STATES GOVERNMENT
 1611 K Street, N.W., Washington, D.C. 20005



CLARK • FINELOCK & SACKETT, INC. 10111 1st Avenue, N.E., Seattle, WA 98108 (206) 761-1111	
PREPARED BY: CLARK • FINELOCK & SACKETT, INC.	CHECKED BY: [Signature]
DATE: 10/15/87	SCALE: 1" = 200'
PROJECT: RIDGE WOOD 10111 1st Avenue, N.E., Seattle, WA 98108	SHEET NO.: 1 OF 1

