

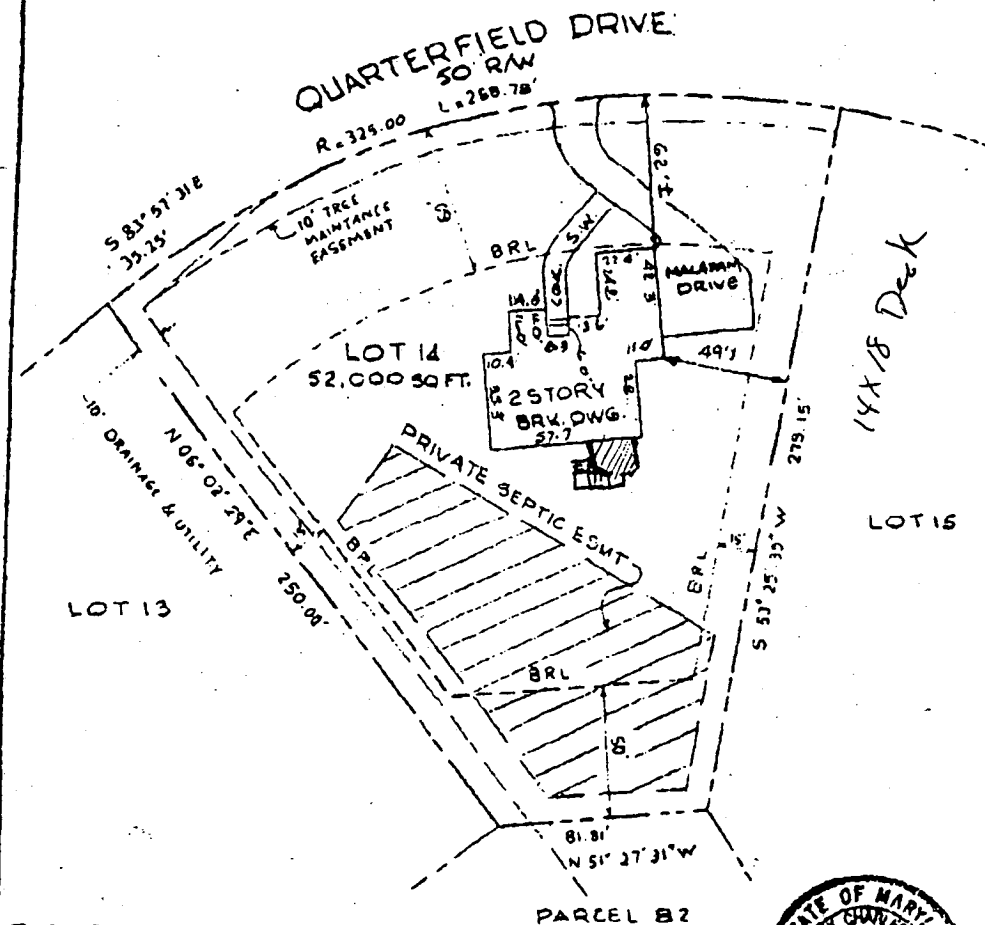
D. Patel

11620 QUARTERFIELD
DR

Ellicott City

MD 21042

7/8/98

Proposed deck
location &
as shown (DS)

TOP OF WALL ELEV. = 414.36'

FLOOD CERTIFICATIONSUBJECT PROPERTY IS SHOWN IN ZONE 'C' AS SHOWN ON
COMMUNITY PANEL 1A04-000000000000 DATE 12/1/86THIS PLAT IS NOT INTENDED TO BE USED FOR THE PURPOSE
OF ESTABLISHING PROPERTY LINES OR POINTS AND WAS
PREPARED WITHOUT THE BENEFIT OF A FLOOD MAP

PREPARED WITHOUT THE BENEFIT OF A FLOOD MAP

RECORD REFERENCES	LOCATION SURVEY OF LOT 14	MARKS-VOGEL ASSOCIATES, INC.
LIBER/FOLIO -	FINAL	CONSULTING ENGINEERS-SURVEYORS-PLANNERS
PLAT BOOK -	QUARTERFIELD	3481 PARK AVE. #101 ELLICOTT CITY, MD 21043
PLAT NO./FOLIO 11938	HOWARD COUNTY	TELEPHONE (410)481-6828 FAX (410)485-3868
SCALE 1"=50'	MARYLAND	I HEREBY CERTIFY THAT THE IMPROVEMENTS ARE LOCATED AS SHOWN HEREON AND TO THE BEST OF MY KNOWLEDGE AND BELIEF, THERE ARE NO ENCUMBRANCES EXCEPT AS SHOWN.
DATE 5/14/98		Mark C. Marks 6/2/98