

PUB. SEWER STATUS VERIFIED BY _____

ISSUE DATE:

3/16/09

PERMIT

P 530333

APPROVAL DATE:

3/19/09

A REPAIR

Tax ID # 05-409284

ON-SITE SEWAGE DISPOSAL SYSTEM HOWARD COUNTY HEALTH DEPARTMENT BUREAU OF ENVIRONMENTAL HEALTH

Jenkins Brothers

IS PERMITTED TO INSTALL ☐ ALTER ☒

ADDRESS: 7670 Smith's Private Road

PHONE NUMBER: 410-461-9282

SUBDIVISION: Ridgewood

LOT NUMBER: 11

ADDRESS: 13314 Springwood Court

PROPERTY OWNER: George Ricaurte

SEPTIC TANK CAPACITY (GALLONS):

Ex 1250

PUMP CHAMBER CAPACITY (GALLONS):

—

NUMBER OF BEDROOMS:

4

SQUARE FOOTAGE (OF HOUSE):

4847


LINEAR FEET OF TRENCH REQUIRED:

125

Charles 410 971-8104

TRENCHES:	Trench to be ³ feet wide. Inlet at feet below original grade. Bottom maximum depth ⁸ feet below original grade. Effective area begins at feet below original grade. ³ feet of stone below the distribution pipe.
LOCATION:	Septic system is failing. Repair has been scheduled.
ADDITIONAL NOTES:	

PLANS APPROVED:

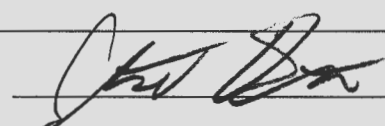

DATE:

3/16/09

NOTE: PERMIT VOID AFTER 2 YEARS

NOTE: CONTRACTOR RESPONSIBLE FOR SCHEDULING A PRE-CONSTRUCTION INSPECTION FOR ALL INSTALLATIONS

NOTE: WATERTIGHT SEPTIC TANKS REQUIRED


NOTE: ALL PARTS OF SEPTIC SYSTEM SHALL BE 100 FEET FROM ANY WATER WELL

NOTE: MANHOLE RISERS REQUIRED ON ALL SEPTIC TANKS AND PUMP CHAMBERS

NEITHER THE HOWARD COUNTY COUNCIL OR THE HEALTH DEPARTMENT IS
RESPONSIBLE FOR THE SUCCESSFUL OPERATION OF ANY SYSTEM
PERMITTEE RESPONSIBLE FOR OBTAINING FINAL APPROVAL ON THIS PERMIT
CALL 410-313-2640 FOR INSPECTION OF SEPTIC SYSTEM

40-88-0580

NOT TO SCALE

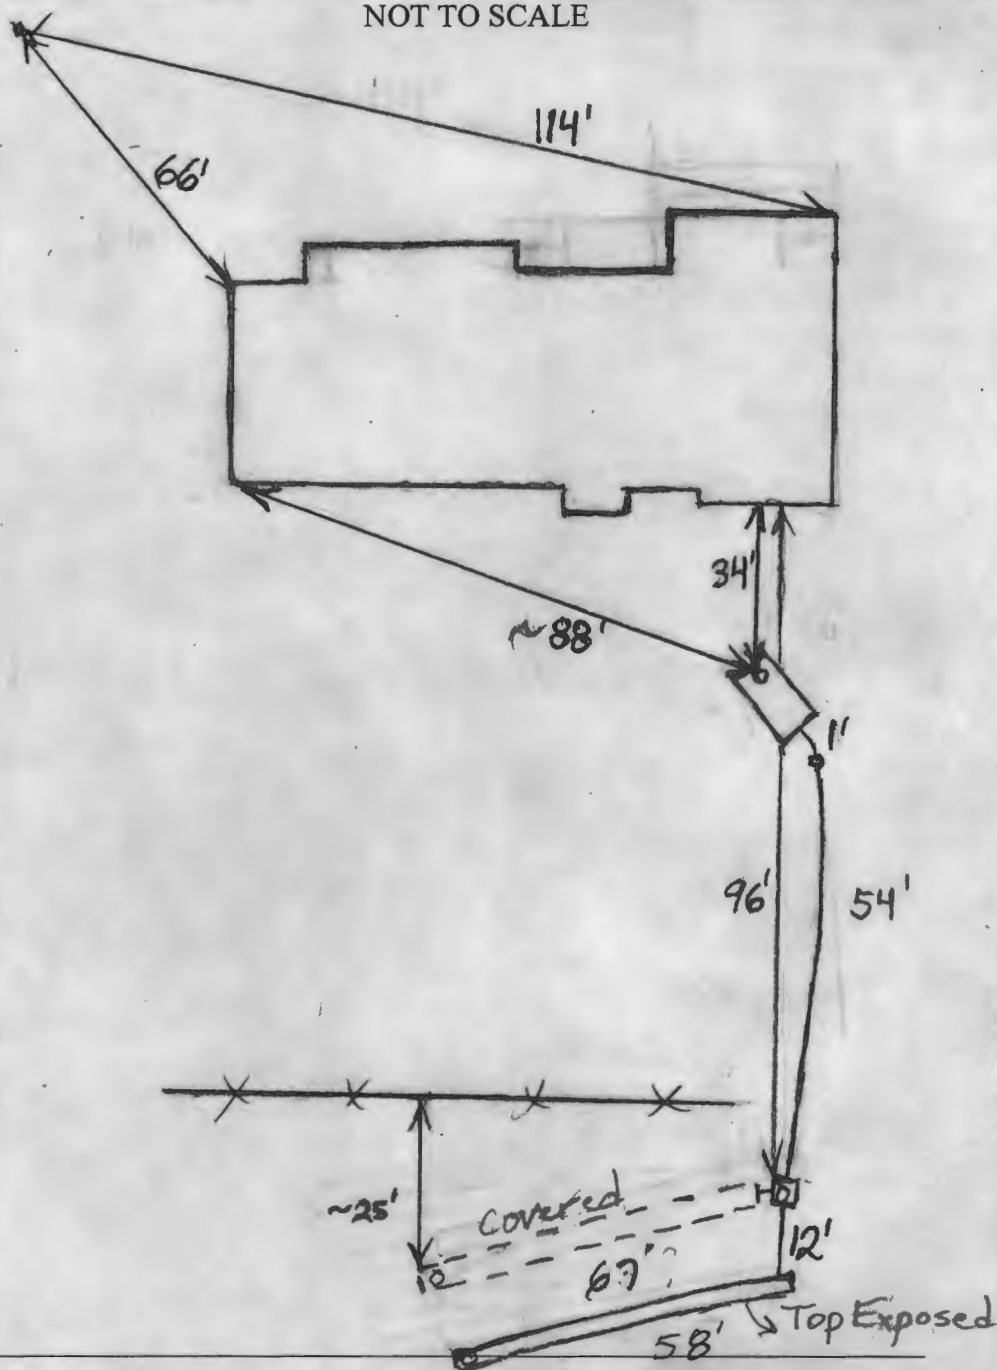

TRENCH/DRAINFIELD DATA

WIDTH INLET BOTTOM

3' 4-4.5' 8'

NUMBER OF TRENCHES 2

TOTAL LENGTH 125'

ABSORPTION AREA 363 ± Sidewall

DISTRIBUTION BOX LEVEL Levelers

DISTRIBUTION BOX BAFFLE Yes

DISTRIBUTION BOX PORT Yes

SEPTIC TANK DATA

SEPTIC TANK 1 LEVEL

MANUFACTURER ?

CAPACITY Ex 1250 GAL

SEAM LOC Midseam

TANK LID DEPTH 21-3'

BAFFLES Yes

BAFFLE FILTER No

MANHOLE LOC None

6" PORT LOC Front

WATERTIGHT TEST No

SLOTTED No

PUMP/SEPTIC TANK LEVEL N/A

MANUFACTURER

CAPACITY GAL

SEAM LOC

TANK LID DEPTH

BAFFLES

BAFFLE FILTER

MANHOLE LOC

6" PORT LOC

WATERTIGHT TEST

SLOTTED

PRE-CONSTRUCTION

3/16/09 Pool not
in the right place as
shown on permit plan.
Per tests completed
3/18/09 System
installed. System not inspected. Inspection was not
written in inspection book. Most of system was
covered before any of it was seen. Cannot
approve because I don't know what I'm approving.
Installer said he told Stuart that he was working.
3/19/09 Spoke w/ Charles @ Jenkins. Verified trench
specs (S)

FINAL INSPECTOR

DATE OF APPROVAL

3/19/09

Act 1 Act 1 Lecture 1-50

