



APPLICATION

FOR PERCOLATION TESTING AND SITE EVALUATION

TEST DATE(S) _____ TEST TIME _____

(AP) 536038

AGENCY REVIEW: _____

DATE 11-18-11

DO NOT WRITE ABOVE THIS LINE

I HEREBY APPLY FOR THE NECESSARY TESTING/EVALUATION PRIOR TO ISSUANCE OF SEWAGE DISPOSAL SYSTEM PERMIT(S) TO:

CHECK AS NEEDED:

- ☐ CONSTRUCT NEW SEPTIC SYSTEM(S)
☒ REPAIR/ADD TO AN EXISTING SEPTIC SYSTEM
☐ REPLACE AN EXISTING SEPTIC SYSTEM

CHECK AS NEEDED:

- ☐ NEW STRUCTURE(S)
☐ ADDITION TO AN EXISTING STRUCTURE
☐ REPLACE AN EXISTING STRUCTURE

CHECK ONE:

- ☐ CREATE NEW LOT(S)
☐ BUILD ON AN EXISTING LOT IN A SUBDIVISION
☐ BUILD ON AN EXISTING PARCEL OF RECORD

IS THE PROPERTY WITHIN 2500' OF ANY RESERVOIR?

- ☐ YES
☐ NO

THE TYPE OF STRUCTURE IS:

- ☒ RESIDENTIAL WITH 4 PROPOSED BEDROOMS IN THE COMPLETED STRUCTURE (NOTE **UNKNOWN** IF APPROPRIATE)
☐ COMMERCIAL (PROVIDE DETAIL OF NUMBERS AND TYPES OF EMPLOYEES/ CUSTOMERS ON ACCOMPANYING PLAN)
☐ INSTITUTIONAL/GOVERNMENT (PROVIDE DETAIL OF NUMBERS AND TYPES OF EMPLOYEES/USERS ON ACCOMPANYING PLAN)

PROPERTY OWNER(S) John M. KK

DAYTIME PHONE 301 854-5853 CELL 240 375-6341 FAX _____

MAILING ADDRESS 17108 Spring Hollow Ct Mt. Airy 21771
STREET CITY/TOWN STATE ZIP

APPLICANT Kurt / Fogle's Septic Clean, Inc.

DAYTIME PHONE 410 795-5670 CELL 410 984-5211 FAX 410 795-3432

MAILING ADDRESS 580 Obrecht Rd Sykesville MD 21784
STREET CITY/TOWN STATE ZIP

APPLICANT'S ROLE: DEVELOPER BUILDER BUYER RELATIVE/FRIEND REALTOR CONSULTANT

PROPERTY LOCATION
SUBDIVISION/PROPERTY NAME Spring Hollow LOT NO. 211

PROPERTY ADDRESS 17108 Spring Hollow Ct Mt. Airy
STREET TOWN/POST OFFICE

TAX MAP PAGE(S) 7 GRID 8 PARCEL(S) 528 PROPOSED LOT SIZE 1.01


AS APPLICANT, I UNDERSTAND THE FOLLOWING: THE SYSTEM INSTALLED SUBSEQUENT TO THIS APPLICATION IS ACCEPTABLE ONLY UNTIL PUBLIC SEWERAGE IS AVAILABLE. THIS APPLICATION IS COMPLETE WHEN ALL APPLICABLE FEES AND A SUITABLE SITE PLAN HAVE BEEN RECEIVED. I ACCEPT THE RESPONSIBILITY FOR COMPLIANCE WITH ALL M.O.S.H.A. AND "MISS UTILITY" REQUIREMENTS. APPROVAL IS BASED UPON SATISFACTORY REVIEW OF A PERC CERTIFICATION PLAN.

TEST RESULTS WILL BE MAILED TO APPLICANT.

Kurt A. Cassell

SIGNATURE OF APPLICANT

HOWARD COUNTY HEALTH DEPARTMENT, BUREAU OF ENVIRONMENTAL HEALTH, WELL AND SEPTIC PROGRAM
3525-H ELLICOTT MILLS DRIVE, ELLICOTT CITY, MARYLAND 21043-4544 (410) 313-1771 FAX (410) 313-2648
TDD (410) 313-2323 TOLL FREE 1-877-4MD-DHMH

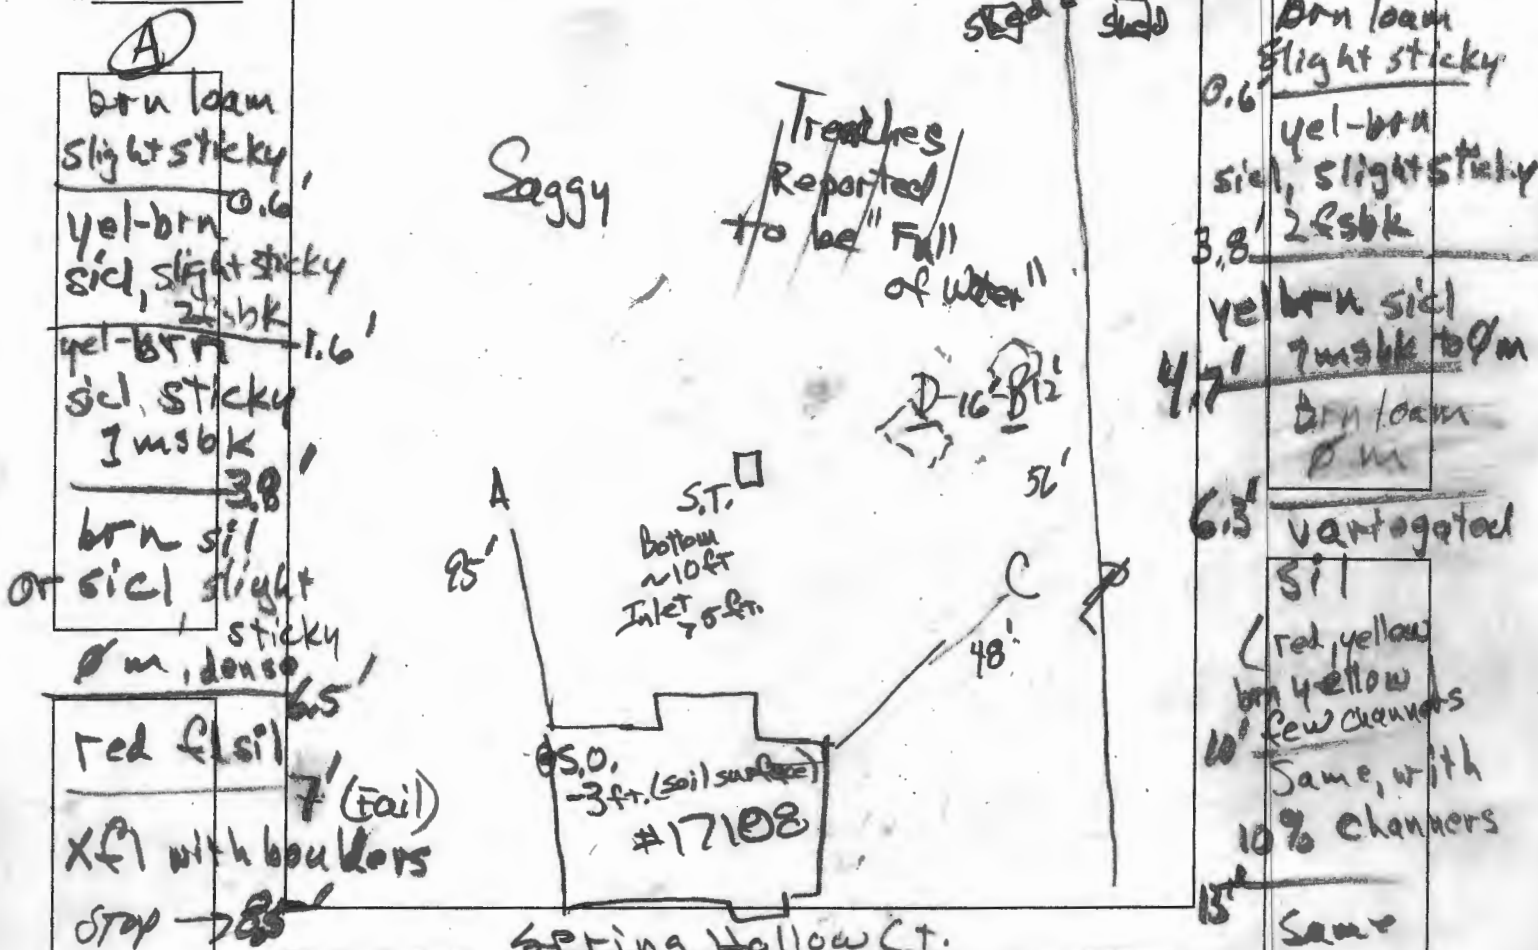

DATE	TEST #	DEPTH	START	BREAK 1" DROP	STOP 2" DROP	TIME OF 2ND INCH	P/F/H
11/30/11	A	7'	Visual	sticky sil conventional			F
				rate not achievable			
11/30/11	B	7' / 17.2'	12:37	12:41	12:49	8	P
11/30/11	C	7' / 12.3'	11:52	11:57	12:06	9	P
11/30/11	D	17'	Visual	Same as B			P
				0.8 gpd/sq ft			

REMARKS: "4 Bedrooms"; 'C' does not hold water at 14' 14

SANITARIAN: RB BACKHOE: Smiley (Fogles) OTHERS: Donna owner

TEST HOLES USED IN SDA: 10' square 4' INLET DEPTH MAX. BOT DEPTH: 13' EFFECTIVE S/W: 187.5 sq. ft/BR

TRENCH WIDTH: 10' square 4' INLET DEPTH MAX. BOT DEPTH: 13' EFFECTIVE S/W: 187.5 sq. ft/BR

Dry well 2 Dry walls (at B's b')

Solation level in Septic Tank (S.T.) is at about 5' deep. S.T. is at lower elevation than B & C.

Same w/ 2 npl few channers

17.2'

C

brn loam 3' 3g

0.6' yel-brn sil, 2fshk, ss

2.2' brn sil, dense sm, slight sticky

6.5' brn ch sil slight sticky

12.3' yel sil >55% rock



HOWARD COUNTY HEALTH DEPARTMENT

36038

DATE
11/18/2011

Received
From

Tyler Septic Clean Trc

PHONE #

410-984-5211

☐ CASH

☒ CHECK

NO.

34365

For

Per / Repair - 17100 Spring Willow Court
Spring Willow Lot 11

\$

330/00

Received By

Jeffrey A. [Signature]

Dollars