

DEPARTMENT OF INSPECTIONS, LICENSES AND PERMITS
3630 COURT HOUSE DRIVE
ELICOTT CITY, MD 21043
PERMITS (410) 313-2455 INSPECTIONS (410) 313-1810
AUTOMATED INFORMATION (410) 313-3800

HOWARD COUNTY
PERMIT APPLICATION

PERMIT NUMBER
B077003351

Building Address 17112 Spring Hollow Court
Mt. Airy, MD

Suite/Apt. #: SDP/WP/Petition #: Census Tract Subdivision Spring Hollow BSE

Section Area 2 Lot 10

Tax Map 7 Parcel 528 Grid 8

Zoning Res Map Coordinates Lot size 42,179.00 sq

Property Owner's Name Robert + Jan B. Burt

Address 17112 Spring Hollow Ct

City Mt Airy State MD Zip Code 21201

Home Phone 410-429-5055 Work Phone 410-429-5257

Applicant's Name & Mailing Address, (if other than stated herein): Same as Contractor

Phone Fax

Existing Use Residential (SFD)

Proposed Use Add swimming pool

Estimated Construction Cost \$ 40,000

Description of Work Add 16' x 40' in ground swimming pool

Contractor Company TCF Inc

Contact Person Jan Burt

Address 172 Park Lane

City Thurgent State MD Zip Code 21787

License No. 13842

Phone 301-291-2020 Fax 301-291-2602

Occupant or Tenant

Contact Name

Address

City State Zip Code

Phone Fax

Engineer or Architect Company

Contact Person

Address

City State Zip Code

Phone Fax

BUILDING DESCRIPTION - COMMERCIAL

BUILDING DESCRIPTION - RESIDENTIAL

Building Characteristics

Utilities

Height:

No. of stories:

Gross area, sq. ft. per floor:

Use group:

Construction type:

Water Supply:

Sewage Disposal:

Electric Yes No

Gas Yes No

Heating System:

Sprinkler system:

Reinforced Concrete

Structural Steel

Masonry

Wood Frame

State Certified Modular

Public

Private

Public

Private

Electric Oil

Natural Gas

Propane Gas

N/A

Full

Partial

Other Suppression

of Heads

Building Characteristics

Utilities

SF Dwelling SF Townhouse

1st floor:

2nd floor:

Basement:

Finished Basement Unfinished Basement

Crawl space Slab on Grade

No. of Bedrooms

Multi-family dwellings:

No. of efficiency units:

No. of 1 BR units:

No. of 2 BR units:

No. of 3 BR units:

Other Structure:

Dimensions:

Footings:

Roof:

State Certified Modular

Manufactured Home

Water Supply:

Sewage Disposal:

Electric Yes No

Gas Yes No

Heating System:

Electric Oil

Natural Gas

Propane Gas

Sprinkler system:

N/A

NFPA #13D

NFPA #13R

Other:

THE UNDERSIGNED HEREBY CERTIFIES AND AGREES AS FOLLOWS: (1) THAT HE/SHE IS AUTHORIZED TO MAKE THIS APPLICATION; (2) THAT THE INFORMATION IS CORRECT; (3) THAT HE/SHE WILL COMPLY WITH ALL REGULATIONS OF HOWARD COUNTY WHICH ARE APPLICABLE THERETO; (4) THAT HE/SHE WILL PERFORM NO WORK ON THE ABOVE REFERENCED PROPERTY NOT SPECIFICALLY DESCRIBED IN THIS APPLICATION; (5) THAT HE/SHE GRANTS COUNTY OFFICIALS THE RIGHT TO ENTER ONTO THIS PROPERTY FOR THE PURPOSE OF INSPECTING THE WORK PERMITTED AND POSTING NOTICES.

Applicant's Signature

Print Name

Date

Title/Company

Checks payable to: DIRECTOR OF FINANCE OF HOWARD COUNTY

** PLEASE WRITE NEATLY AND LEGIBLY. **

- FOR OFFICE USE ONLY -

AGENCY

DATE

SIGNATURE APPROVAL

DPZ SETBACK INFORMATION

PROPERTY ID#:

Land Development, DPZ

State Highways

Building Official

Dev. Engineering, DPZ

Health

Fire Protection

Is Sediment Control approval required prior to issuance?

YES NO

CONTINGENCY CONSTRUCTION START:

ONE STOP SHOP:

Front:

Rear:

Side:

Side St.:

All minimum setbacks met?

YES NO

Is Entrance Permit required?

YES NO

Historic District?

YES NO

Lot Coverage for NewTown Zone

SDP/Red-line approval date

Filing fee \$

Permit fee \$ 250

Excise tax \$

Add'l per. fee \$ 25

TOTAL FEES \$ 275

Sub-total paid \$ 275

Balance due \$ 0

Check # 11251

Validation #

Accepted by

Distribution of Copies-

White: Building Official

Green: LDD, DPZ

Yellow: DED, DPZ

Pink: Health


Gold: SHA

T:\forms\PERMIT.FRM

Rev. 5/17/00

Rev: 5/17/00

12/6/01
Partial Finishing
of Basement O.R.
(BB)
B00133505

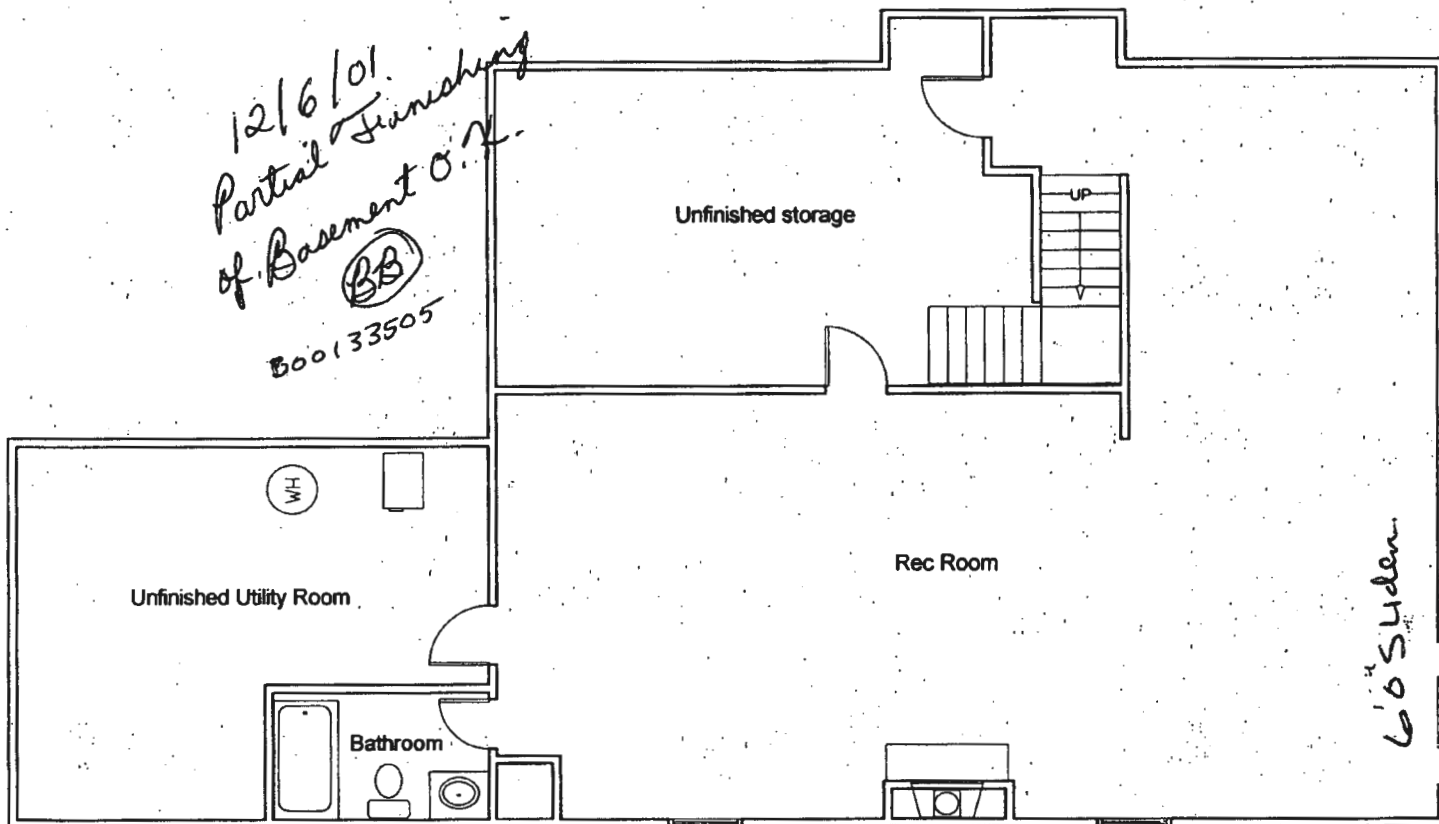

LIVING AREA