## APPLICATION

SEWAGE DISPOSAL TESTING

P\_\_\_\_\_

MARYLAND STATE DEPARTMENT OF HEALTH

HOWARD COUNTY


ELLICOTT CITY

DISTRICT\_\_\_\_3\_

DATE 1/12/71

TO: THE COUNTY HEALTH OFFICER  ELLICOTT CITY, MARYLAND	- 1 
I, HEREBY, APPLY FOR THE NECESSARY TESTS IN ORDER TO DISPOSAL SYSTEM.	O CONSTRUCT (OR RECONSTRUCT) A SEWAGE
PROPERTY OWNER Walter A. Shank	:
ADDRESS Walt-Ann Drive, Ellicott City, Mc	1PHONE531-5631
PROPERTY LOCATION:	
distriction	LOT NO
ROAD AND DESCRIPTION . End of Sky Way in back of brid	ek building
OCCUPANT	PHONE
PERSON TO CONSTRUCT SYSTEM	
ADDRESS	Barn will be remodelle
SIZE OF LOT 22 acres ±	TYPE 9LOG. 3
IF NOT SINGLE RESIDENCE DESCRIBE	
SIGNATURE OF APPLICANT I Shank	· · · · · · · · · · · · · · · · · · ·
APPROVED BY KAYN VINE DYSTER FOR MICH	Ell DATE 1/20/7/
REJECTED BY FOR	DATE
	DATE
REASONS FOR REJECTION OR HOLDING	
No.	

THIS IS NOT A PERMIT

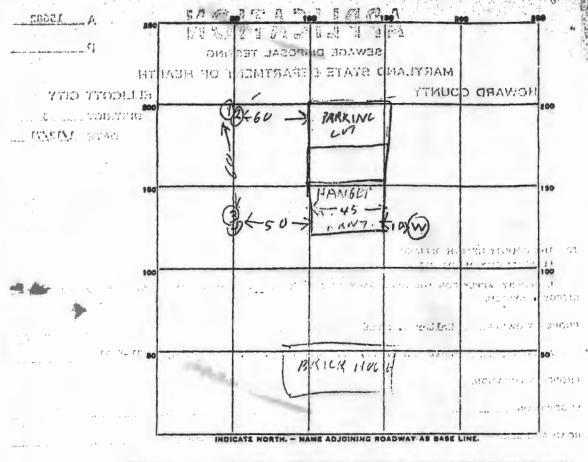

	DATE	TRAT NO	DEPTH	PRE-WET		TEST - 1" DROP		TIME
Whit.	Ti-Lu	TEST NO.		aili	GIII	GII.	9112	7
,	1191-11		10/2	771	741	947	749	1 1 500
	1	2	31/2	942	143	943	947	4
toffice for any state	: 120	3	10/2	952	958	958	1004	6
· Acres Baller		4	3/2	954	956	936	958	2
6 · · ·	1					eria e e e L	Lygre ger	
				150			. 4 sper to recept	
					1	1	1 1 1	1 . 1 11
				7.		07 9-		April 5 to
				1.6	11 to 8	,		
eran care and		, 1 , 3			Sagari	931931 and a	71.7 5 57	

TESTED BY 3. ) Andre 1

REMARKS.

(b) 0 # #572