

Building Address 1806 Quarter Horse Ct	Property Owner's Name Brian Libby Kahut
Suite/Apt. #: SDP/WP/Petition #:	Address 1806 Quarterhorse Dr
Census Tract Subdivision Parkside	City Woodstock State MD Zip Code 21163
Section Area Lot 13	Home Phone Work Phone
Tax Map Parcel Grid	Applicant's Name & Mailing Address, (if other than stated hereon):
Zoning Map Coordinates Lot size	Phone Fax
Existing Use SFD	Contractor Company
Proposed Use same w/ porch	Contact Person
Estimated Construction Cost \$	Address
Description of Work open porch conc. piers wood roof 10' x 63' 10' x 40' w/ steps to grade	City State Zip Code
Occupant or Tenant	License No. Phone Fax
Contact Name	Engineer or Architect Company
Address	Contact Person
City State Zip Code	Address
Phone Fax	City State Zip Code
	Phone Fax

BUILDING DESCRIPTION - COMMERCIAL		BUILDING DESCRIPTION - RESIDENTIAL	
Building Characteristics	Utilities	Building Characteristics	Utilities
Height:	Water Supply: ☐ Public ☐ Private	SF Dwelling ☐ SF Townhouse ☐ <u>Depth</u> <u>Width</u>	Water Supply: ☐ Public ☐ Private
No. of stories:	Sewage Disposal: ☐ Public ☐ Private	1st floor:	Sewage Disposal: ☐ Public ☐ Private
Gross area, sq. ft. per floor:	Electric Yes ☐ No ☐ Gas Yes ☐ No ☐	2nd floor:	Electric Yes ☐ No ☐ Gas Yes ☐ No ☐
Use group:	Heating System: Electric ☐ Oil ☐ Natural Gas ☐ Propane Gas ☐	Basement:	Heating System: Electric ☐ Oil ☐ Natural Gas ☐ Propane Gas ☐
Construction type: ☐ Reinforced Concrete ☐ Structural Steel ☐ Masonry ☐ Wood Frame ☐ State Certified Modular	Sprinkler system: N/A ☐ ☐ Full ☐ Partial ☐ Other Suppression # of Heads 1/100	Finished Basement ☐ Unfinished Basement ☐ Crawl space ☐ Slab on Grade ☐ No. of Bedrooms 000 Multi-family dwellings 000 No. of efficiency units: No. of 1 BR units: No. of 2 BR units: No. of 3 BR units: Other Structure: Dimensions: Footings: Roof: ☐ State Certified Modular ☐ Manufactured Home	Electric Yes ☐ No ☐ Gas Yes ☐ No ☐ Heating System: Electric ☐ Oil ☐ Natural Gas ☐ Propane Gas ☐ Sprinkler system: N/A ☐ ☐ NFPA #13D ☐ NFPA #13R ☐ Other:


THE UNDERSIGNED HEREBY CERTIFIES AND AGREES AS FOLLOWS: (1) THAT HE/SHE IS THE PERSON TO MAKE THIS APPLICATION; (2) THAT THE INFORMATION IS CORRECT; (3) THAT HE/SHE WILL COMPLY WITH ALL REGULATIONS OF HOWARD COUNTY WHICH ARE APPLICABLE THERE TO; (4) THAT HE/SHE WILL PERFORM NO WORK ON THE ABOVE REFERENCED PROPERTY NOT SPECIFICALLY DESCRIBED IN THIS APPLICATION; (5) THAT HE/SHE GRANTS COUNTY OFFICIALS THE RIGHT TO ENTER ONTO THE PROPERTY FOR THE PURPOSE OF INSPECTING THE WORK PERMITTED AND POSTING NOTICES.

Applicant's Signature	Print Name
Title/Company	Date

Checks payable to: DIRECTOR OF FINANCE OF HOWARD COUNTY
** PLEASE WRITE NEATLY AND LEGIBLY. **
FOR OFFICE USE ONLY.

AGENCY	DATE	SIGNATURE APPROVAL	DPZ SETBACK INFORMATION	PROPERTY ID#:
Land Development, DPZ			Front:	Filing fee \$
State Highway			Rear:	Permit fee \$
Building Official			Side:	Excise tax \$
Dev. Engineering, DPZ			Side St.:	Sub-total paid \$
Health	6/1/00	Mark Rife	All minimum setbacks met?	Add'l permit fee \$
Fire Protection			YES ☐ NO ☐	TOTAL FEES \$
Is Sediment Control approval required prior to issuance?			Is Entrance Permit required?	Balance due \$
YES ☐ NO ☐			YES ☐ NO ☐	Check #
CONTINGENCY CONSTRUCTION START: ☐			Historic District?	Validation #
ONE STOP SHOP: ☐			YES ☐ NO ☐	
			Lot Coverage for New Town Zone	Accepted by
			SDP/Red-line approval date	

21658

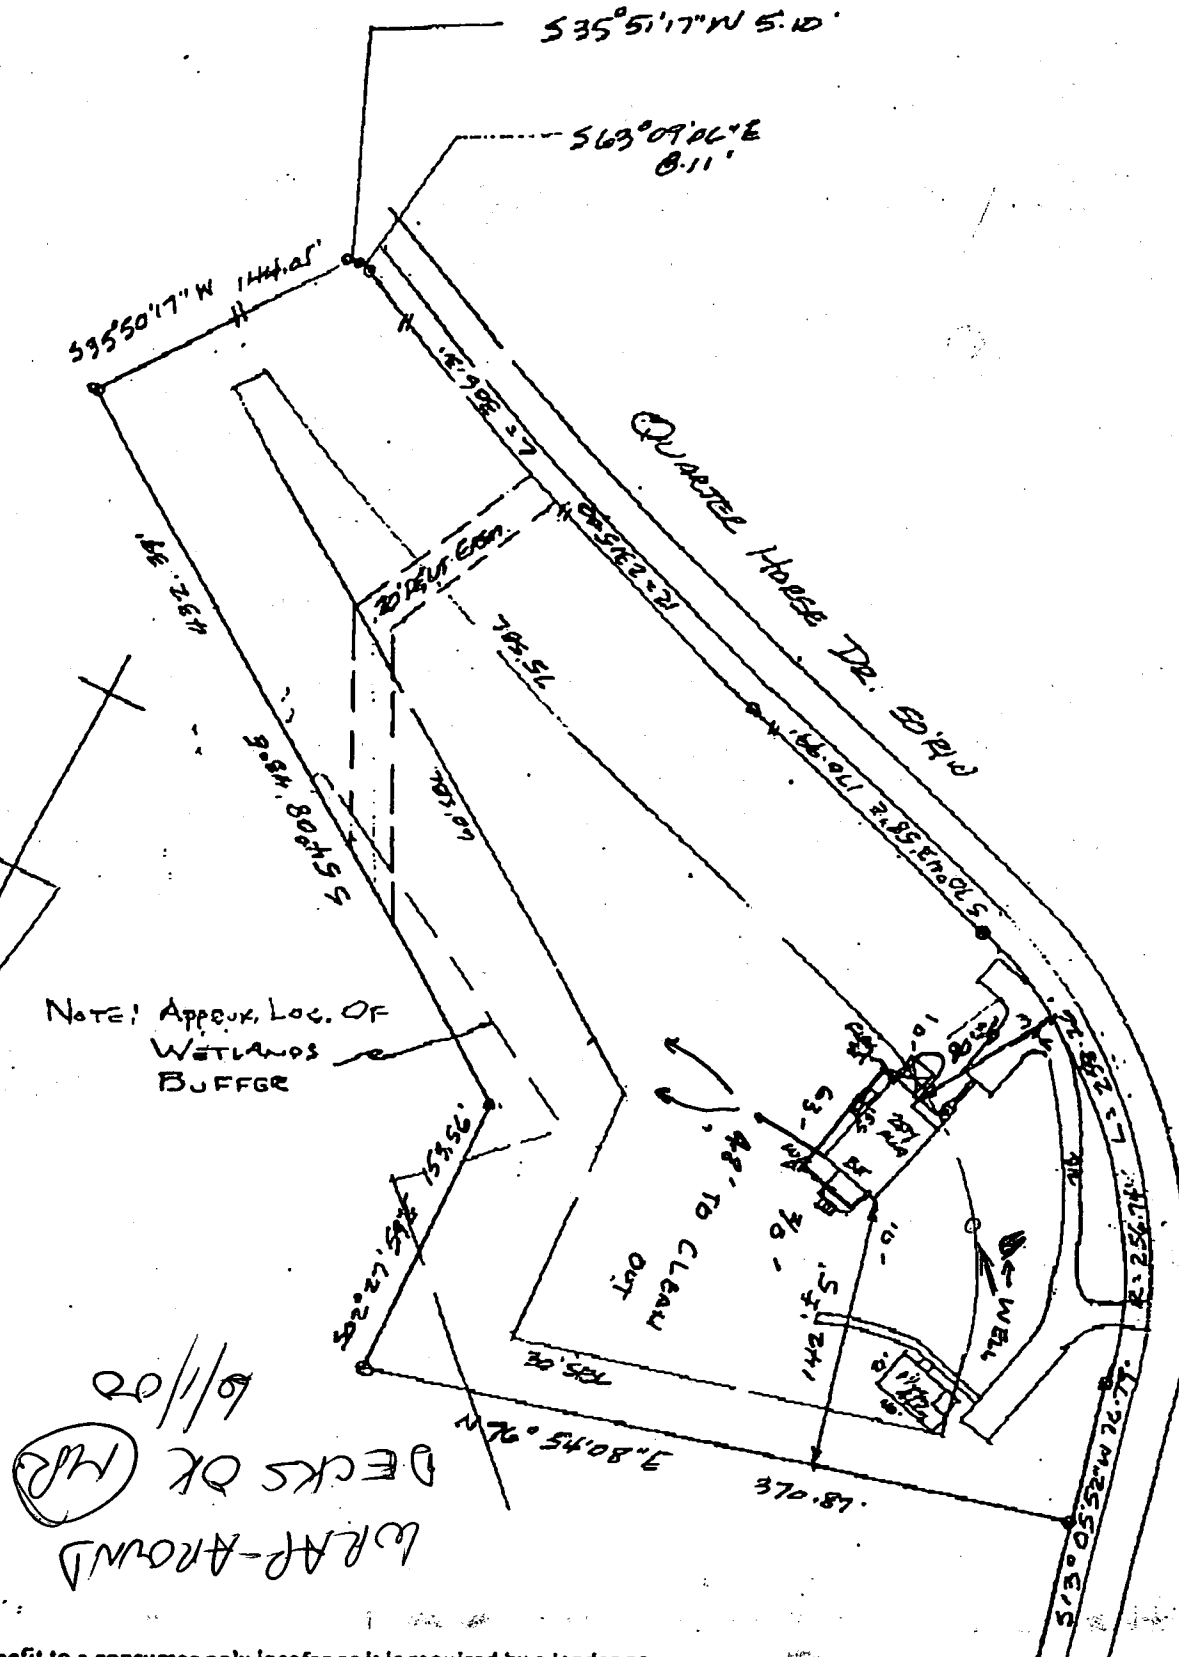

NOTE: Approx. Loc. OF
WETLANDS
BUFFER

WARR-AROUND
DECKS OK (MR)
6/1/02

The plat is of benefit to a consumer only insofar as it is required by a lender or title insurance company or its agent in connection with contemplated transfer, financing or refinancing. The plat is not to be relied upon for the establishment of location of fences, garages, buildings, or other existing or future improvements. The plat does not provide for the accurate identification of

#1806 QUARTER HORSE DRIVE
LOT 13 - PARKSIDE #9682