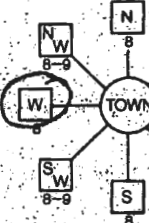
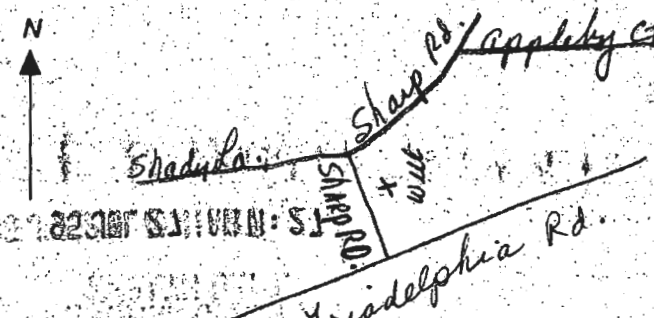


C1 2824	SEQUENCE NO. (MDE USE ONLY)	STATE OF MARYLAND WELL COMPLETION REPORT FILL IN THIS FORM COMPLETELY PLEASE PRINT OR TYPE	THIS REPORT MUST BE SUBMITTED WITHIN 45 DAYS AFTER WELL IS COMPLETED. COUNTY NUMBER A-41282																		
(THIS NUMBER IS TO BE PUNCHED IN COLS. 3-6 ON ALL CARDS)		PERMIT NO. FROM "PERMIT TO DRILL WELL"																			
ST/CO USE ONLY DATE RECEIVED <div style="border: 1px solid black; padding: 2px;"> 7 2 7 9 5 </div>	DATE WELL COMPLETED <div style="border: 1px solid black; padding: 2px;"> 0 9 0 7 9 5 </div>	Depth of Well <div style="border: 1px solid black; padding: 2px;"> 2 0 0 </div> (TO NEAREST FOOT)																			
OWNER MENOLIS STREET OR RFD SHARP ROAD SUBDIVISION SHARP FARMS		TOWN CLEVELAND SECTION 30 LOT 30																			
WELL LOG Not required for driven wells STATE THE KIND OF FORMATIONS PENETRATED, THEIR COLOR, DEPTH, THICKNESS AND IF WATER BEARING		GROUTING RECORD WELL HAS BEEN GROUTED (Circle Appropriate Box) TYPE OF GROUTING MATERIAL (Circle one) CEMENT CM BENTONITE CLAY BC NO. OF BAGS 10 NO. OF POUNDS 940 GALLONS OF WATER 60 DEPTH OF GROUT SEAL (to nearest foot) from 0 ft. to 27 ft. (enter 0 if from surface)																			
<table border="1" style="width:100%; border-collapse: collapse;"> <thead> <tr> <th rowspan="2">DESCRIPTION (Use additional sheets if needed)</th> <th colspan="2">FEET</th> <th rowspan="2">check if water bearing</th> </tr> <tr> <th>FROM</th> <th>TO</th> </tr> </thead> <tbody> <tr> <td style="height: 40px;">Sand</td> <td>0</td> <td>28</td> <td></td> </tr> <tr> <td style="height: 40px;">Gray Mica</td> <td>28</td> <td>200</td> <td></td> </tr> <tr> <td style="height: 40px;">Rock</td> <td></td> <td></td> <td></td> </tr> </tbody> </table>		DESCRIPTION (Use additional sheets if needed)	FEET		check if water bearing	FROM	TO	Sand	0	28		Gray Mica	28	200		Rock				CASING RECORD casing types appropriate code below <div style="display: flex; justify-content: space-around;"> <div style="border: 1px solid black; padding: 2px; text-align: center;"> ST STEEL </div> <div style="border: 1px solid black; padding: 2px; text-align: center;"> CO CONCRETE </div> </div> <div style="display: flex; justify-content: space-around;"> <div style="border: 1px solid black; padding: 2px; text-align: center;"> PL PLASTIC </div> <div style="border: 1px solid black; padding: 2px; text-align: center;"> OT OTHER </div> </div> MAIN CASING TYPE ST Nominal diameter top (main) casing (nearest inch) 6 Total depth of main casing (nearest foot) 31	
DESCRIPTION (Use additional sheets if needed)	FEET		check if water bearing																		
	FROM	TO																			
Sand	0	28																			
Gray Mica	28	200																			
Rock																					
NUMBER OF UNSUCCESSFUL WELLS: 0		OTHER CASING (if used) EACH CASING diameter inch depth (feet) from to <div style="border: 1px solid black; height: 40px; width: 100%;"></div>																			
WELL HYDROFRACTURED Y N		SCREEN RECORD screen type or open hole insert appropriate code below <div style="display: flex; justify-content: space-around;"> <div style="border: 1px solid black; padding: 2px; text-align: center;"> ST STEEL </div> <div style="border: 1px solid black; padding: 2px; text-align: center;"> BR BRASS BRONZE </div> <div style="border: 1px solid black; padding: 2px; text-align: center;"> HO OPEN HOLE </div> </div> <div style="display: flex; justify-content: space-around;"> <div style="border: 1px solid black; padding: 2px; text-align: center;"> PL PLASTIC </div> <div style="border: 1px solid black; padding: 2px; text-align: center;"> OT OTHER </div> </div>																			
CIRCLE APPROPRIATE LETTER A A WELL WAS ABANDONED AND SEALED WHEN THIS WELL WAS COMPLETED E ELECTRIC LOG OBTAINED P TEST WELL CONVERTED TO PRODUCTION WELL I HEREBY CERTIFY THAT THIS WELL HAS BEEN CONSTRUCTED IN ACCORDANCE WITH COMAR 26.04.04 "WELL CONSTRUCTION" AND IN CONFORMANCE WITH ALL CONDITIONS STATED IN THE ABOVE CAPTIONED PERMIT, AND THAT THE INFORMATION PRESENTED HEREIN IS ACCURATE AND COMPLETE TO THE BEST OF MY KNOWLEDGE		DEPTH (nearest ft.) <div style="border: 1px solid black; padding: 2px;"> 1 2 3 100 </div>																			
TYPE MWD/MSD/MSD DRILLERS LIC. NO. 24 DRILLERS SIGNATURE Joseph P. Mayne (MUST MATCH SIGNATURE ON APPLICATION) LIC. NO. 27 SITE SUPERVISOR (sign. of driller or journeyman responsible for sitework if different from permittee) Larry Mayne		SLOT SIZE 1 1 2 2 3 3 DIAMETER OF SCREEN 1 (NEAREST INCH) GRAVEL PACK IF WELL DRILLED WAS FLOWING WELL INSERT F IN BOX 68 68 MDE USE ONLY (NOT TO BE FILLED IN BY DRILLER) T 70 (E.R.O.S.) 72 W Q 74 75 76 TELESCOPE CASING LOG INDICATOR OTHER DATA																			
LOCATION OF WELL ON LOT SHOW PERMANENT STRUCTURE SUCH AS BUILDING, SEPTIC TANKS, AND /OR LANDMARKS AND INDICATE NOT LESS THAN TWO DISTANCES (MEASUREMENTS TO WELL) <div style="border: 1px solid black; padding: 10px; margin-top: 10px;"> </div>		PUMPING TEST HOURS PUMPED (nearest hour) 3 PUMPING RATE (gal. per min.) 12 METHOD USED TO MEASURE PUMPING RATE Bucket WATER LEVEL (distance from land surface) BEFORE PUMPING 36 ft. WHEN PUMPING 57 ft. TYPE OF PUMP USED (for test) <div style="display: flex; justify-content: space-around;"> <div style="border: 1px solid black; padding: 2px; text-align: center;"> A air </div> <div style="border: 1px solid black; padding: 2px; text-align: center;"> P piston </div> <div style="border: 1px solid black; padding: 2px; text-align: center;"> T turbine </div> </div> <div style="display: flex; justify-content: space-around;"> <div style="border: 1px solid black; padding: 2px; text-align: center;"> C centrifugal </div> <div style="border: 1px solid black; padding: 2px; text-align: center;"> R rotary </div> <div style="border: 1px solid black; padding: 2px; text-align: center;"> O other (describe below) </div> </div> <div style="border: 1px solid black; padding: 2px; text-align: center;"> J jet </div> <div style="border: 1px solid black; padding: 2px; text-align: center;"> S submersible </div>																			
PUMP INSTALLED DRILLER WILL INSTALL PUMP (YES or NO) NO IF DRILLER INSTALLS PUMP, THIS SECTION MUST BE COMPLETED FOR ALL WELLS. TYPE OF PUMP INSTALLED PLACE (A,C,J,P,R,S,T,O) IN BOX 29 29 CAPACITY GALLONS PER MINUTE (to nearest gallon) 31 35 PUMP HORSE POWER 37 41 PUMP COLUMN LENGTH (nearest ft.) 43 47 CASING HEIGHT (circle appropriate box and enter casing height) <div style="display: flex; justify-content: space-around;"> <div style="border: 1px solid black; padding: 2px; text-align: center;"> + above </div> <div style="border: 1px solid black; padding: 2px; text-align: center;"> - below </div> </div> LAND SURFACE 1 (nearest foot)																					

COUNTY

EMERGENCY/TEMP NO. IF ANY

B 1 5521		SEQUENCE NO. (DP USE ONLY)		STATE OF MARYLAND APPLICATION FOR PERMIT TO DRILL WELL please print or type		STATE PERMIT NUMBER 40-99-0657 <small>fill in this form completely</small>	
<small>(THIS NUMBER IS TO BE PUNCHED IN COLS. 3-6 ON ALL CARDS)</small>							
OWNER INFORMATION Date Received (APA) 7/27/95 OWNER: MENDIS, MATTHEW 2848 SHANANDALE DR SILVER SPRING MD 20904				LOCATION OF WELL HOWARD SHARP FARMS SECTION 44 LOT 30 GLENELG MILES FROM TOWN 2 MI			
DRILLER INFORMATION Driller's Name: Joseph L. MAYNE Firm Name: Joseph L. Mayne Well Drilling Address: 5512 Ridge Rd. Mt. Airy MD 21771 Signature: Joseph L. Mayne Date: 7/25/95 MSD/MGD/MWD 24 License No. 80				B 3 DIRECTION OF WELL FROM TOWN (CIRCLE BOX)  NEAR WHAT ROAD: SHARP RD. ON WHICH SIDE OF ROAD (CIRCLE APPROPRIATE BOX): WEST DISTANCE FROM ROAD: 1.80 ENTER FT OR MI: FT			
B 2 WELL INFORMATION APPROX. PUMPING RATE (GAL. PER MIN.) 5 AVERAGE DAILY QUANTITY NEEDED (GAL. PER DAY) 500				B 4 NOT TO BE FILLED IN BY DRILLER HEALTH DEPARTMENT APPROVAL COUNTY NAME: HOWARD COUNTY NO. A-41282 STATE SIGNATURE: [Signature] DATE ISSUED: 8/29/95 CO. SIGNATURE: [Signature] EXP. DATE: 8/29/95 NORTH GRID: 520000 EAST GRID: 797000			
USE FOR WATER (CIRCLE APPROPRIATE BOX) <input checked="" type="radio"/> HOME (SINGLE OR DOUBLE HOUSEHOLD UNIT ONLY) <input type="radio"/> FARMING (LIVESTOCK WATERING & AGRICULTURAL IRRIGATION) <input type="radio"/> INDUSTRIAL, COMMERCIAL, STATE AND FEDERAL GOV. OTHER (REQUIRES APPROPRIATION PERMIT) <input type="radio"/> PUBLIC OR PRIVATE WATER COMPANY (REQUIRES APPROPRIATION PERMIT AND STATE HEALTH DEPARTMENT APPROVAL) <input type="radio"/> TEST, OBSERVATION, MONITORING (MAY REQUIRE APPROPRIATION PERMIT)							
APPROXIMATE DEPTH OF WELL 300 FEET				SHOW MAJOR FEATURES OF BOX & LOCATE WELL WITH AN X			
APPROXIMATE DIAMETER OF WELL 6 INCH				SOURCES OF DRILLING WATER 1. Well			
METHOD OF DRILLING (circle one) BORED (for Augered) JETTED Jetted & DRIVEN AIR-ROTARY AIR-PERCussion ROTARY (Hydraulic Rotary) CABLE Reverse-ROTARY Drive-POINT other:				WRITE THE BOX NUMBER FROM THE MAP HERE E 7907 N 520			
REPLACEMENT OR DEEPEMED WELLS (CIRCLE APPROPRIATE BOX) <input checked="" type="radio"/> THIS WELL WILL NOT REPLACE AN EXISTING WELL <input type="radio"/> THIS WELL WILL REPLACE A WELL THAT WILL BE ABANDONED AND SEALED <input type="radio"/> THIS WELL WILL REPLACE A WELL THAT WILL BE USED AS A STANDBY - CONTACT LOCAL APPROVING AUTHORITY FOR POLICY ON STANDBY WELLS <input type="radio"/> THIS WELL WILL DEEPM AN EXISTING WELL PERMIT NUMBER OF WELL TO BE REPLACED OR DEEPMED (IF AVAILABLE):				DRAW A SKETCH BELOW SHOWING LOCATION OF WELL IN RELATION TO NEARBY TOWNS AND ROADS AND GIVE DISTANCE FROM WELL TO NEAREST ROAD JUNCTION 			
Not to be filled in by driller (OEP USE ONLY) APPROP. PERMIT NUMBER: GAP FORCE 55 WRITE INITIALS IN BOX: PERMIT No. 40-99-0657							
SPECIAL CONDITIONS				NOTE - APPROVING AUTHORITIES SHOULD USE SEPARATE SHEET IF NEEDED -			

COUNTY

Helen Smart

HOWARD COUNTY HEALTH DEPARTMENT
Bureau of Environmental Health
3525-H Ellicott Mills Drive
Ellicott City, MD 21043
461-9933

313-2640

313-2648 Fax

APPLICATION FOR PITLESS ADAPTER, WELL PUMP AND PRESSURE TANK INSTALLATION

New Installation ☒
Replacement ☐

Receipt # _____

Date _____

Name of Installer Thompson's P & H

Telephone 465-8818

License Number 1801

Certified Well Pump Installer _____

Well Driller _____

Registered Plumber ☒

Name of Property Owner Scott Bazile

Subdivision SHARP

Site Address 3939 SHARP RD

Telephone CHEN

Well Tag # _____

Pump

1. Type

a. Deep well jet _____

b. Shallow well jet _____

c. Submersible ☒

2. Make WILCOX

3. Model # 3ET 5K-3

4. Capacity 5 GPM

5. Pump exceeds well capacity Yes _____ No ☒

6. If Yes, is low pressure cutoff switch installed? Yes _____ No _____

7. What methods are used to protect the pump and electrical wiring from vibrations? Torque arrestors _____ Cable guards _____ Other _____

Motor

1. Horsepower 1/2

2. RPM 3400

3. Voltage _____

a. 110 _____

b. 220 ☒

Pitless Adapter

1. Make WILCOX

2. Model # _____

3. Depth 700 LB

Tank

1. Capacity 203

2. Pressure relief valve? ☒

Piping

1. Type PLASTIC

2. Size 1" 160 LB

3. NSF and/or BOCA Code approved _____

4. Depth of supply line 3

Well data

1. Depth 200 ft.

2. Yield 15 GPM

3. Static water level 50 ft.

4. Will water supply be disinfected by installer? Plumber

I understand that it is my responsibility to notify the Howard County Health Department when the installation is ready for inspection (otherwise this permit is null and void).

All information given above is true to the best of my knowledge.

WPI OK

5/21/99-SRU

Signature of Applicant: [Signature]

Date: 5-21-99

Note: A sticker indicating approval/status of the installation will be placed on the well casing at the time of the inspection.

FISI
CONS

ROAD

LOT 14
3.924 AC.

LOT 13
8/25/95 WSI
STAKE AND MOVED
CALL DRILLER

8/23/95
STAKE WELL
FRONT OR REAR CURVED
B.R.L. IN EITHER
\$51.88

8/29/95 WSI
SITE ACCEPTABLE
W. L. Brown

150-10-500
CLEARANCE
OF WORK SITE
N28
1520-500

3939 Sharp Road

S.T. into
off house
Sept 100'

51'

59'

30'

Well 32'

BA-94-0607

60'

Geo bore

10'

Driveway

Prop
Line

Shared
Drive
to
Neighbors
Houses

6/6/12
Geo Bore locations
Approved.
(KMS)

Sharp Road