

APPLICATION

PERCOLATION TESTING

INDEXED

44269
A 42445
P _____

HOWARD COUNTY HEALTH DEPARTMENT
BUREAU OF ENVIRONMENTAL HEALTH
P.O. BOX 476 ELLICOTT CITY, MARYLAND, 21043
TELEPHONE: 461-9933

7/6/88
Check is in

DISTRICT 3
DATE 8-25-88

9/6/88 Cancel Subdivision
hand in Farmland Preservation
Per Mark Rich. S. ab

TO: THE COUNTY HEALTH OFFICER
ELLICOTT CITY, MARYLAND

I, HEREBY, APPLY FOR THE NECESSARY TEST IN ORDER TO CONSTRUCT (OR RECONSTRUCT) A SEWAGE DISPOSAL SYSTEM.

PROPERTY OWNER Vincent Bracciale

ADDRESS 1830 Woodstock Rd PHONE 465-5855 Ho Co. Land Serv.

PROSPECTIVE BUYER N/A

ADDRESS _____ PHONE _____

PROPERTY LOCATION:

SUBDIVISION Bracciale Property LOT NO. 5 Bon Prelim.

ROAD AND DESCRIPTION Woodstock Rd north of Md Rt 99

TAX MAP 10 PARCEL # 36

SIZE OF LOT 3.76 ± TYPE BLDG SFD
(SINGLE FAMILY DWELLING OR COMMERCIAL)

THE SYSTEM INSTALLED UNDER THIS APPLICATION IS ACCEPTABLE ONLY UNTIL PUBLIC FACILITIES BECOME AVAILABLE. I FULLY UNDERSTAND THE
FEE CONNECTED WITH THE FILING OF THIS PERC TEST APPLICATION IS NON-REFUNDABLE UNDER ANY CIRCUMSTANCES. I ALSO AGREE TO COMPLY
WITH ALL M.O.S.H.A. REQUIREMENTS IN TESTING THIS LOT.

Mal Rich
(SIGNATURE OF APPLICANT)

APPROVED BY _____ FOR _____ DATE _____

REJECTED BY _____ FOR _____ DATE _____

HOLD PENDING FURTHER TESTS _____ DATE _____

REASONS FOR REJECTION OR HOLDING 5-22-89 Per Satisfactory hold for plat S. ab

THIS IS NOT A PERMIT


44269

LOTS
SOIL PROFILE

0'
2" A1-3
Yellow GA
Silty loam
C12% clay
C16%
frag

2- Brown
Silty loam
20-25%
frag

10-

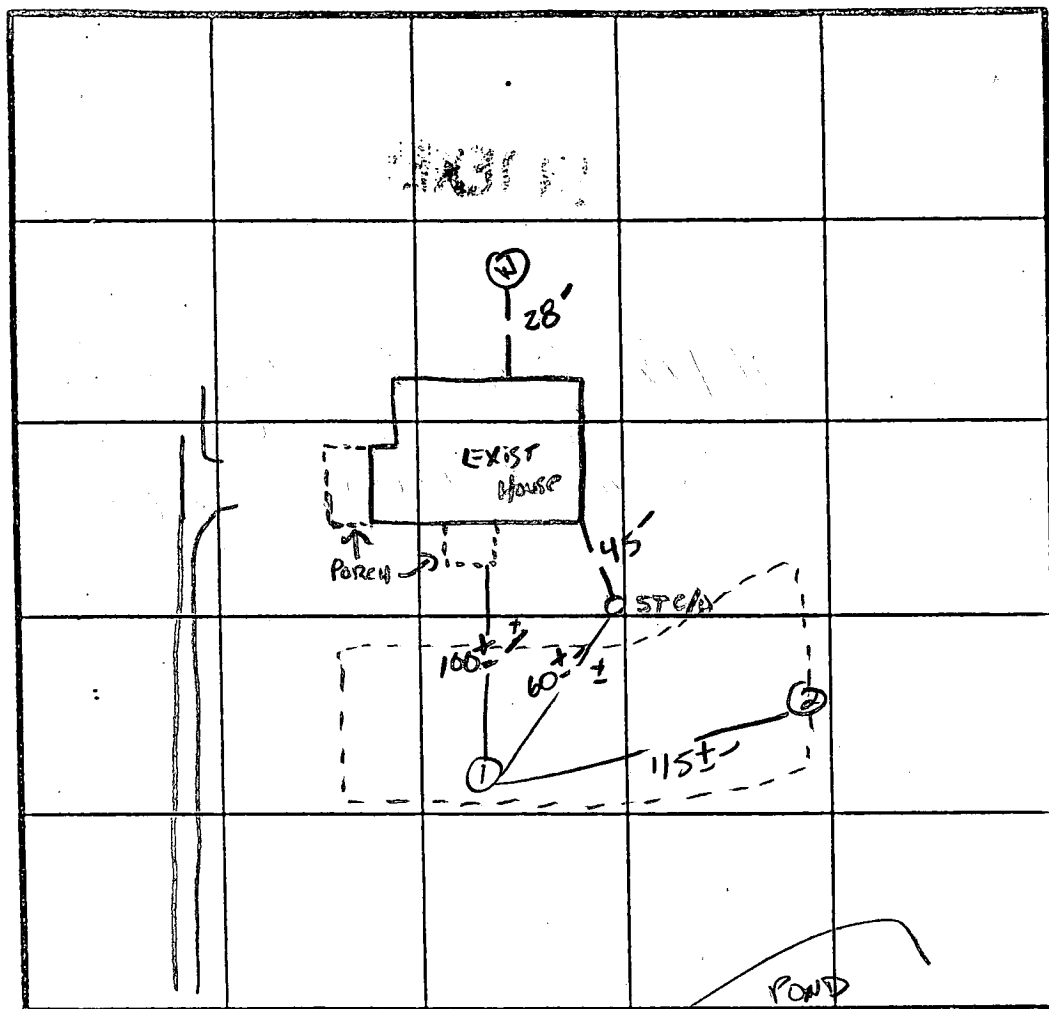

2 Perc 2mm
 180 #/sq
 Inlet 2.0
 Bottom 6.0

INDICATE NORTH - NAME ADJOINING ROADWAY AS BASE LINE
WOODSTOCK Rd.

[illegible]

REMARKS Holes for lower STAKES

TYPE OF SOIL clayey

TESTED BY S. Abel ALSO PRESENT OKS. Dale, John

ALSO PRESENT OK JP.
Date: Jblin 2