

APPLICATION

A 41282

SEWAGE DISPOSAL TESTING

P _____

STATE OF MARYLAND - DEPARTMENT OF HEALTH AND MENTAL HYGIENE

HOWARD COUNTY HEALTH DEPARTMENT
ENVIRONMENTAL HEALTH SERVICES

DISTRICT 4th

P. O. BOX 476, ELLICOTT CITY, MARYLAND 21043
TELEPHONE: 465-5000, EXT. 356

DATE 3/24/88

TO: THE COUNTY HEALTH OFFICER
ELLICOTT CITY, MARYLAND

I, HEREBY, APPLY FOR THE NECESSARY TEST IN ORDER TO CONSTRUCT (OR RECONSTRUCT) A SEWAGE DISPOSAL SYSTEM.

PROPERTY OWNER CHARLES A. SHARP Michelle

ADDRESS 3779 SHARP ROAD, GLENWOOD MD. 21738 PHONE 489-4630

PROPERTY LOCATION:

30 on Final

SUBDIVISION SHARP FARMS, LOTS 1-16 LOT NO. 18

ROAD AND DESCRIPTION N.W. OF INTERSECTION BETWEEN SHARP ROAD
AND SHADY LANE

BLDG. PERMIT SIGNED
AND RETURNED 12-21-95

SIZE OF LOT 3.21 AC. ± TYPE BLDG. S.F.D. - 4 BEDROOM

NUMBER OF BEDROOMS

IF NOT SINGLE RESIDENCE DESCRIBE Serial # B10115451

THE SYSTEM INSTALLED UNDER THIS APPLICATION IS ACCEPTABLE ONLY UNTIL PUBLIC FACILITIES BECOME AVAILABLE.

SIGNATURE OF APPLICANT _____

APPROVED BY _____ FOR _____ DATE _____
(KIND OF SYSTEM)

REJECTED BY _____ FOR _____ DATE _____
(KIND OF SYSTEM)

HOLD PENDING FURTHER TESTS _____ DATE _____

REASONS FOR REJECTION OR HOLDING _____

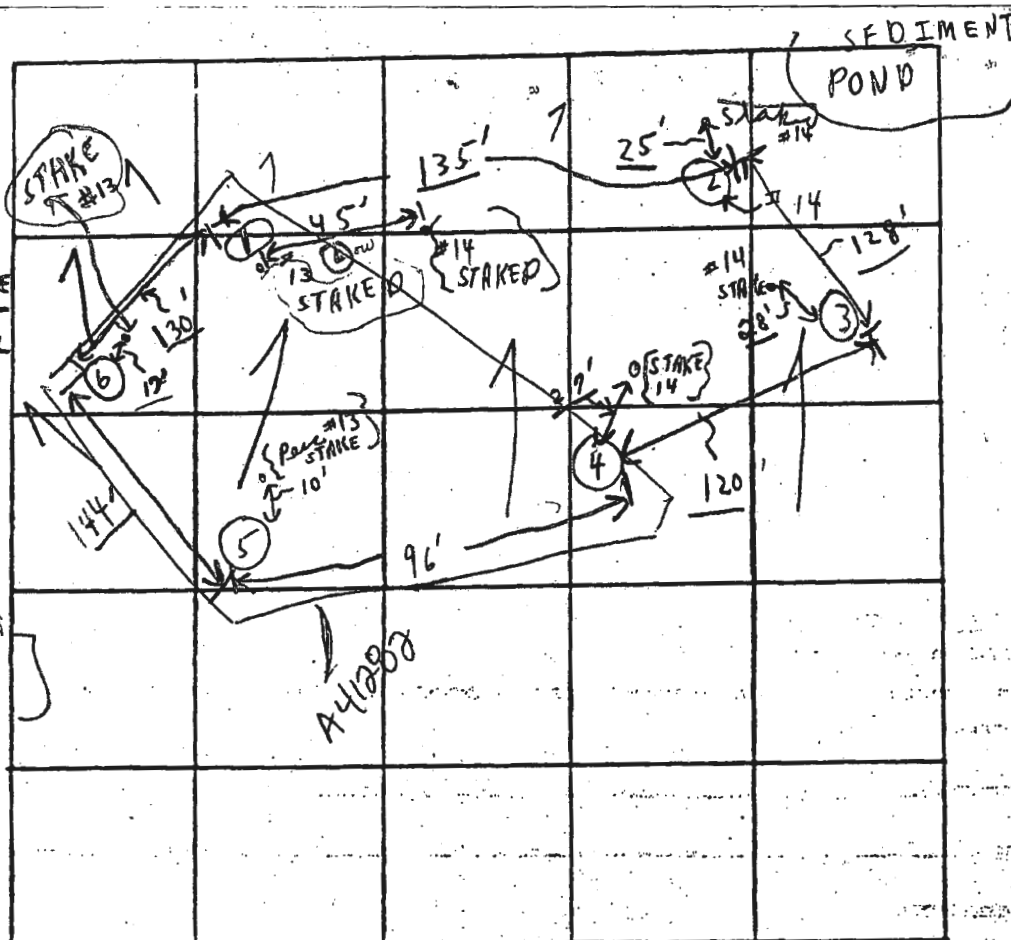
THIS IS NOT A PERMIT

#13

L O A M

PERC AREA

LOTS
= ADJ

$$(13 + 14)$$


INDICATE NORTH. - NAME ADJOINING ROADWAY AS BASE LINE

SHARP ROAD

DATE	TEST NO.	DEPTH	PRE-WET		TEST - 1" DROP		TIME
			START	STOP	START	STOP	
9/28/88	1A	3 1/2'	1:10	1:13	1:13	1:17	4"
	1B	12'	:	:	Visual	Load	M
	2A	2'	1:13	1:14	1:14	1:16	2m
	2B	11'	:	:	:	:	STOP
	3A	2'	1:27	1:29	1:29	1:31	2m
	3B	4'	1:28	1:30	1:30	1:32	2m
	4A	3 1/2'	:	:	Visual	Load	
	4B	11'	:	:	↓	:	
	5A	2 1/2'	1:38	1:40	1:40	1:43	3m
	5B	4'	1:37	1:38	1:38	1:40	2m
	6A	2 1/2'	1:45	NEARLY 4" AT 1:47		1:50	3m
REMARKS	6B	10' TEST	S: 1" PER STAPES				Load

REMARKS

TYPE OF SOIL

TESTED BY

TESTS IN OPEN

ALSO PRESENT:

some small stone p 8

{ Wandy
S. King
C. & Page }