

HOWARD COUNTY
PERMIT APPLICATION

PERMIT NUMBER

Building Address 3785 Shady Ln
Glenwood MD 21738
Suite/Apt. #: _____ SDP/WP/Petition #: _____
Census Tract _____ Subdivision _____
Section _____ Area _____ Lot _____
Tax Map _____ Parcel _____ Grid _____
Zoning _____ Map Coordinates _____ Lot size _____

Property Owner's Name Crosen, Donald
Address 3785 Shady Ln
City Glenwood State MD Zip Code 21738
Home Phone 410 544 6084 Work Phone _____
Applicant's Name & Mailing Address, (if other than stated hereon):
Karen Klayman 410 507 7705
Phone _____ Fax _____

Existing Use SFD
Proposed Use Inground pool
Estimated Construction Cost \$ 30,000
Description of Work 22'x41' inground pool,
3' to 6' depth, filled by truck,
fence to code by owner

Contractor
Contact ANTHONY & SYLVAN POOLS
556-E Ritchie Highway
Severna Park, Md. 21146
410-544-6084
M.H.I.C. 19347
Address _____
City _____
License _____
Phone _____

Occupant or Tenant _____
Contact Name _____
Address _____
City _____ State _____ Zip Code _____
Phone _____ Fax _____

Engineer or Architect Company _____
Contact Person _____
Address _____
City _____ State _____ Zip Code _____
Phone _____ Fax _____

BUILDING DESCRIPTION - COMMERCIAL

BUILDING DESCRIPTION - RESIDENTIAL

Building Characteristics	Utilities
Height: _____	Water Supply: _____ Public _____ Private _____
No. of stories: _____	Sewage Disposal: _____ Public _____ Private _____
Gross area, sq. ft. per floor: _____	Electric Yes ☐ No ☐ Gas Yes ☐ No ☐
Use group: _____	Heating System: _____ Electric ☐ Oil ☐ Natural Gas ☐ Propane Gas ☐
Construction type: _____ Reinforced Concrete _____ Structural Steel _____ Masonry _____ Wood Frame _____ State Certified Modular _____	Sprinkler system: N/A ☐ Full _____ Partial _____ Other Suppression _____ # of Heads _____

Building Characteristics	Utilities
SF Dwelling ☐ SF Townhouse ☐ Depth _____ Width _____	Water Supply: _____ Public _____ Private _____
1st floor: _____	Sewage Disposal: _____ Public _____ Private _____
2nd floor: _____	Electric Yes ☐ No ☐ Gas Yes ☐ No ☐
Basement: _____	Heating System: _____ Electric ☐ Oil ☐ Natural Gas ☐ Propane Gas ☐
Finished Basement ☐ Unfinished Basement ☐ Crawl space ☐ Slab on Grade ☐ No. of Bedrooms _____	Sprinkler system: N/A ☐ NFPA #13D _____ NFPA #13R _____ Other: _____
Height: _____	
Multi-family dwellings: _____	
No. of efficiency units: _____	
No. of 1 BR units: _____	
No. of 2 BR units: _____	
No. of 3 BR units: _____	
Other Structure: _____	
Dimensions: _____	
Footings: _____	
Roof Height: _____	
State Certified Modular _____	
Manufactured Home _____	

THE UNDERSIGNED HEREBY CERTIFIES AND AGREES AS FOLLOWS: (1) THAT HE/SHE IS AUTHORIZED TO MAKE THIS APPLICATION; (2) THAT THE INFORMATION IS CORRECT; (3) THAT HE/SHE WILL COMPLY WITH ALL REGULATIONS OF HOWARD COUNTY WHICH ARE APPLICABLE THERETO; (4) THAT HE/SHE WILL PERFORM NO WORK ON THE ABOVE REFERENCED PROPERTY NOT SPECIFICALLY DESCRIBED IN THIS APPLICATION; (5) THAT HE/SHE GRANTS COUNTY OFFICIALS THE RIGHT TO ENTER ONTO THIS PROPERTY FOR THE PURPOSE OF INSPECTING THE WORK PERMITTED AND POSTING NOTICES.

Applicant's Signature

Print Name

Title/Company

Date

Checks payable to: **DIRECTOR OF FINANCE OF HOWARD COUNTY**
** PLEASE WRITE NEATLY AND LEGIBLY. **

- FOR OFFICE USE ONLY -


AGENCY	DATE	SIGNATURE APPROVAL	DPZ SETBACK INFORMATION	PROPERTY ID#
Land Development DPZ			Front: _____	Filing fee \$ _____
State Highways			Rear: _____	Permit fee \$ _____
Building Official			Side: _____	Excise tax \$ _____
Dev. Engineering DPZ			Side St: _____	Add'l per. fee \$ _____
Health	<u>8/29/06</u>	<u>[Signature]</u>	All minimum setbacks met? YES ☐ NO ☐	TOTAL FEES \$ _____
Fire Protection			Is Entrance Permit required? YES ☐ NO ☐	Sub-total paid \$ _____
Is Sediment Control approval required prior to issuance? YES ☐ NO ☐			Historic District? YES ☐ NO ☐	Balance due \$ _____
CONTINGENCY CONSTRUCTION START: ☐			Lot Coverage for NewTown Zone _____	Check \$ _____
ONE STOP SHOP: ☐			SDP/Red-line approval date _____	Validation \$ _____
Distribution of Copies: _____	White: Building Official	Green: LOD, DPZ	Yellow: DED, DPZ	Pink: Health
Telephone: PERMIT.FRM				Gold: SHA

8/29/2006


SITE INSPECTION SHEET

OWNER: Donald Crosen PHONE #: 410-544-6084
 ADDRESS: 3785 Shady Lane CONTRACTOR: Anthony & Sylvan Pals
 WELL TAG #: _____
 SUBDIVISION: Sharp Farms LOT: _____ COUNTY #: A516427
 PROPOSAL: File missing, i.e. no as-built info available. Locate septic system components relative to proposed pool excavation.

LOCATION DIAGRAM

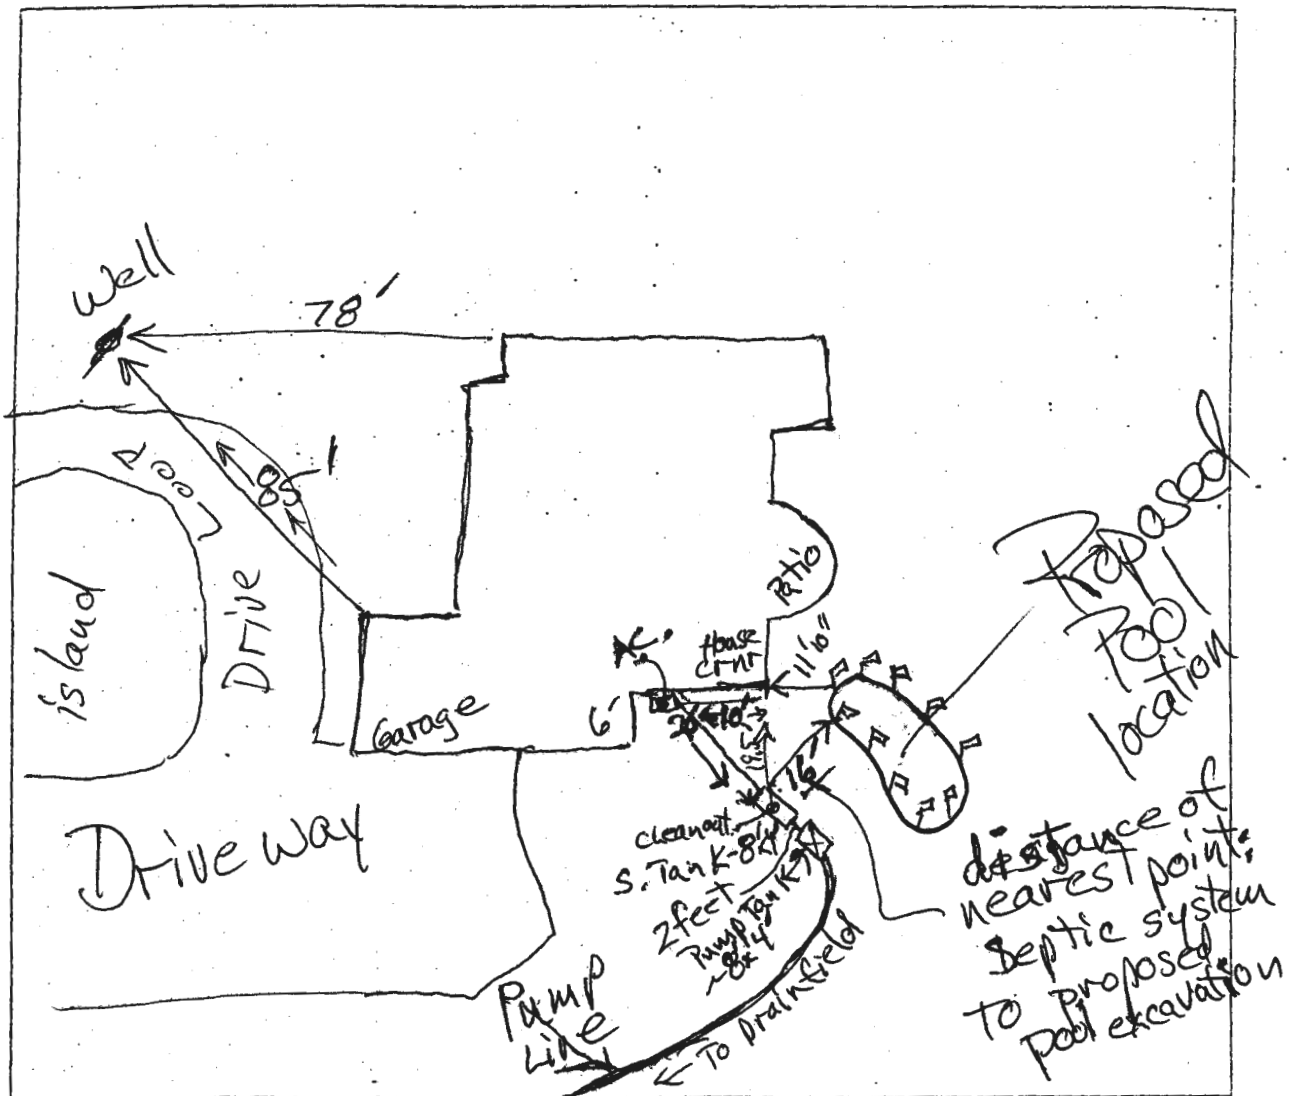

COMMENTS: Wastewater line exits house 10' from corner, i.e. under the 'Central Air' unit. Tanks oriented as shown. Cleanout is on septic tank ~19.5' from wall at corner & 22' from wall at A.C. unit. Corner of ^{septic} tank is ~16' from nearest pin flag. Robert A. Bucher

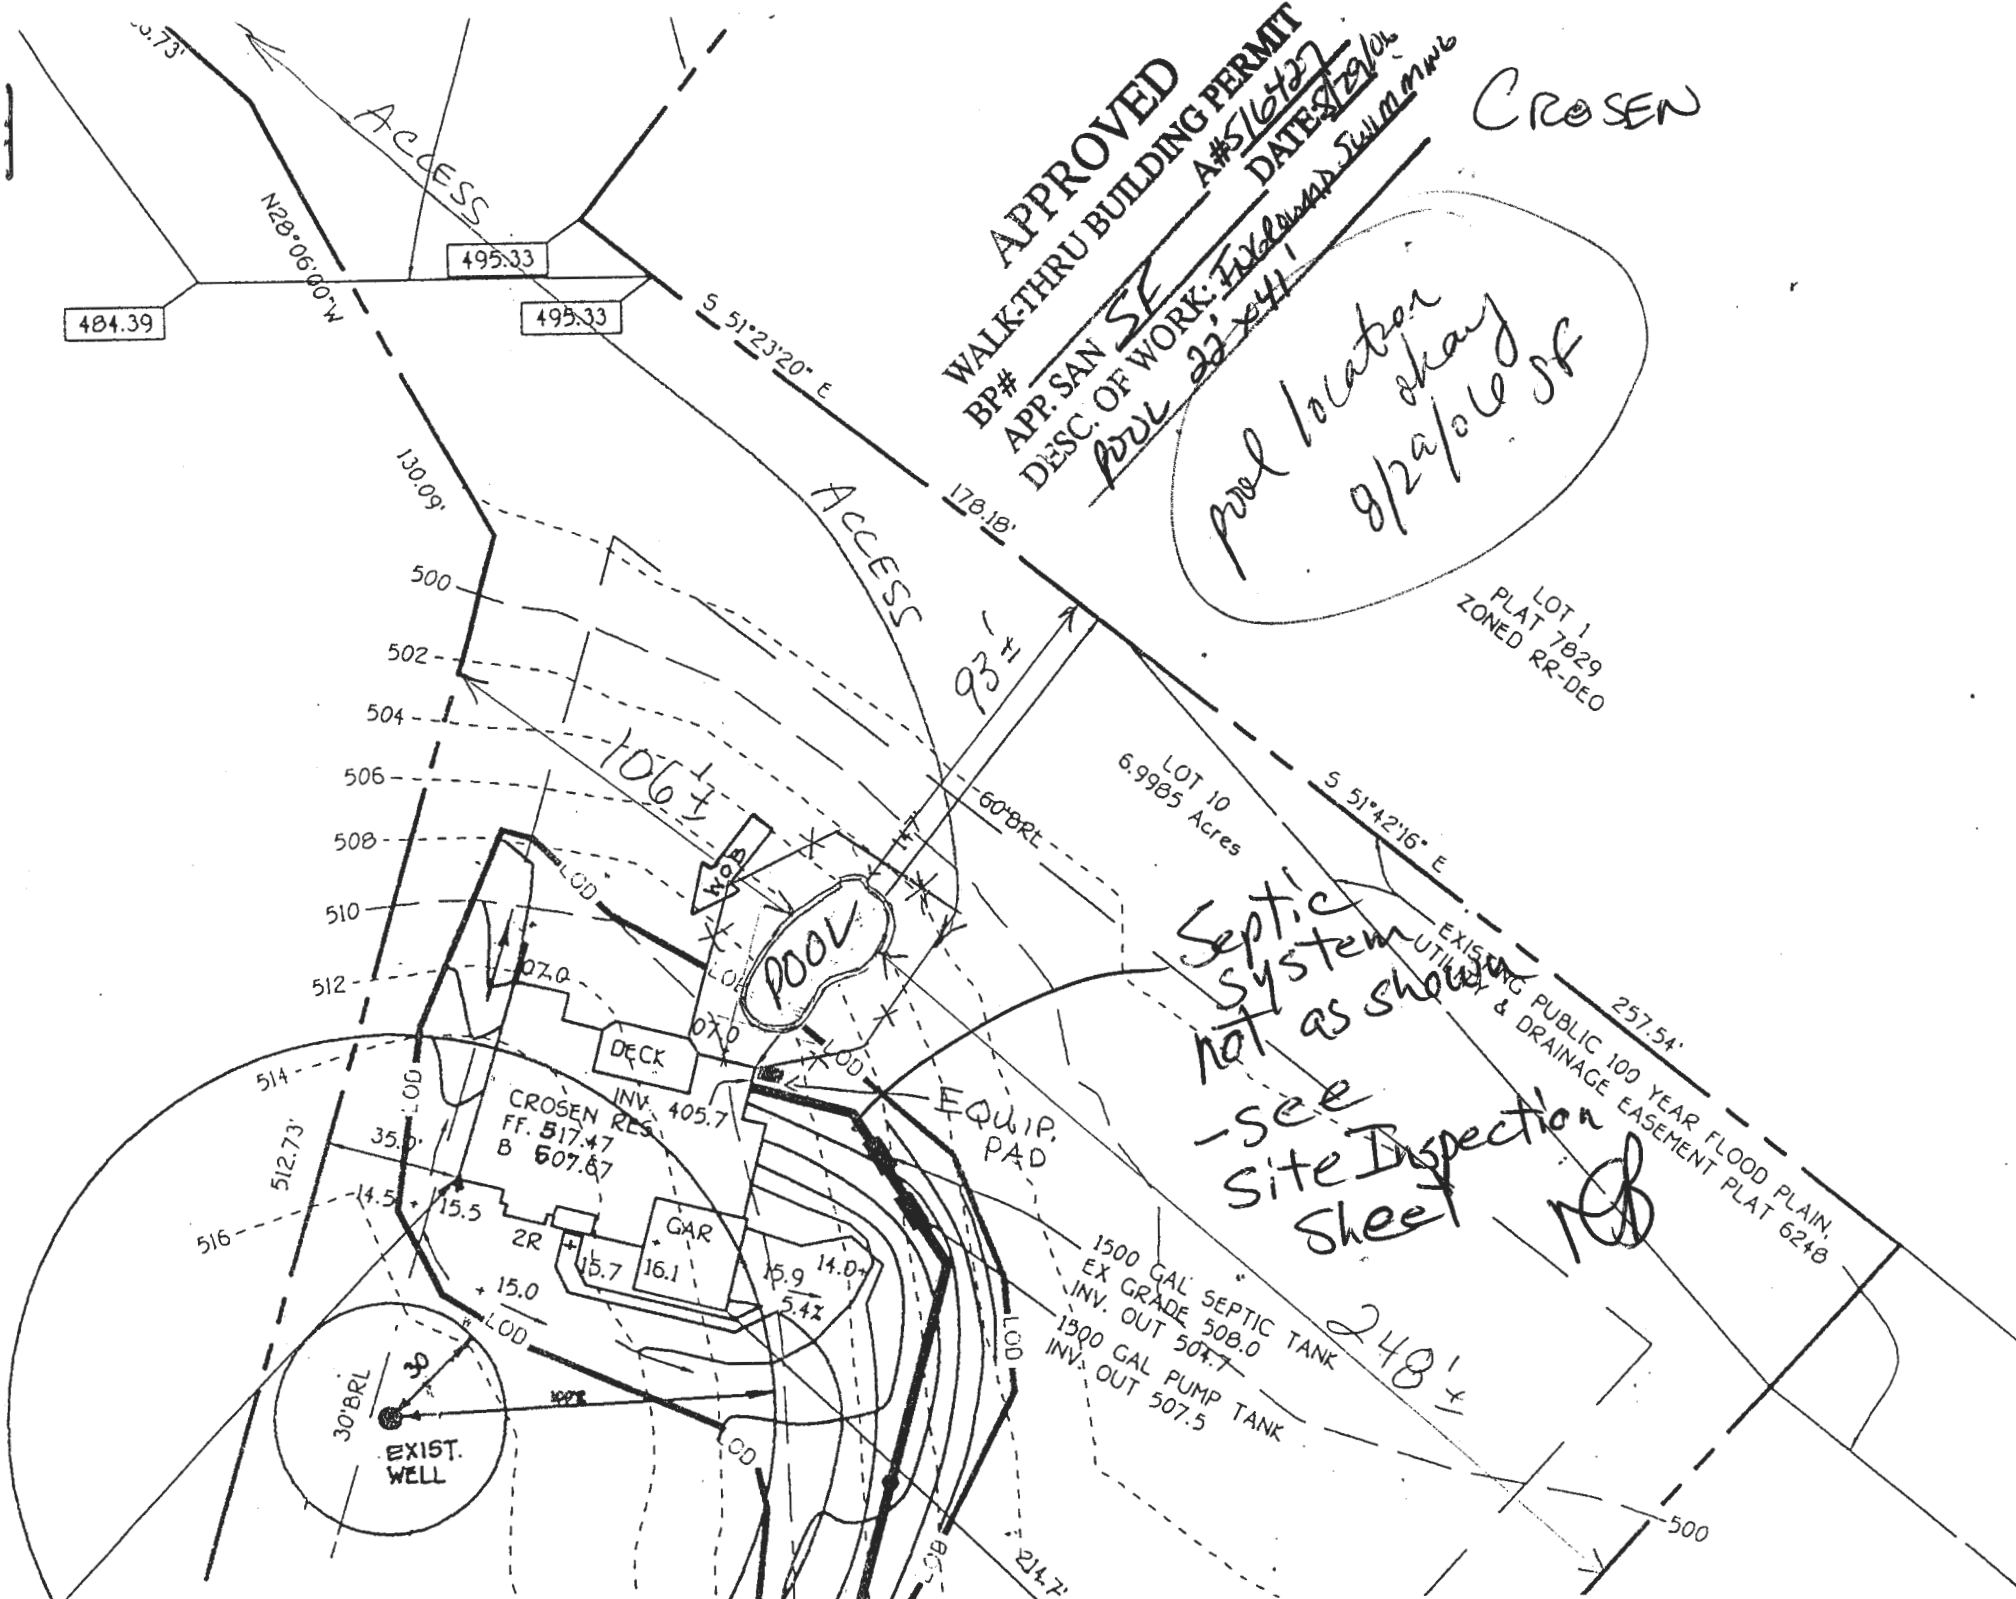

APPROVED
WALK-THRU BUILDING PERMIT
BP#
APP. SAN SF
DESC. OF WORK: Pool
DATE: 8/29/06
BY:

pool location
okay
8/29/06 SF

Septic system
not as shown
- see
Site Inspection
Sheet

CROSEN

248'

HOWARD COUNTY HEALTH DEPARTMENT Completed Septic System

P 516948 A 516427
DATE 4/24/2002

LOCATION 3785 Shady Lane
Sharp Farms
LOT 10
APPLICANT _____
OWNER _____
PERMITTEE Jack Fyock Septic Service

APPLICATION
HOLD ()
APPROVED ()
REJECTED ()

INSTALLATION
HOLD ()
APPROVED ()

APPROVED
DATE 10/04/2002

30' BRL
EXIST.
WELL

516
512.73
514
512
14.5
35.0
15.5
15.0
2R
15.7
16.1
GAR
15.9
14.0
5.4
1500 GAL SEPTIC TANK
EX. GRADE 508.0
INV. OUT 507.5
1500 GAL PUMP TANK
INV. OUT 507.5


CROSEN
FF. 517.47
B 507.47
DECK
INV. 405.7
EQUIP. PAD
POOL
1067
60' BRL
LOT 10
6.9985 Acres
51' 42.16" E
257.54'
EXISTING PUBLIC 100 YEAR FLOOD PLAIN
UTILITY & DRAINAGE EASEMENT PLAT 621B

Access
178.10'
63'
178.10'
51' 23.20" E
495.33

LOT 1
PLAT 7829
ZONED RR-DEO

location not as shown
2481 x
see site inspection sheet
red

CROSEN

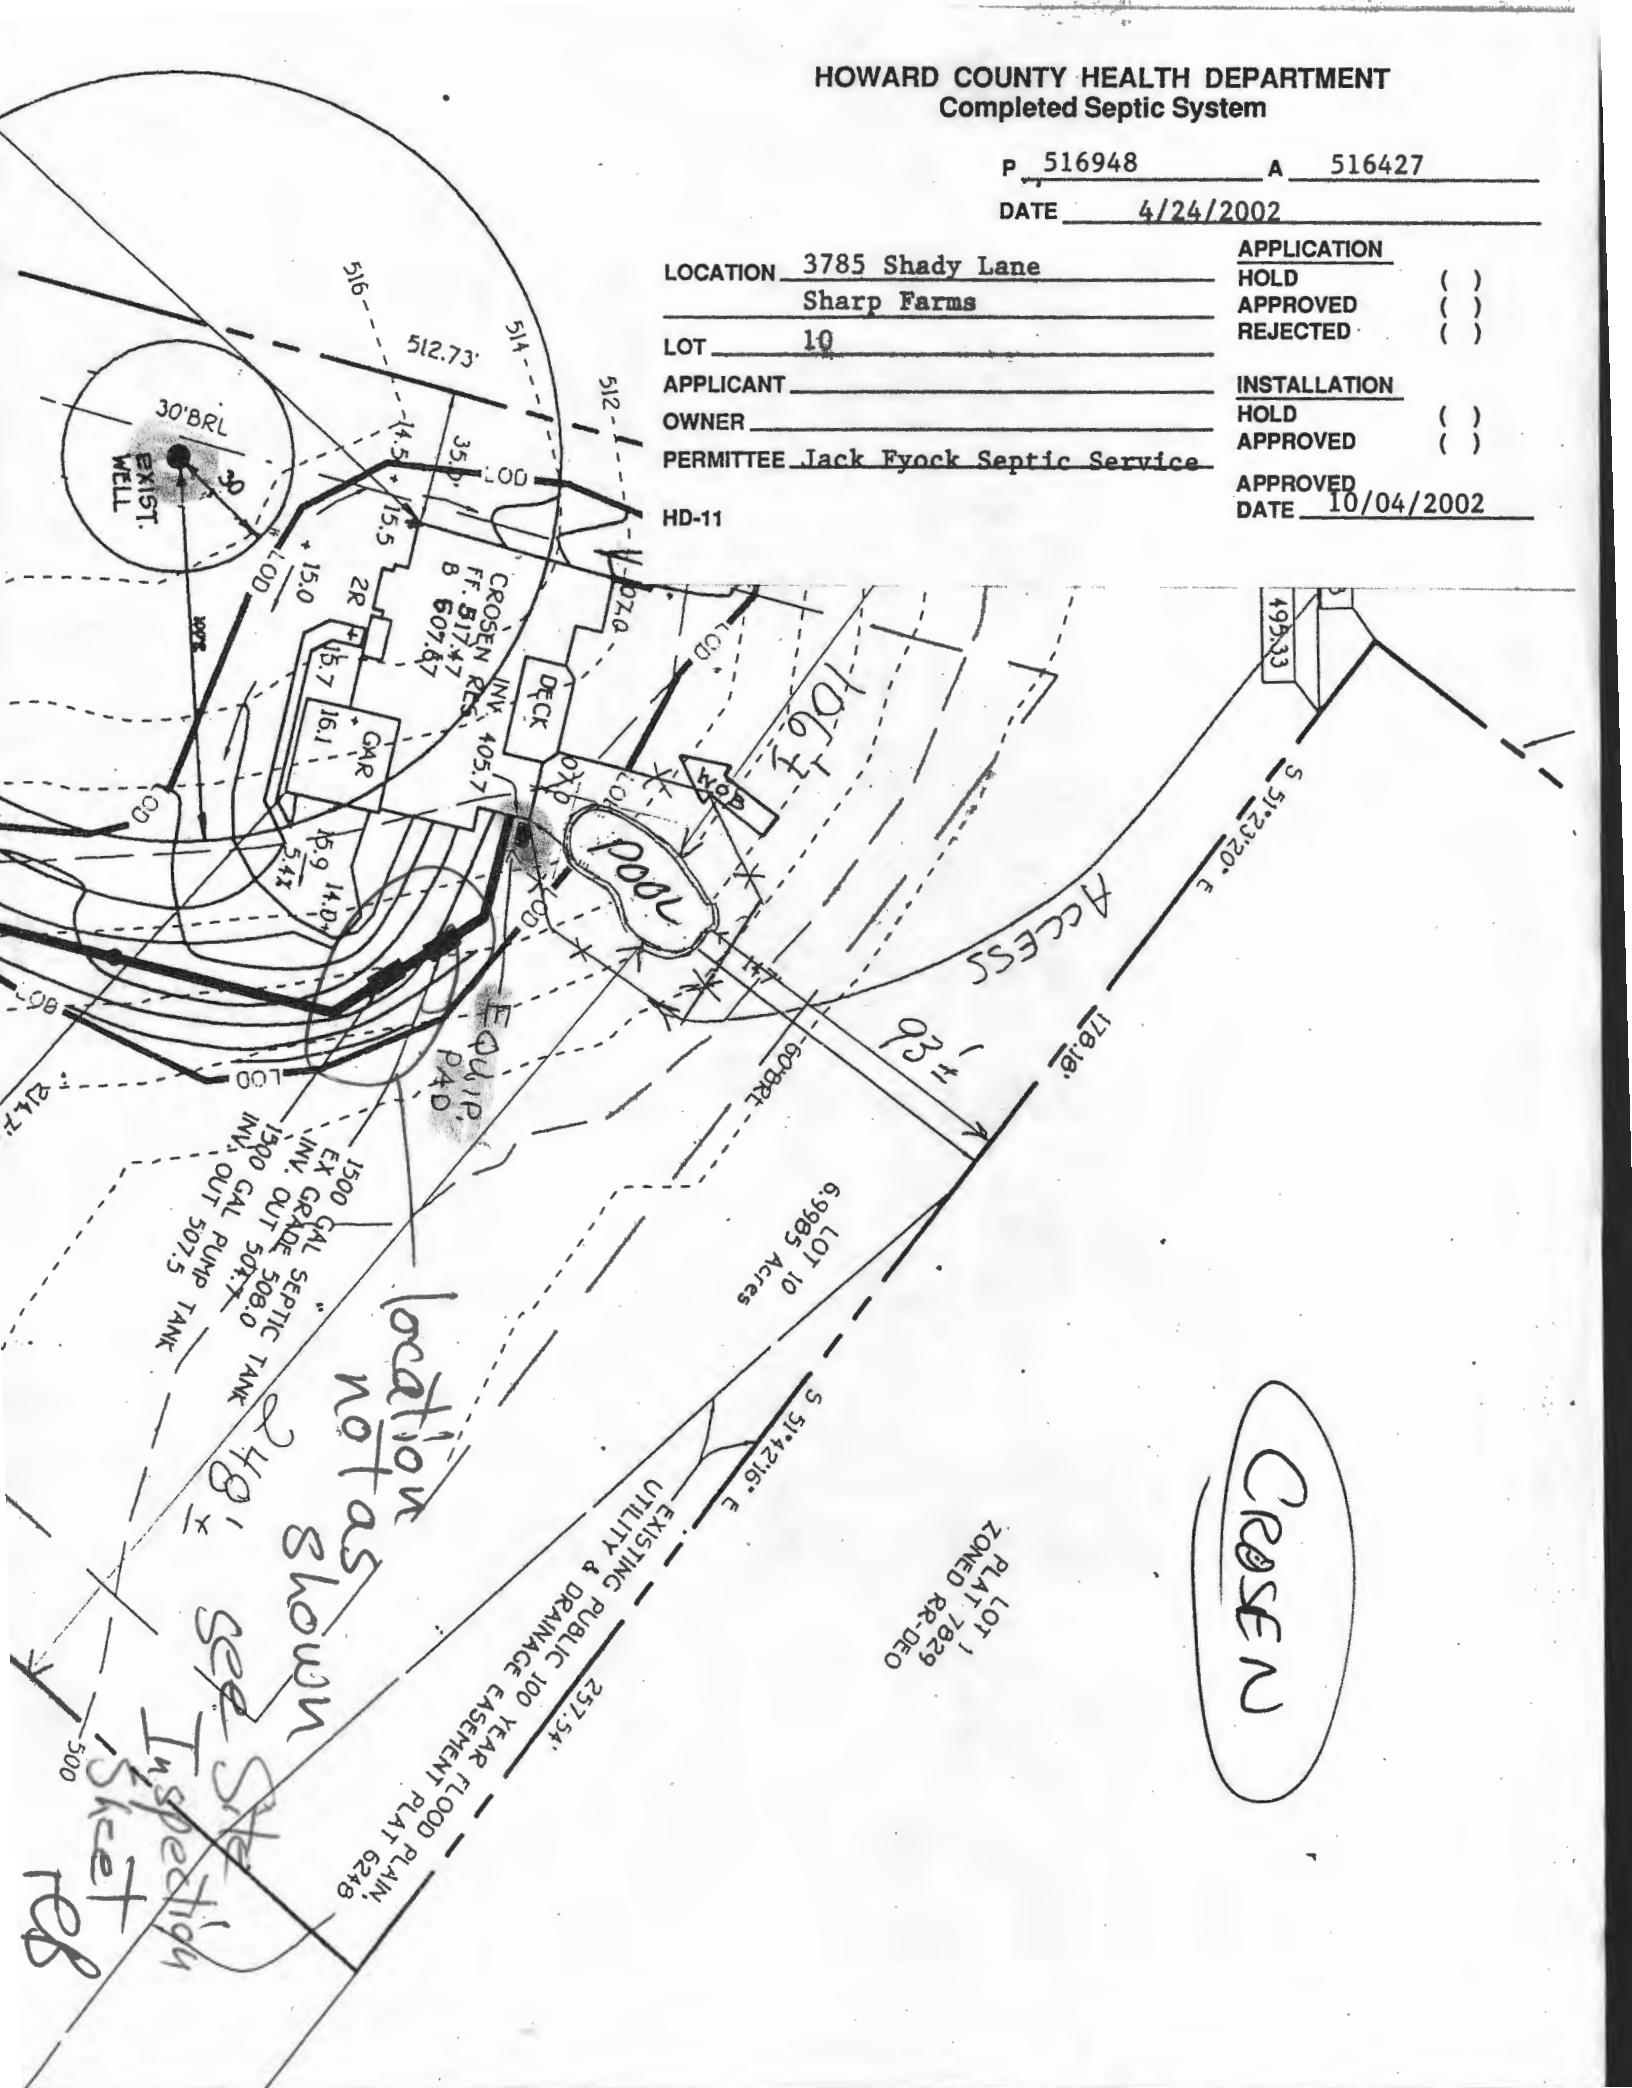[illegible][illegible][illegible]

CROSEN

