

APPLICATION

HOWARD COUNTY

PERMIT APPLICATION

DEPARTMENT OF INSPECTIONS, LICENSES & PERMIT
3430 COURT HOUSE DRIVE, ELLICOTT CITY, MARYLAND 21043

SERIAL NUMBER

47350

BUILDING ADDRESS (HOUSE NO., STREET, TOWN OR AREA)

1817 Quarter Horse Rd.

in Monroeville, MD 21104

LOT NO.	PARCEL NO.	SEC.	AREA	BLOCK NO.	LIBER	FOLIO
1	36	NA	NA	23		
SUB DIVISION		ZONE	ZONE MAP	ELEC. DIST.	CENSUS TR.	
Parkside		PC	10	3	6030	

OWNER NAME AND ADDRESS

PHONE NO.

George W. McGeehey Jr.
422 W. Maple Rd.
Lathicum, MD 21090

OCCUPANT'S NAME AND ADDRESS

PHONE NO.

George W. McGeehey Jr.
422 W. Maple Rd.
Lathicum, MD 21090

ARCHITECT OR ENGINEER'S NAME AND ADDRESS

PHONE NO.

NONE

CONTRACTOR'S NAME AND ADDRESS

PHONE NO.

JGM Construction, Inc.
422 W. Maple Rd.
Lathicum, MD 21090

EXISTING USE

PROPOSED USE

UNCAUT LOT

Single family
Home

EST. CONSTRUCTION COST

LICENSE NUMBER

PERMIT FEE

150,000

32328141

W/S CODE

FOR OFFICE USE ONLY

DISTRICT IN FEET FROM R/W LINE TO FRONT BUILDING LINE

SIDE YARD

(DISTANCE IN FEET FROM SIDE BLDG. LINE TO SIDE PROPERTY LINE)

TO SIDE BUILDING LINE

DISTANCE IN FEET, REAR YD. REQUIRING SET

BACK (CORNER LOT ONLY)

SDP #

Check payable to: DIRECTOR OF FINANCE OF HOWARD COUNTY

CAUTION

To begin construction before a permit placard has been issued and displayed on the job is a violation of the law.

Use and occupancy permit must be applied for two weeks before it will be issued.

IMPORTANT: PLEASE SHOW ZIP CODES AND AREA CODES WHEREVER REQUIRED.

P-69-591

GRADING/SEDIMENT CONTROL ☐ YES ☐ NO

SDP #

DESCRIPTION OF WORK AUTHORIZED

Single family home
with new attached
3-car garage
4 bedrooms

SIZE OF BLDG.	FRONT	DEPTH	HEIGHT
TYPE OF BLDG.	AREA	VOLUME	ROOF
B. ROOMS			
ROOMS			
BATHS			
FIREPLACES			

FOOTINGS	FOUNDATION	S. WALLS

UTILITIES				
WATER/WELL	SEWER/SEPTIC	GAS	ELECTRICITY	TYPE OF HEAT
				AC
				H.P.

I have carefully examined and read this application and know the same is true and correct, and that in doing this work, all provisions of Howard County Ordinances and the State Laws of Maryland will be complied with, whether specified or not; and I will notify the Department of Inspections, and Permits twenty-four hours in advance when I am ready for the inspections called for elsewhere in the application; and that no work will be covered up until such inspections have been completed with.


Signature: President / Contr.
Title: DATE: 2/17/93

FUNCTION	DATE	SIGNATURE APPROVAL
ZONING/PLANNING		
SHA		
SEDIMENT/GRADING		
BUILDING OFFICIAL		
WATER & SEWER		
HEALTH DEPT.	4-8-93	F. Trimmer
FIRE PROTECTION		
STORM WATER MGM.		

APPROVED

DATE

Distribution of Copies:
White - Building Official
Green - Planning & ZoningYellow - Engineering
Pink - Health Dept.
Gold - S.H.A.

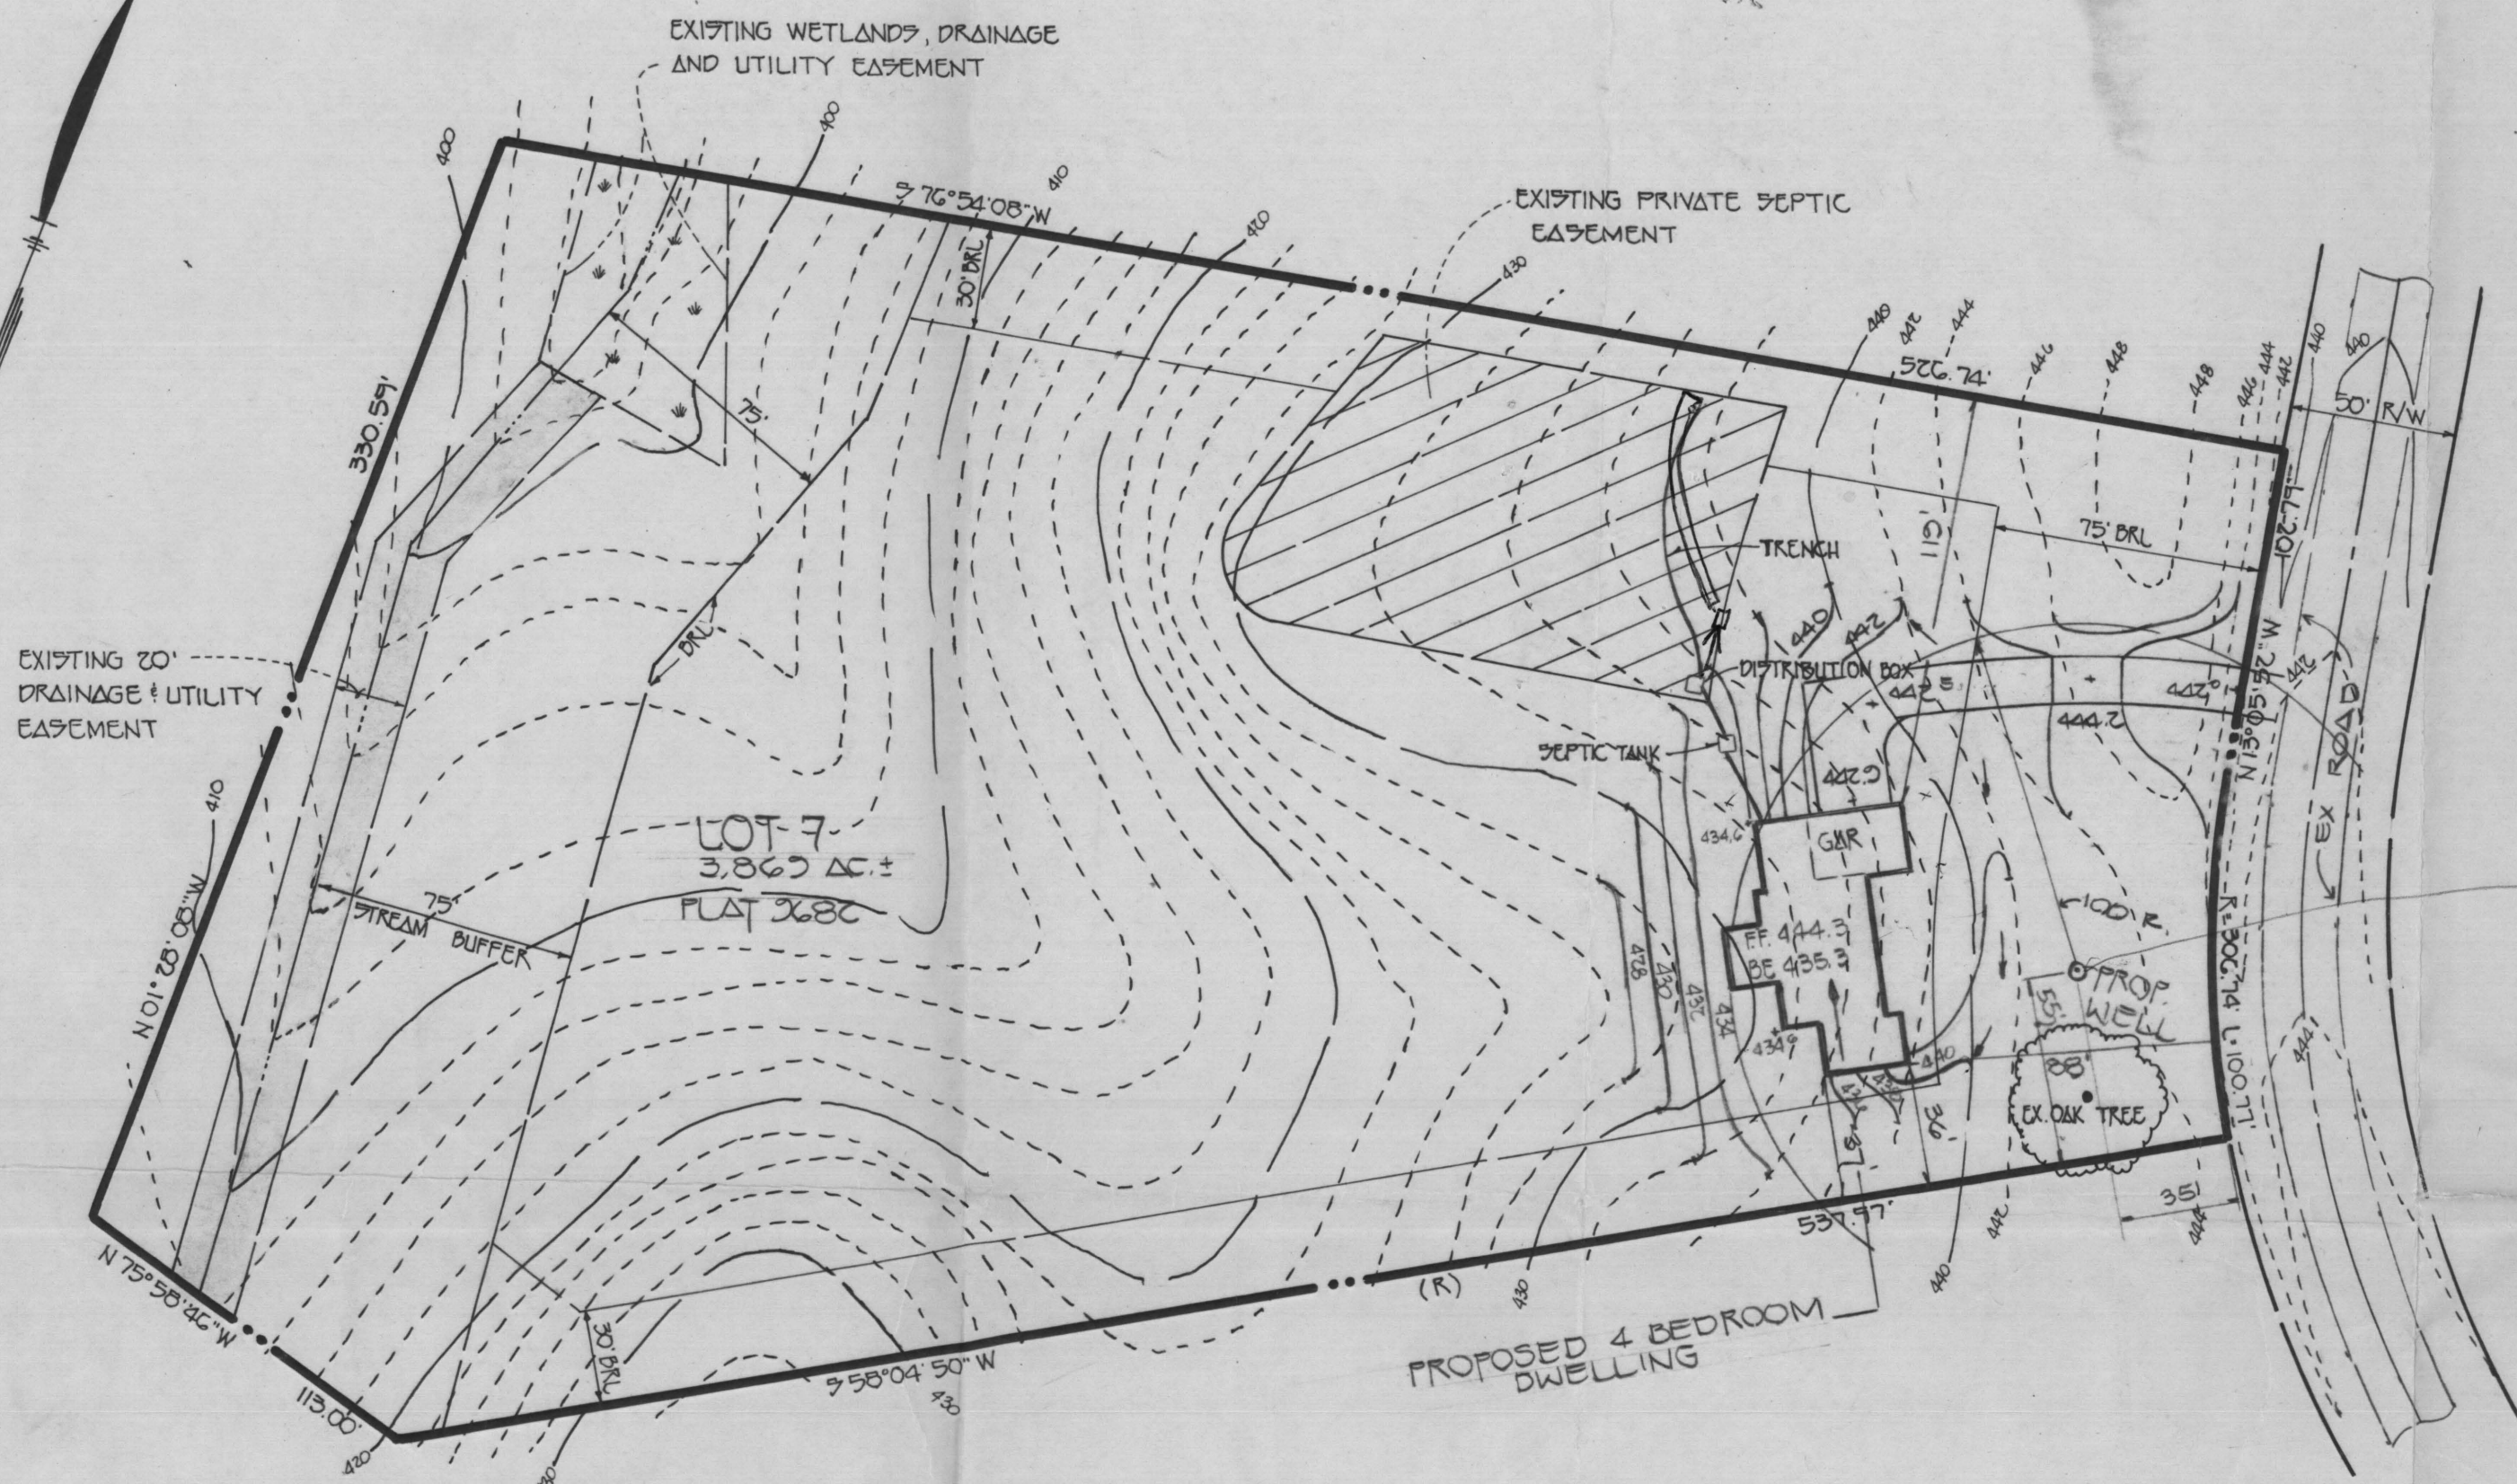

GENERAL NOTES

1. SEPTIC EASEMENT SUBJECT TO HOWARD COUNTY HEALTH DEPT. NO. A44272
2. PROPOSED 1500 GALLON SEPTIC TANK.
3.
 - A. FIRST FLOOR ELEVATION: 444.3
 - B. BASEMENT ELEVATION: 435.3
 - C. INVERT OF SEPTIC SYSTEM AT HOUSE: 432.5
 - D. INVERT IN AT SEPTIC TANK: 432.5
 - E. INVERT OUT AT SEPTIC TANK: 432.2
 - F. PROPOSED GRADE OVER SEPTIC TANK: 435.5
 - G. INVERT AT DISTRIBUTION BOX: 432.0
 - H. EXISTING GROUND OVER DISTRIBUTION BOX: 435.0
4. LENGTH OF TRENCH TO BE DETERMINED AT TIME OF SEPTIC PERMIT ISSUANCE.
5. CONTRACTOR/BUILDER TO VERIFY ELEVATIONS IN FIELD BEFORE BEGINNING ANY CONSTRUCTION.

FISHER, COLLINS & CARTER, INC.

CIVIL ENGINEERING CONSULTANTS & LAND SURVEYORS

7171 BALTIMORE NATIONAL PIKE, SUITE 100

ELLICOTT CITY, MARYLAND 21042

TELEPHONE: (410) 461-2355

FAX: (410) 750-3784



PLOT PLAN
TO ACCOMPANY APPLICATION FOR
BUILDING PERMIT
LOT 7

PARKSIDE

TAX MAP 10 ZONING R PARCEL 36
THIRD ELECTION DISTRICT HOWARD COUNTY, MARYLAND
SCALE: 1" = 50' DATE: FEBRUARY 10, 1993

02388141

Parkside Lot 7