

PRELIMINARY

APPLICATION

A 21234

P _____

SEWAGE DISPOSAL TESTING

STATE OF MARYLAND - DEPARTMENT OF HEALTH AND MENTAL HYGIENE

HOWARD COUNTY HEALTH DEPARTMENT
ENVIRONMENTAL HEALTH SERVICES

P. O. BOX 470, ELLICOTT CITY, MARYLAND 21043
TELEPHONE 465-5000, EXT. 356

DISTRICT 5th

DATE 3/13/75

TO: THE COUNTY HEALTH OFFICER
ELLICOTT CITY, MARYLAND

I, HEREBY, APPLY FOR THE NECESSARY TEST IN ORDER TO CONSTRUCT (OR RECONSTRUCT) A SEWAGE DISPOSAL SYSTEM

PROPERTY OWNER Walgrow Joint Venture Company

Any questions call John Schneider:
465-7777

ADDRESS _____ PHONE _____

PROPERTY LOCATION _____

SUBDIVISION Walgrow Estates LOT NO. 12
58

ROAD AND DESCRIPTION Chalice Court

SIZE OF LOT approx. 1 acre TYPE BLDG. 3 or 4 bedrooms
NUMBER OF BEDROOMS _____

IF NOT SINGLE RESIDENCE DESCRIBE _____

THE SYSTEM INSTALLED UNDER THIS APPLICATION IS ACCEPTABLE ONLY UNTIL PUBLIC FACILITIES BECOME AVAILABLE

SIGNATURE OF APPLICANT /s/ John Schneider


APPROVED BY _____ FOR _____ DATE _____
(KIND OF SYSTEM)

REJECTED BY _____ FOR _____ DATE _____
(KIND OF SYSTEM)

HOLD PENDING FURTHER TESTS _____ DATE _____

REASONS FOR REJECTION OR HOLDING _____

THIS IS NOT A PERMIT

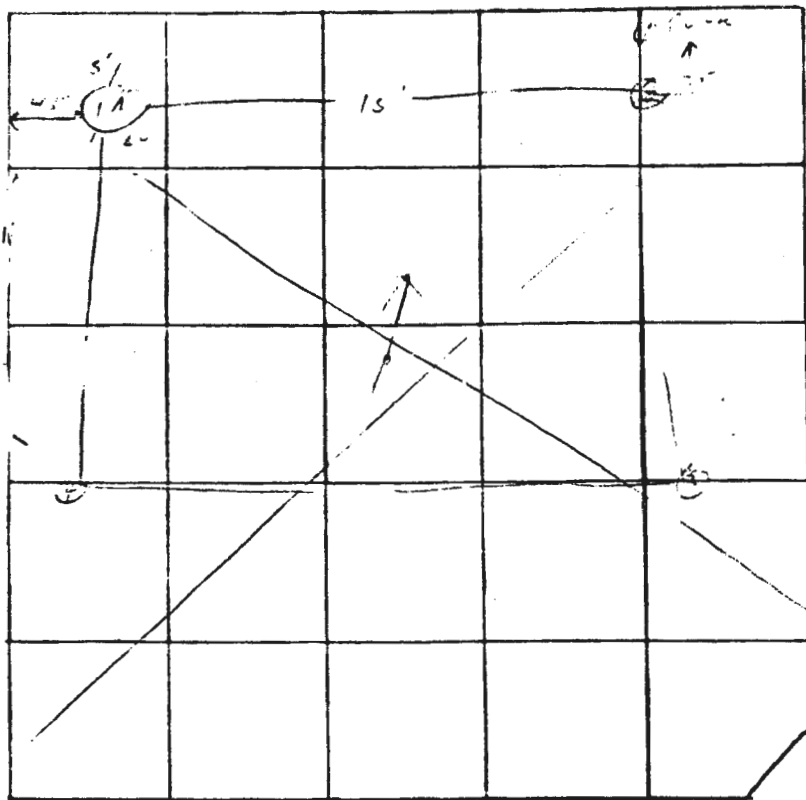

Charlie C.

* B.P.
33824

57
12

INDICATE NORTH - NAME ADJOINING ROADWAY AS BASE LINE

54-0 R.L.

DATE	TEST NO	DEPTH	PRE WET		TEST - DROP		TIME
			START	STOP	START	STOP	
4-11-55	1	10"	1200				
	45	4"	1235	1250	1230	1245	6
	40	12"	35	1250	1230	1245	7
	3	2"	1200	1205	SAME	1205	4
	20	6"	1201	1210	1200	1225	15
	20	12"	1201	1205	1200	207	4
	16 S		1210	1212	1212	1216	4
4-11-55	10 D	2"	1210	1214	1212	1218	6

REMARKS _____


TYPE OF SOIL _____

TESTED BY HZ, RM ALSO PRESENT: _____

A 21234

use for

55.77

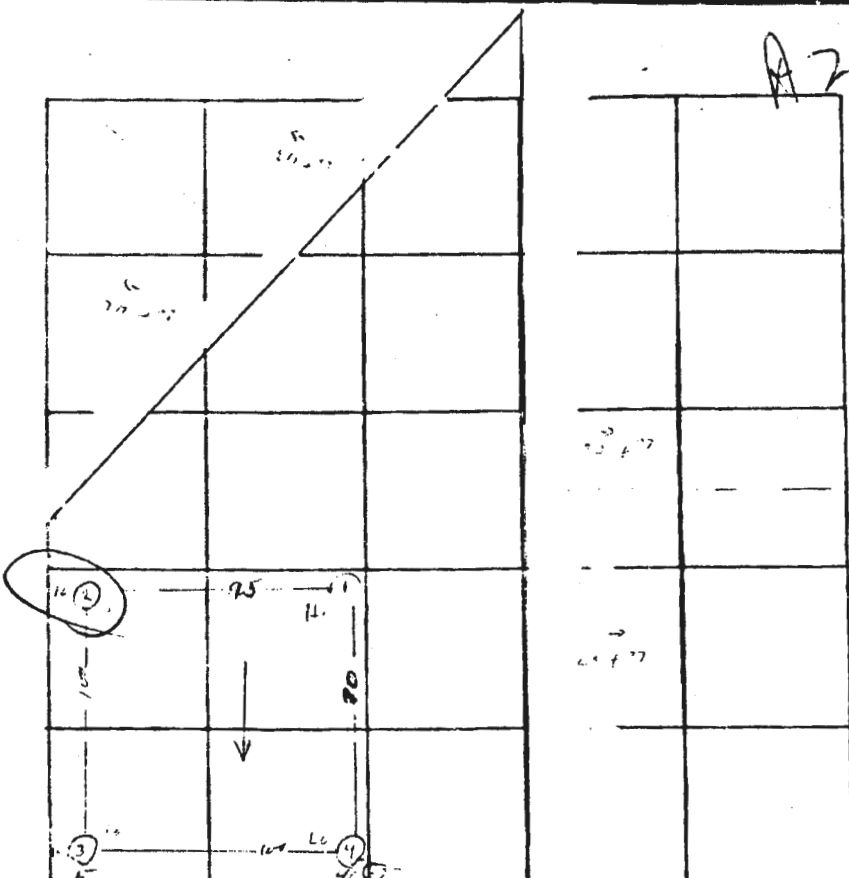

INDICATE NORTH - NAME ADJOINING RC

BASE LINE

~~27~~
#13
The Heritage
BP
#32573


DATE	TEST NO	DEPTH	PRE WET		TEST - 1" DROP		TIME
			START	STOP	START	STOP	
4.11.75	15 HIGH	4'	1020	1023	1023	1027	4
	1	12'	1023	1023	1023	1040	7
	2	12'	SAME	1046			
	3	4'	1020	1023	1023	1031	7
	3	12'	1020	1025	1025	1031	6
	4 LOWEST	4	1017	1025	1025	1029	4
4.12.75	10	12	117	1020	1020	1025	5
	5	6	1026				

area - plot to be shown as 100' x 100' for 10,000^{sq} ft
REMARKS reserve

TYPE OF SOIL _____

TESTED BY 112 R M ALSO PRESENT: _____

RE BALTIMORE 108188 REAMER 11-7-1985

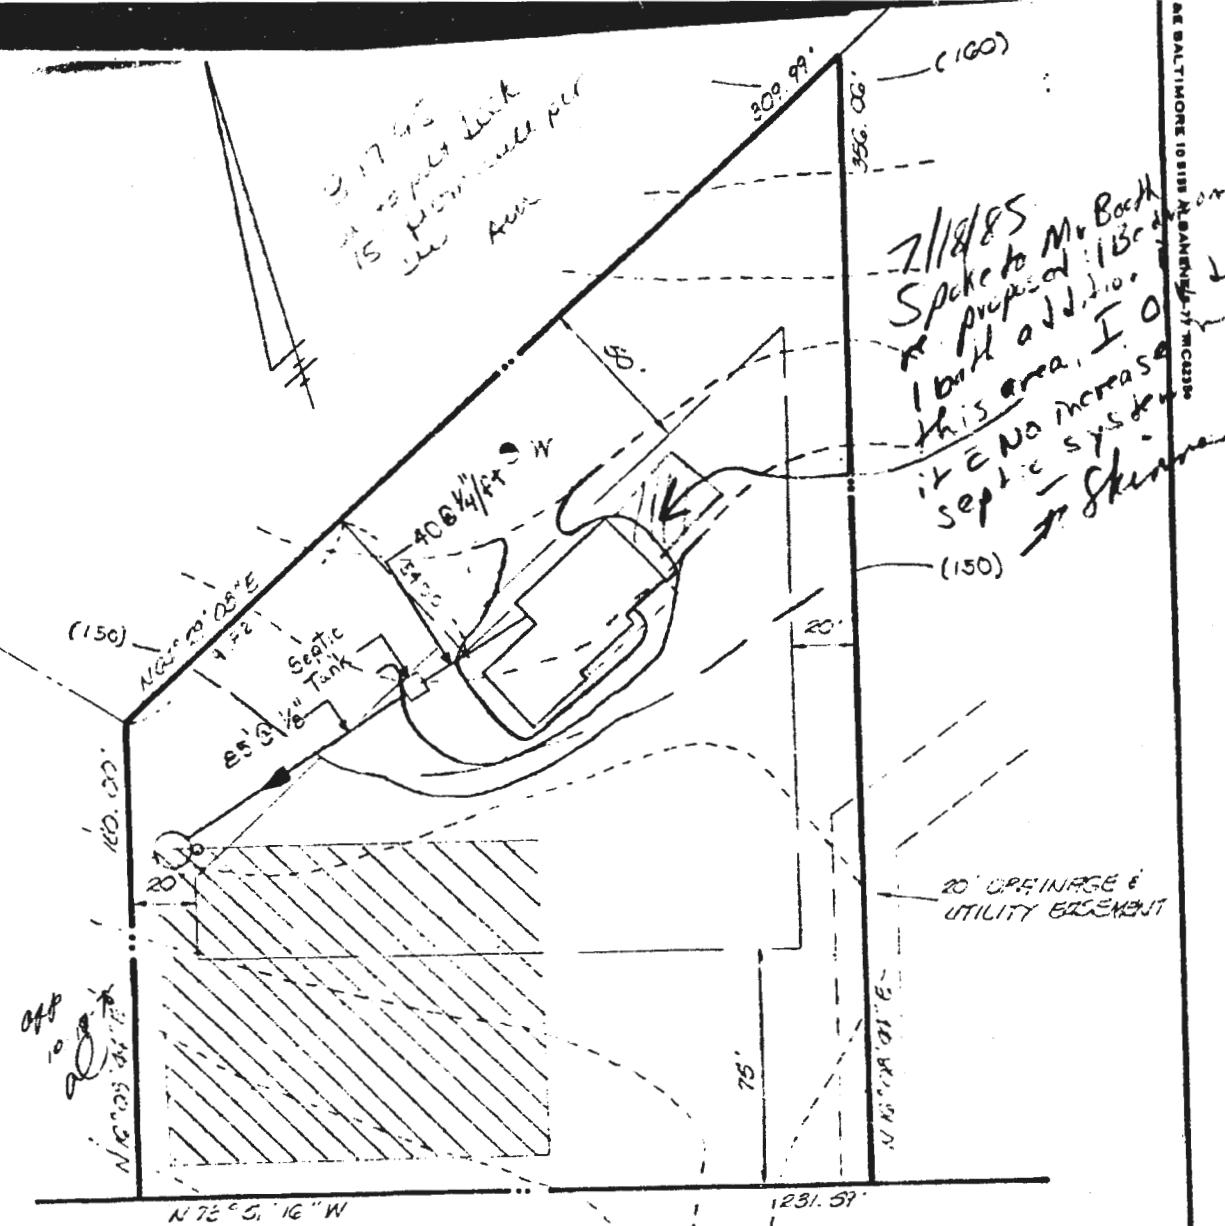

HOUSE:	SHARP	PGAC
	(60' P/W)	
FIRST FLOOR ELEVATION	158.0	INV. OUT OF TANK 144.0
BASEMENT ELEVATION	149.0	DRY WELL
INVERT OUT OF HOUSE	146.0	EXIST. GRADE 148.0
SEPTIC TANK		PROPOSED GRADE 148.0
EXIST. GRADE	152.0	INV. INTO DRYWELL 144.0
PROPOSED GRADE	152.0	WATERWELL
INV. INTO TANK	145.2	EXIST. GRADE 153.0
		PROPOSED GRADE 153.0

4073 Sharp Rd Lot 70 1.60