

HOWARD COUNTY
PERMIT APPLICATION

PERMIT NUMBER

B07003833

Building Address 4073 Sharp Rd
Glencol, MD 21737

Suite/Apt. #: _____ SDP/WP/Petition #: _____

Census Tract _____ Subdivision _____

Section _____ Area _____ Lot _____

Tax Map _____ Parcel _____ Grid _____

Zoning _____ Map Coordinates _____ Lot size _____

Existing Use SF Dwelling

Proposed Use Same

Estimated Construction Cost \$ 6500.00

Description of Work Buying a propane

tank and gas lines

Occupant or Tenant John Szekmeister

Contact Name _____

Address 4073 Sharp Rd

City Glencol State MD Zip Code 21737

Phone 410-540-9733 Fax _____

Property Owner's Name John Szekmeister

Address 4073 Sharp Rd.

City Glencol State MD Zip Code 21737

Home Phone 410-540-9733 Work Phone _____

Applicant's Name & Mailing Address, (if other than stated hereon):

Phone _____ Fax _____

Contractor Company Suburban Propane

Contact Person James McKenney

Address 31 Dornwood Cr.

City Rockville State MD Zip Code _____

License No. 78260

Phone 301-251-0006 Fax 301-251-0006

Engineer or Architect Company _____

Contact Person _____

Address _____

City _____ State _____ Zip Code _____

Phone _____ Fax _____

BUILDING DESCRIPTION - COMMERCIAL

Building Characteristics

Height: _____

No. of stories: _____

Gross area, sq. ft. per floor: _____

Use group: _____

Construction type:

_____ Reinforced Concrete

_____ Structural Steel

_____ Masonry

_____ Wood Frame

_____ State Certified Modular

Utilities

Water Supply:

_____ Public

_____ Private

Sewage Disposal:

_____ Public

_____ Private

Electric Yes ☐ No ☐

Gas Yes ☐ No ☐

Heating System:

Electric ☐ Oil ☐

Natural Gas ☐

Propane Gas ☐

Sprinkler system: N/A ☐

_____ Full

_____ Partial

_____ Other Suppression

_____ # of Heads

BUILDING DESCRIPTION - RESIDENTIAL

Building Characteristics

SF Dwelling ☐ SF Townhouse ☐

Depth Width

1st floor: _____

2nd floor: _____

Basement: _____

Finished Basement ☐ Unfinished Basement ☐

Crawl space ☐ Slab on Grade ☐

No. of Bedrooms _____

Height: _____

Multi-family dwellings:

No. of efficiency units: _____

No. of 1 BR units: _____

No. of 2 BR units: _____

No. of 3 BR units: _____

Other Structure: _____

Dimensions: _____

Footings: _____

Roof Height: _____

_____ State Certified Modular

_____ Manufactured Home

Utilities

Water Supply:

_____ Public

☒ Private

Sewage Disposal:

_____ Public

☒ Private

Electric Yes ☐ No ☐

Gas Yes ☒ No ☐

Heating System:

Electric ☐ Oil ☐

Natural Gas ☐

Propane Gas ☒

Sprinkler system: N/A ☐

_____ NFPA #13D

_____ NFPA #13R

_____ Other:

THE UNDERSIGNED HEREBY CERTIFIES AND AGREES AS FOLLOWS: (1) THAT HE/SHE IS AUTHORIZED TO MAKE THIS APPLICATION; (2) THAT THE INFORMATION IS CORRECT; (3) THAT HE/SHE WILL COMPLY WITH ALL REGULATIONS OF HOWARD COUNTY WHICH ARE APPLICABLE THERETO; (4) THAT HE/SHE WILL PERFORM NO WORK ON THE ABOVE REFERENCED PROPERTY NOT SPECIFICALLY DESCRIBED IN THIS APPLICATION; (5) THAT HE/SHE GRANTS COUNTY OFFICIALS THE RIGHT TO ENTER ONTO THIS PROPERTY FOR THE PURPOSE OF INSPECTING THE WORK PERMITTED AND POSTING NOTICES.

Applicant's Signature James McKenney

Title/Company Suburban Propane

Print Name James McKenney

Date 9-8-07

Checks payable to: **DIRECTOR OF FINANCE OF HOWARD COUNTY**


** PLEASE WRITE NEATLY AND LEGIBLY. **

- FOR OFFICE USE ONLY -

AGENCY	DATE	SIGNATURE APPROVAL
Land Development, DPZ		
State Highways		
Building Official		
Dev. Engineering, DPZ		
Health	9/25/2007	J. A. G.
Fire Protection		
Is Sediment Control approval required prior to issuance?		
YES ☐ NO ☐		

OPZ SETBACK INFORMATION	PROPERTY ID#
Front: _____	Filing fee \$ _____
Rear: _____	Permit fee \$ <u>100.00</u>
Side: _____	Excise tax \$ _____
Side St.: _____	Add'l per. fee \$ _____
All minimum setbacks met?	TOTAL FEES \$ <u>100.00</u>
YES ☐ NO ☐	Sub-total paid \$ _____
Is Entrance Permit required?	Balance due \$ _____
YES ☐ NO ☐	Check # <u>4272-95</u>
Historic District?	Validation # _____
YES ☐ NO ☐	
Lot Coverage for New/Town Zone _____	
SDP/Red-line approval date _____	Accepted by <u>J</u>

CONTINGENCY CONSTRUCTION START: ☐
ONE STOP SHOP: ☐
Distribution of Copies: White: Building Official Green: LDD, DPZ Yellow: DED, DPZ Pink: Health Gold: SHA
T:\norma\PERMIT.FRM

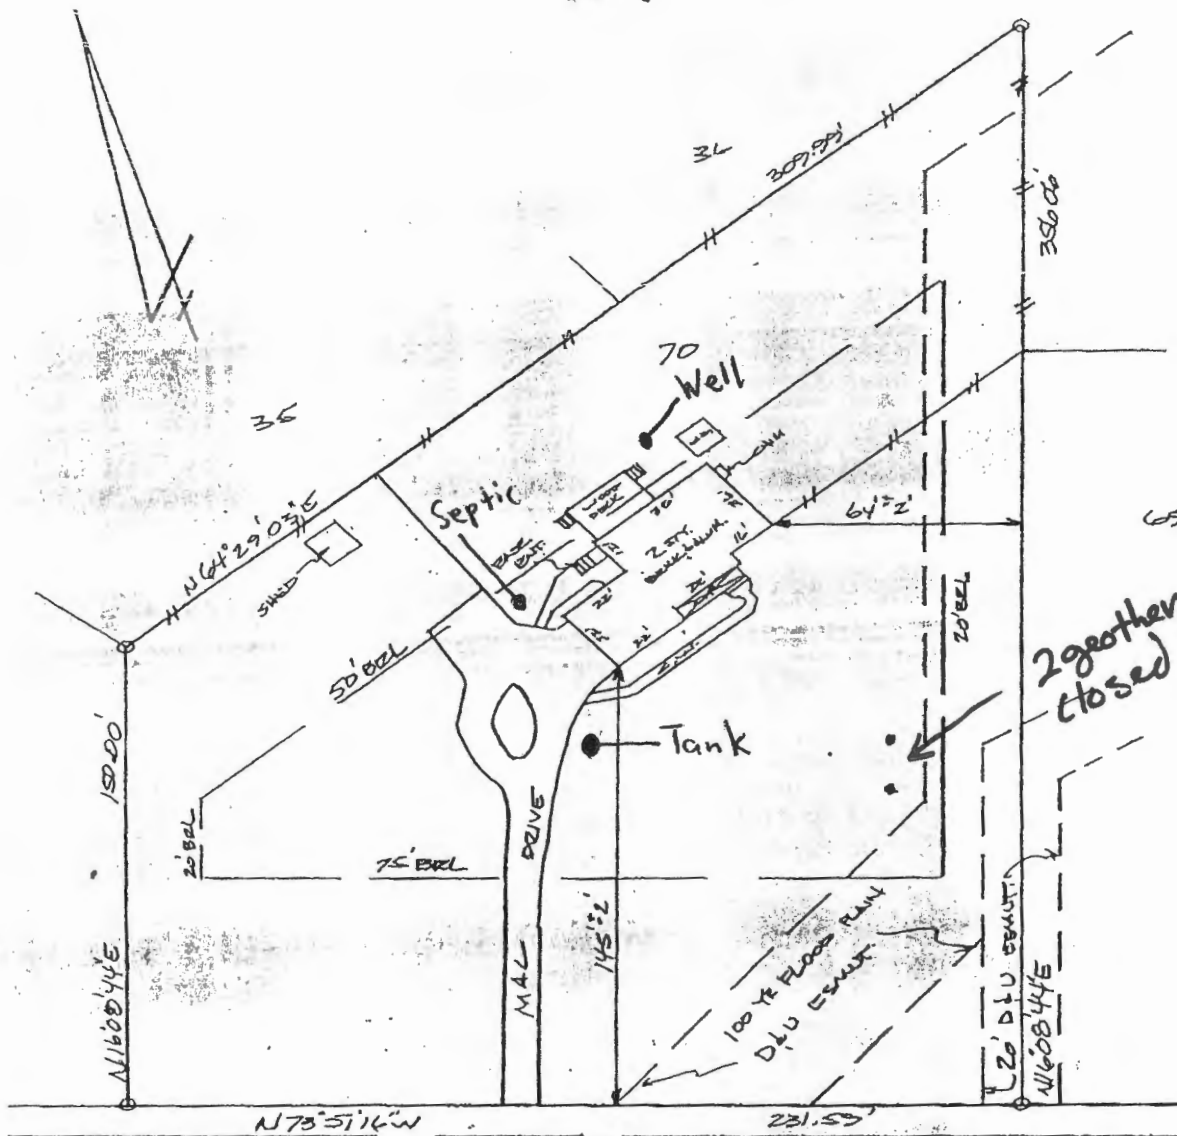


- 112'-Back Property Line SHARP ROAD
- 113'-To RT Property Line
- 124'-To Rd.
- 137'-To Left Property
- 57'-To Septic
- 105'-To Well

9/25/2007
 Plan not to scale.
 used provided measurements
 to check location on
 scaled plan in file.
 location ok as proposed.
 B07003833 OK for LP propane
 4073 SHARP ROAD LOT 70
 "THE HERITAGE" FLAT 3779
 HOWARD COUNTY MARYLAND
 tank at proposed location.

The plat is of benefit to a consumer only insofar as it is required by a lender or a title insurance company or its agent in connection with contemplated transfer, financing or refinancing. The plat is not to be relied upon for the establishment or location of fences, garages, buildings, or other existing or future improvements. The plat does not provide for the accurate identification of property boundary lines, but such identification may not be required for the transfer of title or securing financing or refinancing.

THE LOT SHOWN HEREON IS IN FLOOD ZONE C PER F.E.M.A.
 FLOOD INSURANCE RATE MAP PANEL # 2400470000B

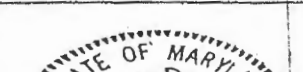SCALE 1"=50'	LOCATION CERTIFICATION		
DATE 2-20-03	WITZ & ASSOCIATES GENERAL SURVEYING CO.		
JOB No.	1009 Frederick Road Baltimore, MD 21228 Phone 410-869-3536 Fax 410-869-3538		
03-192			