

APPLICATION

PERCOLATION TESTING

44279
A ~~42755~~

HOWARD COUNTY HEALTH DEPARTMENT
BUREAU OF ENVIRONMENTAL HEALTH
P.O. BOX 476 ELLICOTT CITY, MARYLAND 21043
TELEPHONE: 461-9933

DISTRICT 3

DATE 8-25-85

TO: THE COUNTY HEALTH OFFICER
ELLICOTT CITY, MARYLAND

I, HEREBY, APPLY FOR THE NECESSARY TEST IN ORDER TO CONSTRUCT (OR RECONSTRUCT) A SEWAGE DISPOSAL SYSTEM.

PROPERTY OWNER Vincent Bracciale McGEENEY, Jr.

ADDRESS 1830 Woodstock Rd PHONE 859-1853
~~461-9933~~

PROSPECTIVE BUYER N/A

ADDRESS _____ PHONE _____

PROPERTY LOCATION:

SUBDIVISION Bracciale Property LOT NO. 18 LOT 7 Prelim

ROAD AND DESCRIPTION Woodstock Rd north of Mt St 99

TAX MAP 10 PARCEL # 36

SIZE OF LOT 3.31 ± acres TYPE BLDG SFD
(SINGLE FAMILY DWELLING OR COMMERCIAL)

THE SYSTEM INSTALLED UNDER THIS APPLICATION IS ACCEPTABLE ONLY UNTIL PUBLIC FACILITIES BECOME AVAILABLE. I FULLY UNDERSTAND THE FEE CONNECTED WITH THE FILING OF THIS PERC TEST APPLICATION IS NON-REFUNDABLE UNDER ANY CIRCUMSTANCES. I ALSO AGREE TO COMPLY WITH ALL M.O.S.H.A. REQUIREMENTS IN TESTING THIS LOT.

M. J. Davis
(SIGNATURE OF APPLICANT)

APPROVED BY _____ FOR _____ DATE _____

REJECTED BY _____ FOR _____ DATE _____

HOLD PENDING FURTHER TESTS _____ DATE _____

REASONS FOR REJECTION OR HOLDING 5-22-89 Per Satisfactory - Hold for Plat. Subl

BLDG. PERMIT SIGNED

AND RETURNED 4/8/93

Serial # 47350

SFD - 4 Bldgs


THIS IS NOT A PERMIT

A-44279
A-42455
Lot 157

SOIL PROFILE

0'
4"
4"
12.5'

AP 14X
Yellow Br.
Silty clay
loam
<10% frag
Small amt
Quartzite
Yellow Br.
to light
Br.
Silty sand
loam
10-20%
Frag

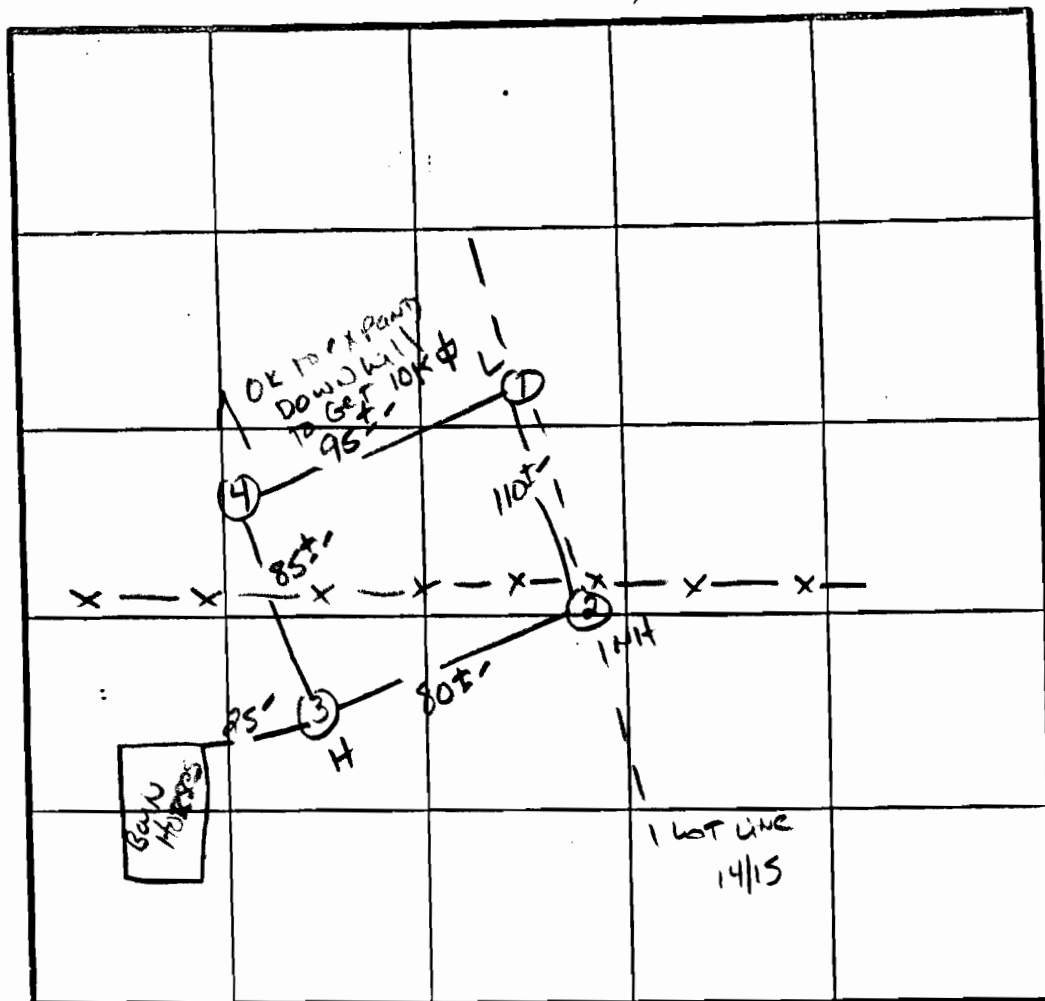

X Perc, 8 min
210 ft/hr
Twist 4'
Bottom 8'

INDICATE NORTH - NAME ADJOINING ROADWAY AS BASE LINE.


DATE	TEST NO.	DEPTH	PRE-WET		TEST - 1" DROP		TIME
			START	STOP	START	STOP	
5/27/87	1 S	4.0'	11:40	11:44	11:44	11:59	15 MIN
	1 V	12.0'	Similar	to profile			
	2 S	4.0	11:52	11:59	11:59	12:11	2 MIN
	2 M	7.5	11:52	11:53	11:53	11:56	3 MIN
	2 V	12.0	Similar	to profile			
	3 V	12.0'	Same	As Profile			
	4 S	4'	11:44	11:45	11:45	11:47	2 MIN
	4 V	12.5'	As Profile				

REMARKS Holes APPROX TO PLAT & AS STAKED

TYPE OF SOIL Brandywine

TESTED BY S. Abel

ALSO PRESENT OKOT
Zolt, John P.

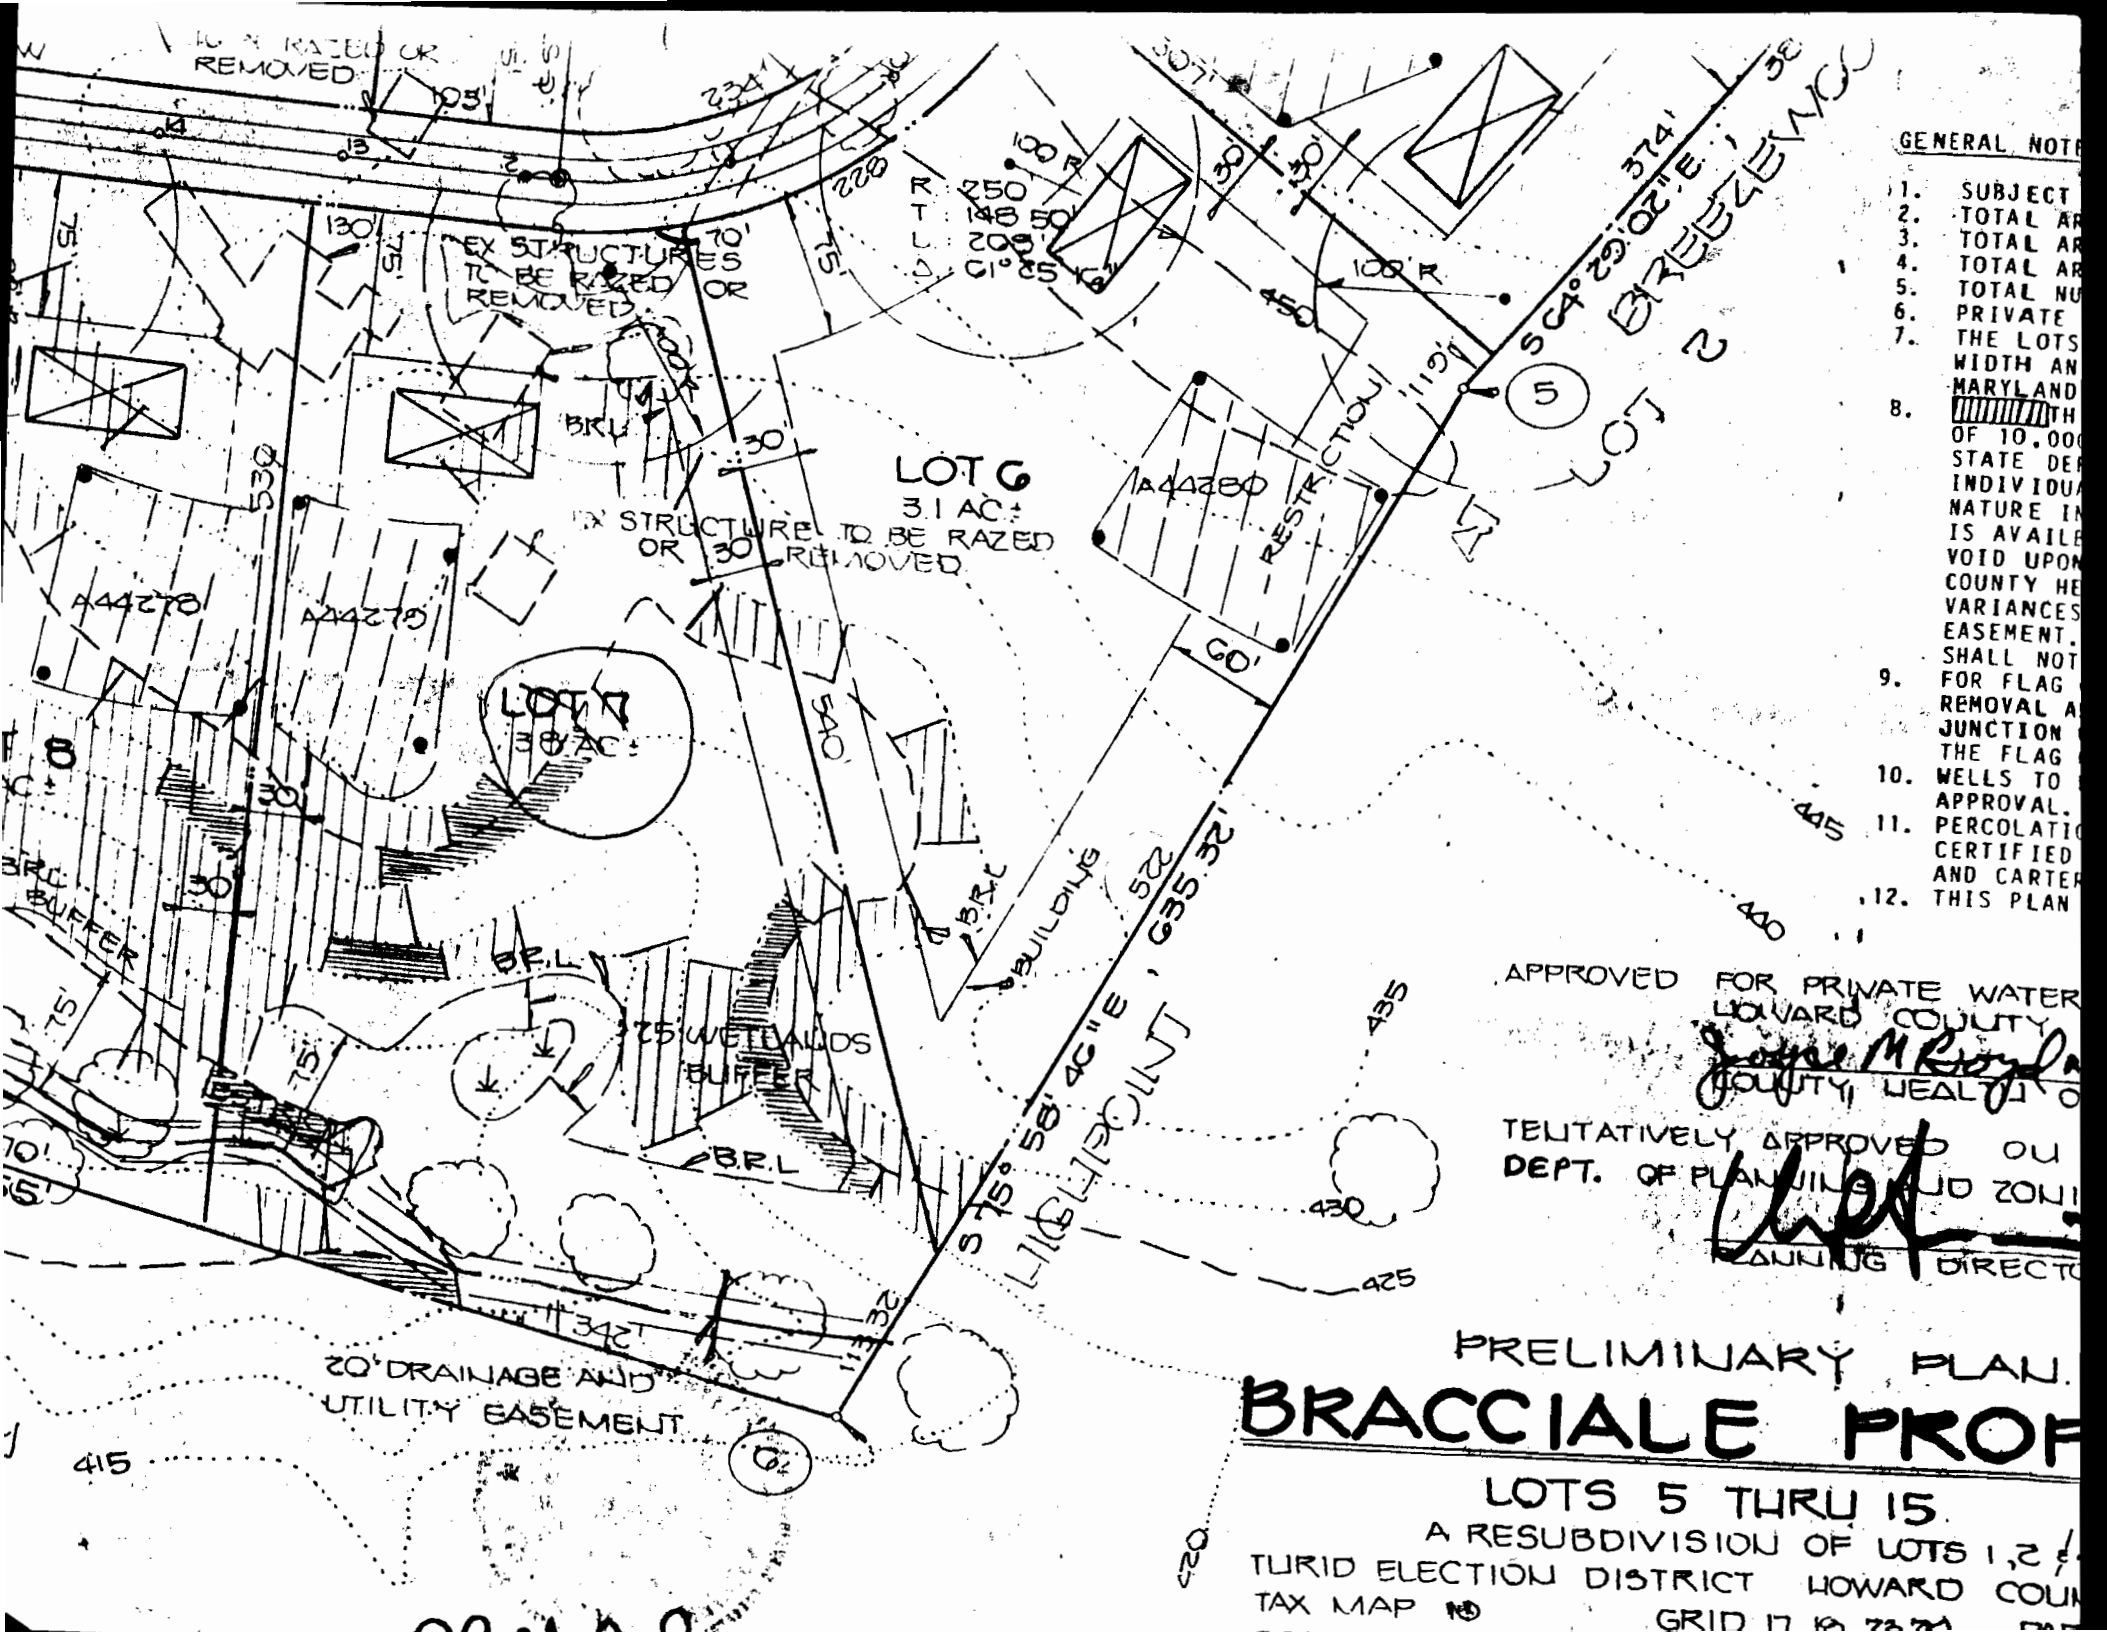

GENERAL NOTE

1. SUBJECT
2. TOTAL AREA
3. TOTAL AREA
4. TOTAL AREA
5. TOTAL NUMBER
6. PRIVATE
7. THE LOTS
8. WIDTH AND
9. MARYLAND
10. WITH
11. OF 10,000
12. STATE DEPT
13. INDIVIDUAL
14. NATURE IN
15. IS AVAILABLE
16. VOID UPON
17. COUNTY HE
18. VARIANCES
19. EASEMENT.
20. SHALL NOT
21. FOR FLAG
22. REMOVAL A
23. JUNCTION
24. THE FLAG
25. WELLS TO
26. APPROVAL.
27. PERCOLATION
28. CERTIFIED
29. AND CARTER
30. THIS PLAN