

4-12' tested  
on 10,000 ft.  
*Preliminary*

# APPLICATION

A 22384

SEWAGE DISPOSAL TESTING

P \_\_\_\_\_

STATE OF MARYLAND - DEPARTMENT OF HEALTH AND MENTAL HYGIENE

HOWARD COUNTY HEALTH DEPARTMENT  
ENVIRONMENTAL HEALTH SERVICES  
P. O. BOX 476, ELLICOTT CITY, MARYLAND 21043  
TELEPHONE: 465-3000, EXT. 356

DISTRICT 5

DATE 10/24/75

TO: THE COUNTY HEALTH OFFICER  
ELLICOTT CITY, MARYLAND

I, HEREBY, APPLY FOR THE NECESSARY TEST IN ORDER TO CONSTRUCT (OR RECONSTRUCT) A SEWAGE DISPOSAL SYSTEM.

PROPERTY OWNER Michael R. Matejovich  
Walden East Estates Co.

ADDRESS 4074 Sharp Road PHONE 768-4194

Glenwood, Maryland Lot 7, sec. 1, area 1

PROPERTY LOCATION:  
SUBDIVISION Walden East The Heritage LOT NO. 6662

ROAD AND DESCRIPTION 4074 Sharp Road

SIZE OF LOT \_\_\_\_\_ TYPE BLDG. 3 or 4  
NUMBER OF BEDROOMS

IF NOT SINGLE RESIDENCE DESCRIBE \_\_\_\_\_

THE SYSTEM INSTALLED UNDER THIS APPLICATION IS ACCEPTABLE ONLY UNTIL PUBLIC FACILITIES BECOME AVAILABLE.

SIGNATURE OF APPLICANT Ed John Schneider

APPROVED BY F. Skinn FOR drywell DATE 9/2/83  
(KIND OF SYSTEM)


REJECTED BY \_\_\_\_\_ FOR \_\_\_\_\_ DATE \_\_\_\_\_  
(KIND OF SYSTEM)

HOLD PENDING FURTHER TESTS \_\_\_\_\_ DATE \_\_\_\_\_

REASONS FOR REJECTION OR HOLDING \_\_\_\_\_

BLDG. PERMIT SIGNED  
AND RETURNED Shelton  
Shelton 57949 5710

## THIS IS NOT A PERMIT

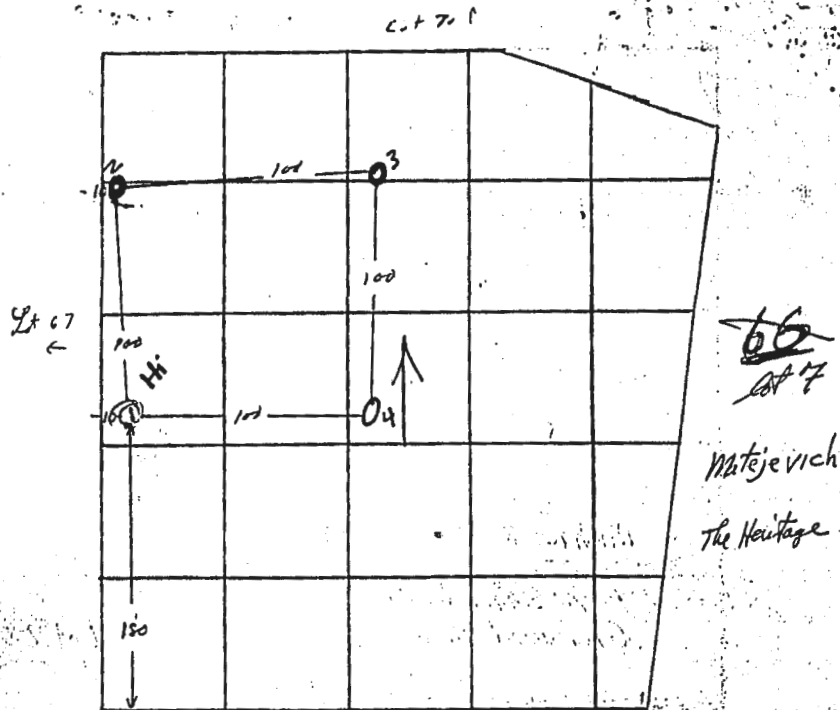

#4074 Sharp R.I.

DATE	TEST NO.	DEPTH	PRE-WET		TEST - 1" DROP		TIME
			START	STOP	START	STOP	
4/30	1	4	3 <sup>26</sup>	3 <sup>22</sup>	3 <sup>22</sup>	3 <sup>32</sup>	3
	1A	12	3 <sup>26</sup>	3 <sup>28</sup>	3 <sup>28</sup>	3 <sup>30</sup>	2
	2	4	3 <sup>22</sup>	3 <sup>25</sup>	3 <sup>35</sup>	3 <sup>40</sup>	5
	2A	12	3 <sup>30</sup>	3 <sup>28</sup>	3 <sup>38</sup>	3 <sup>50</sup>	12
	3	4	3 <sup>35</sup>	3 <sup>40</sup>	3 <sup>40</sup>	3 <sup>51</sup>	11
	3A	12	3 <sup>35</sup>	3 <sup>42</sup>	3 <sup>42</sup>	3 <sup>54</sup>	12
	4	12 VISUAL					

REMARKS \_\_\_\_\_

TYPE OF SOIL \_\_\_\_\_

TESTED BY R.M. ALSO PRESENT: \_\_\_\_\_