

C1

7695

SEQUENCE NO.

(DENV USE ONLY)

123

6

(THIS NUMBER IS TO BE PUNCHED

IN COLS. 3-6 ON ALL CARDS)

STATE OF MARYLAND

WELL COMPLETION REPORT

FILL IN THIS FORM COMPLETELY

PLEASE PRINT OR TYPE

THIS REPORT MUST BE SUBMITTED WITHIN

45 DAYS AFTER WELL IS COMPLETED.

COUNTY

NUMBER

A 44279

ST/CO USE ONLY

DATE Received

813

DATE WELL COMPLETED

090573

1520

Depth of Well

2228526

(TO NEAREST FOOT)

PERMIT NO.

FROM "PERMIT TO DRILL WELL"

10-92-1320

28293031323334353637

OWNER

1614

last name

first name

TOWN

Woodstock

STREET OR RFD

PARKSIDE

SECTION

LOT

7

WELL LOG

Not required for driven wells

STATE THE KIND OF FORMATIONS

PENETRATED, THEIR COLOR, DEPTH,

THICKNESS AND IF WATER BEARING

DESCRIPTION (Use additional sheets if needed)

FEET

FROM

TO

Check if water bearing

Top Soil

0

2

Sandy

2

20

Sand Stone

20

35

MICKA

35

75

Sand Stone

75

80

MICKA

80

205

GROUTING RECORD

yes

no

Y

N

44

44

WELL HAS BEEN GROUTED

(Circle Appropriate Box)

TYPE OF GROUTING MATERIAL

CEMENT

CM

BENTONITE CLAY

BC

45

46

45

46

NO. OF BAGS

NO. OF POUNDS

8

800

GALLONS OF WATER

48

DEPTH OF GROUT SEAL (to nearest foot)

from

ft.

to

ft.

48

52

54

58

TOP

BOTTOM

(enter 0 if from surface)

CASING RECORD

casing types insert appropriate code below

ST

CO

STEEL

CONCRETE

PL

OT

PLASTIC

OTHER

MAIN CASING TYPE

Nominal diameter top (main) casing (nearest inch)

Total depth of main casing (nearest foot)

PL

6

38

60

61

63

64

66

70

OTHER CASING (if used)

diameter inch

depth (feet) from to

EACH CASING

SCREEN RECORD

screen type or open hole

insert appropriate code below

ST

BR

HO

STEEL

BRASS

OPEN HOLE

PL

OT

PLASTIC

OTHER

C2

1

2

DEPTH (nearest ft.)

1

8

9

11

15

17

21

23

24

26

30

32

36

38

39

41

45

47

51

CIRCLE APPROPRIATE LETTER

A

A WELL WAS ABANDONED AND SEALED WHEN THIS WELL WAS COMPLETED

E

ELECTRIC LOG OBTAINED

P

TEST WELL CONVERTED TO PRODUCTION WELL

I HEREBY CERTIFY THAT THIS WELL HAS BEEN CONSTRUCTED IN ACCORDANCE WITH COMAR 26.04.04 "WELL CONSTRUCTION" AND IN CONFORMANCE WITH ALL CONDITIONS STATED IN THE ABOVE CAPTIONED PERMIT, AND THAT THE INFORMATION PRESENTED HEREIN IS ACCURATE AND COMPLETE TO THE BEST OF MY KNOWLEDGE.

DRILLERS IDENT. NO.

203

DRILLER'S SIGNATURE

(MUST MATCH SIGNATURE ON APPLICATION)

SITE SUPERVISOR (sign. of driller or journeyman responsible for sitework if different from permittee)

PUMPING TEST

HOURS PUMPED (nearest hour)

3

9

PUMPING RATE (gal. per min. to nearest gal.)

10

11

15

METHOD USED TO MEASURE PUMPING RATE

WATER LEVEL (distance from land surface)

BEFORE PUMPING

3

5

17

20

WHEN PUMPING

14

22

25

TYPE OF PUMP USED (for test)

A

air

P

piston

T

turbine

27

27

27

C

centrifugal

R

rotary

O

other (describe below)

27

27

27

J

jet

S

submersible

27

27

PUMP INSTALLED

DRILLER WILL INSTALL PUMP

YES

NO

(CIRCLE) (YES or NO)

IF DRILLER INSTALLS PUMP, THIS SECTION MUST BE COMPLETED FOR ALL WELLS EXCEPT HOME USE

TYPE OF PUMP INSTALLED

PLACE (A,C,J,P,R,S,T,O)

IN BOX - SEE ABOVE:

CAPACITY:

GALLONS PER MINUTE (to nearest gallon)

31

35

PUMP HORSE POWER

37

41

PUMP COLUMN LENGTH (nearest ft.)

43

47

CASING HEIGHT (circle appropriate box and enter casing height)

above

below

LAND SURFACE

2

(nearest foot)

50

51

LOCATION OF WELL ON LOT

SHOW PERMANENT STRUCTURE SUCH AS BUILDING, SEPTIC TANKS, AND/OR LANDMARKS AND INDICATE NOT LESS THAN TWO DISTANCES (MEASUREMENTS TO WELL)

150'

60'

Prop LINE

B 1 00213

SEQUENCE NO.  
(DP USE ONLY)

EMERGENCY / TEMP NO. IF ANY

STATE OF MARYLAND  
APPLICATION FOR PERMIT TO DRILL WELL  
please print or type

STATE PERMIT NUMBER

40-92-0320  
fill in this form completely

Date Received (APA)

02/18/93

## OWNER INFORMATION

JGM Construction Inc.  
15 Last Name Owner First Name 34  
422 W Maple Road  
36 Street or RFD 55  
112741 Cum 70 State 72 Zip 76  
MD 21090

## DRILLER INFORMATION

Ralph Mayne 223  
Driller's Name 77 License No. 80  
Ralph Mayne Well Drilling  
Firm Name  
9120 Brown Church Rd. Mt Airy  
Address  
Ralph Mayne 2/18/93  
Signature Date

## WELL INFORMATION

APPROX. PUMPING RATE (GAL. PER MIN.) 5  
AVERAGE DAILY QUANTITY NEEDED  
(GAL. PER DAY) 509  
14 20

## USE FOR WATER (CIRCLE APPROPRIATE BOX)

- ☒ D HOME (SINGLE OR DOUBLE HOUSEHOLD UNIT ONLY)  
☐ F FARMING (LIVESTOCK WATERING & AGRICULTURAL IRRIGATION)  
☐ I INDUSTRIAL, COMMERCIAL, STATE AND FEDERAL GOV. OTHER (REQUIRES APPROPRIATION PERMIT)  
☐ P PUBLIC OR PRIVATE WATER COMPANY (REQUIRES APPROPRIATION PERMIT AND STATE HEALTH DEPARTMENT APPROVAL)  
☐ T TEST, OBSERVATION, MONITORING (MAY REQUIRE APPROPRIATION PERMIT)

APPROXIMATE DEPTH OF WELL 150 FEET  
24 28

APPROXIMATE DIAMETER OF WELL 6" NEAREST INCH

## METHOD OF DRILLING (circle one)

BORED (or Augered) JETTED Jetted & DRIVEN  
AIR-ROTary AIR-PERCussion ROTARY (Hydraulic Rotary)  
CABLE REVERSE-ROTary DRIVE-POINT  
other

## REPLACEMENT OR DEEPEMED WELLS

(CIRCLE APPROPRIATE BOX)

- ☒ N THIS WELL WILL NOT REPLACE AN EXISTING WELL  
☐ Y THIS WELL WILL REPLACE A WELL THAT WILL BE ABANDONED AND SEALED  
☐ S THIS WELL WILL REPLACE A WELL THAT WILL BE USED AS A STANDBY  
☐ D THIS WELL WILL DEEPEN AN EXISTING WELL

PERMIT NUMBER OF WELL TO BE REPLACED OR DEEPEMED (IF AVAILABLE) 41 52

Not to be filled in by driller (OEP USE ONLY)

APPROP. PERMIT NUMBER 54 G A P 63


FORCE MD WRITE INITIALS IN BOX PERMIT No. 40-92-0320  
67 68 70 71 72 73 74 75 76 77 78 79

SPECIAL CONDITIONS


JGM Const 986-8108 CALL WHEN READY

## LOCATION OF WELL

HOWARD  
8 COUNTY 21  
PARKSIDE  
23 SUBDIVISION 42  
SECTION 44 46 LOT 48 50  
WOODSTOCK  
52 NEAREST TOWN 71  
MILES FROM TOWN (enter 0 if in town) 73 76 77 78

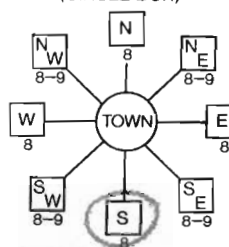B 4  
DIRECTION OF WELL FROM TOWN (CIRCLE BOX)NEAR WHAT ROAD  
Guarantee Horse Dr. 30

ON WHICH SIDE OF ROAD (CIRCLE APPROPRIATE BOX)

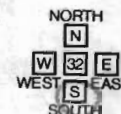DISTANCE FROM ROAD  
ENTER FT or MI 34 37 38 39NOT TO BE FILLED IN BY DRILLER  
HEALTH DEPARTMENT APPROVAL

Howard A44279  
COUNTY NAME COUNTY NO.  
STATE SIGNATURE INSERT S  
DATE ISSUED 03/10/93 Mark E. Rifkin 9/10/93  
NORTH GRID 543 0 0 0 EAST GRID 0833 0 0 0  
50 55 57 63

SHOW MAJOR FEATURES OF BOX &amp; LOCATE WELL WITH AN X

SOURCES OF DRILLING WATER


- well
- 
- 

WRITE THE BOX NUMBER FROM THE MAP HERE

E 8383  
N 5483

000  
000

DRAW A SKETCH BELOW SHOWING LOCATION OF WELL IN RELATION TO NEARBY TOWNS AND ROADS AND GIVE DISTANCE FROM WELL TO NEAREST ROAD JUNCTION

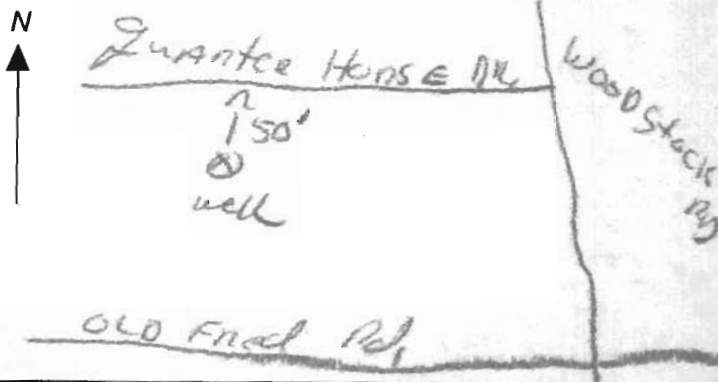

COUNTY

FIELD DATA SHEET  
HOWARD COUNTY WELL YIELD TEST

Well Permit No. HO - 92-0000320

Location of property (road)

Subdivision PARKSIDE

Well Driller R Mayne

Lot 7

*Block*

Plat

Sec.

Owner \_\_\_\_\_

~~Brooklyn~~

ICM Const

Depth of well

Distance of measuring point (M.P.) above ground

Static water level (S.W.L.) below M.P.

I. High rate pumping -- reservoir drawdown

Time pump started 9:00 AM

Pumping rate 10 GPM

Total time 15 min to reach pumping water level 400 ft. below M.P.

II. Recovery pump test data - observations to be recorded every 15 minutes

[illegible]




Well Permit No. HO - 92-0000320  
Location of property (road) Quarterhorse Dr  
Subdivision PARKSIDE Lot 7 Block Plat Sec.  
Well Driller R Mayne Owner Bracciate Vincent JGM Const.

Depth of well \_\_\_\_\_  
Distance of measuring point (M.P.) above ground \_\_\_\_\_  
Static water level (S.W.L.) below M.P. \_\_\_\_\_

Time pump started \_\_\_\_\_ Pumping rate \_\_\_\_\_  
Total time \_\_\_\_\_ to reach pumping water level \_\_\_\_\_ ft. below M.P.

[illegible]



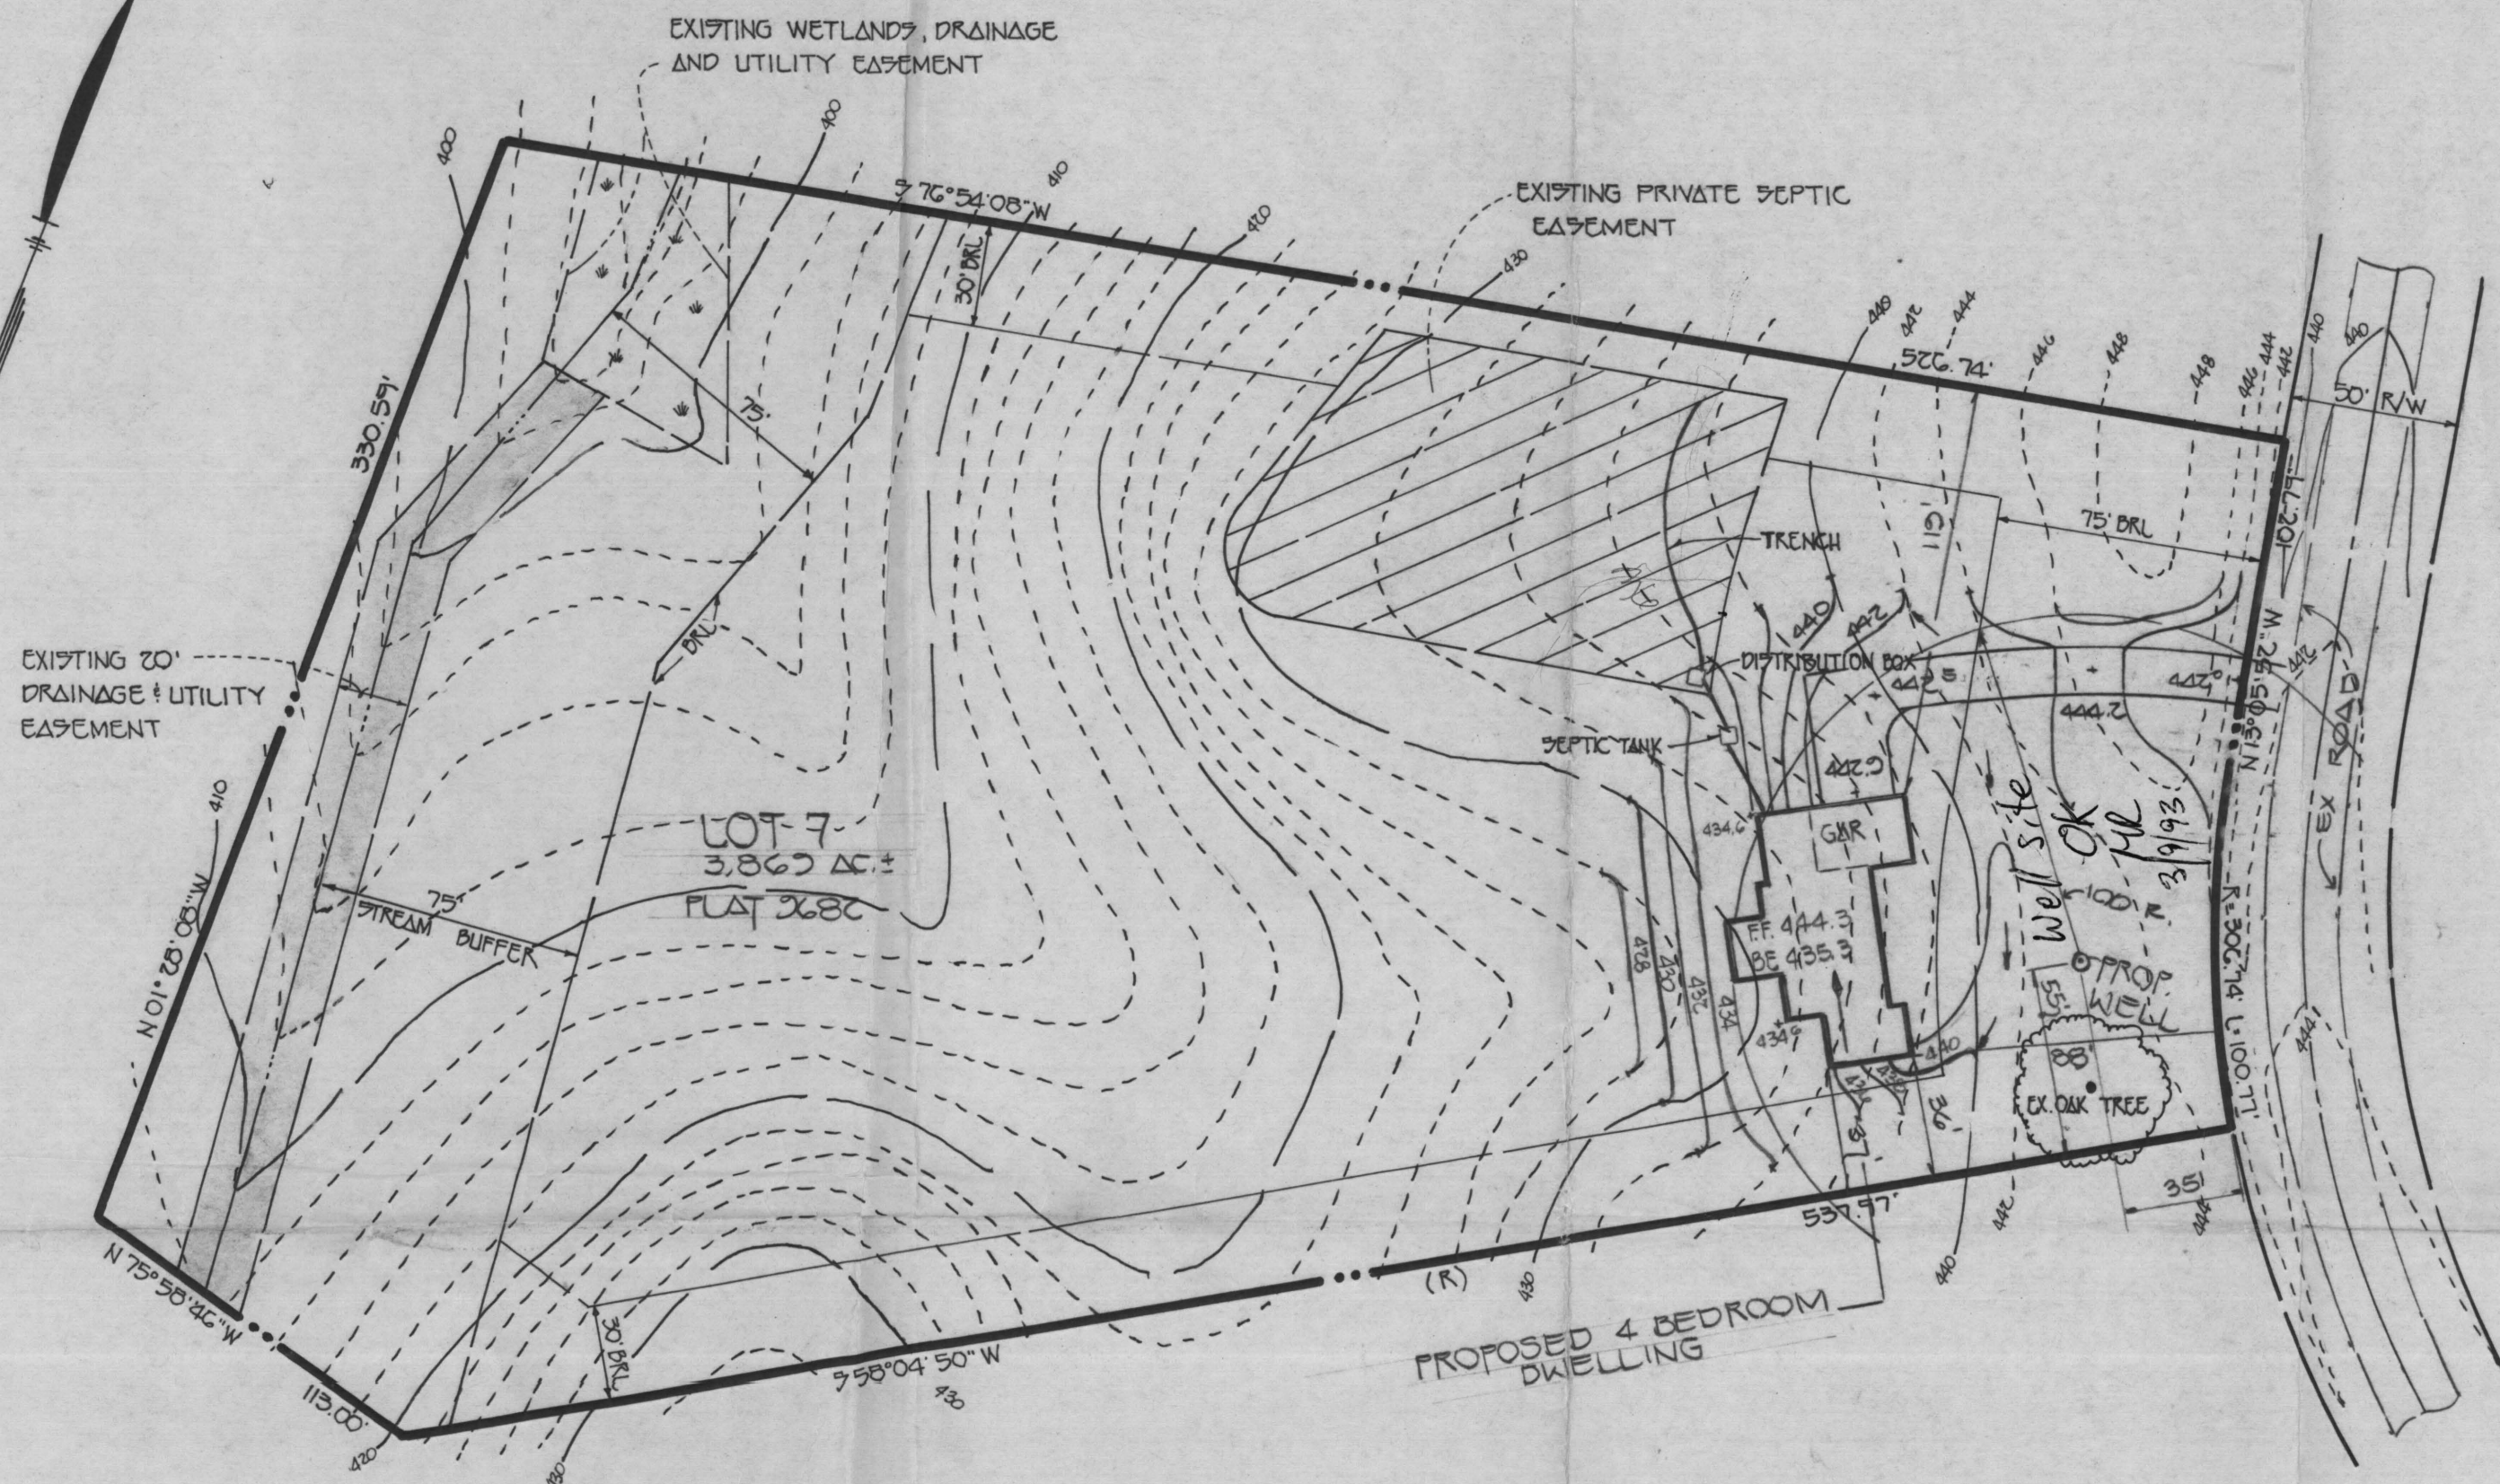

#### GENERAL NOTES

1. SEPTIC EASEMENT SUBJECT TO HOWARD COUNTY HEALTH DEPT. NO. A44279
2. PROPOSED 1500 GALLON SEPTIC TANK.
3.
  - A. FIRST FLOOR ELEVATION: 444.3
  - B. BASEMENT ELEVATION: 435.3
  - C. INVERT OF SEPTIC SYSTEM AT HOUSE: ~~435.5~~ 434.3
  - D. INVERT IN AT SEPTIC TANK: ~~435.5~~ 433.9
  - E. INVERT OUT AT SEPTIC TANK: ~~435.5~~ 433.6
  - F. PROPOSED GRADE OVER SEPTIC TANK: 435.5
  - G. INVERT AT DISTRIBUTION BOX: ~~435.0~~ 433.4
  - H. EXISTING GROUND OVER DISTRIBUTION BOX: ~~435.0~~ 436.0
4. LENGTH OF TRENCH TO BE DETERMINED AT TIME OF SEPTIC PERMIT ISSUANCE.
5. CONTRACTOR/BUILDER TO VERIFY ELEVATIONS IN FIELD BEFORE BEGINNING ANY CONSTRUCTION.

4-6-93  
 elev & location of  
 FF.

J. Bell

04/06/93

PLOT PLAN  
 TO ACCOMPANY APPLICATION FOR  
 BUILDING PERMIT  
 LOT 7

PARKSIDE



TAX MAP 10 ZONING R PARCEL 36  
 THIRD ELECTION DISTRICT HOWARD COUNTY, MARYLAND  
 SCALE: 1" = 50' DATE: FEBRUARY 10, 1993

FISHER, COLLINS & CARTER, INC.

CIVIL ENGINEERING CONSULTANTS & LAND SURVEYORS

7171 BALTIMORE NATIONAL PIKE, SUITE 100


ELLICOTT CITY, MARYLAND 21042


TELEPHONE: (410) 461-2555

FAX: (410) 750-3784

Parkside Lot 7



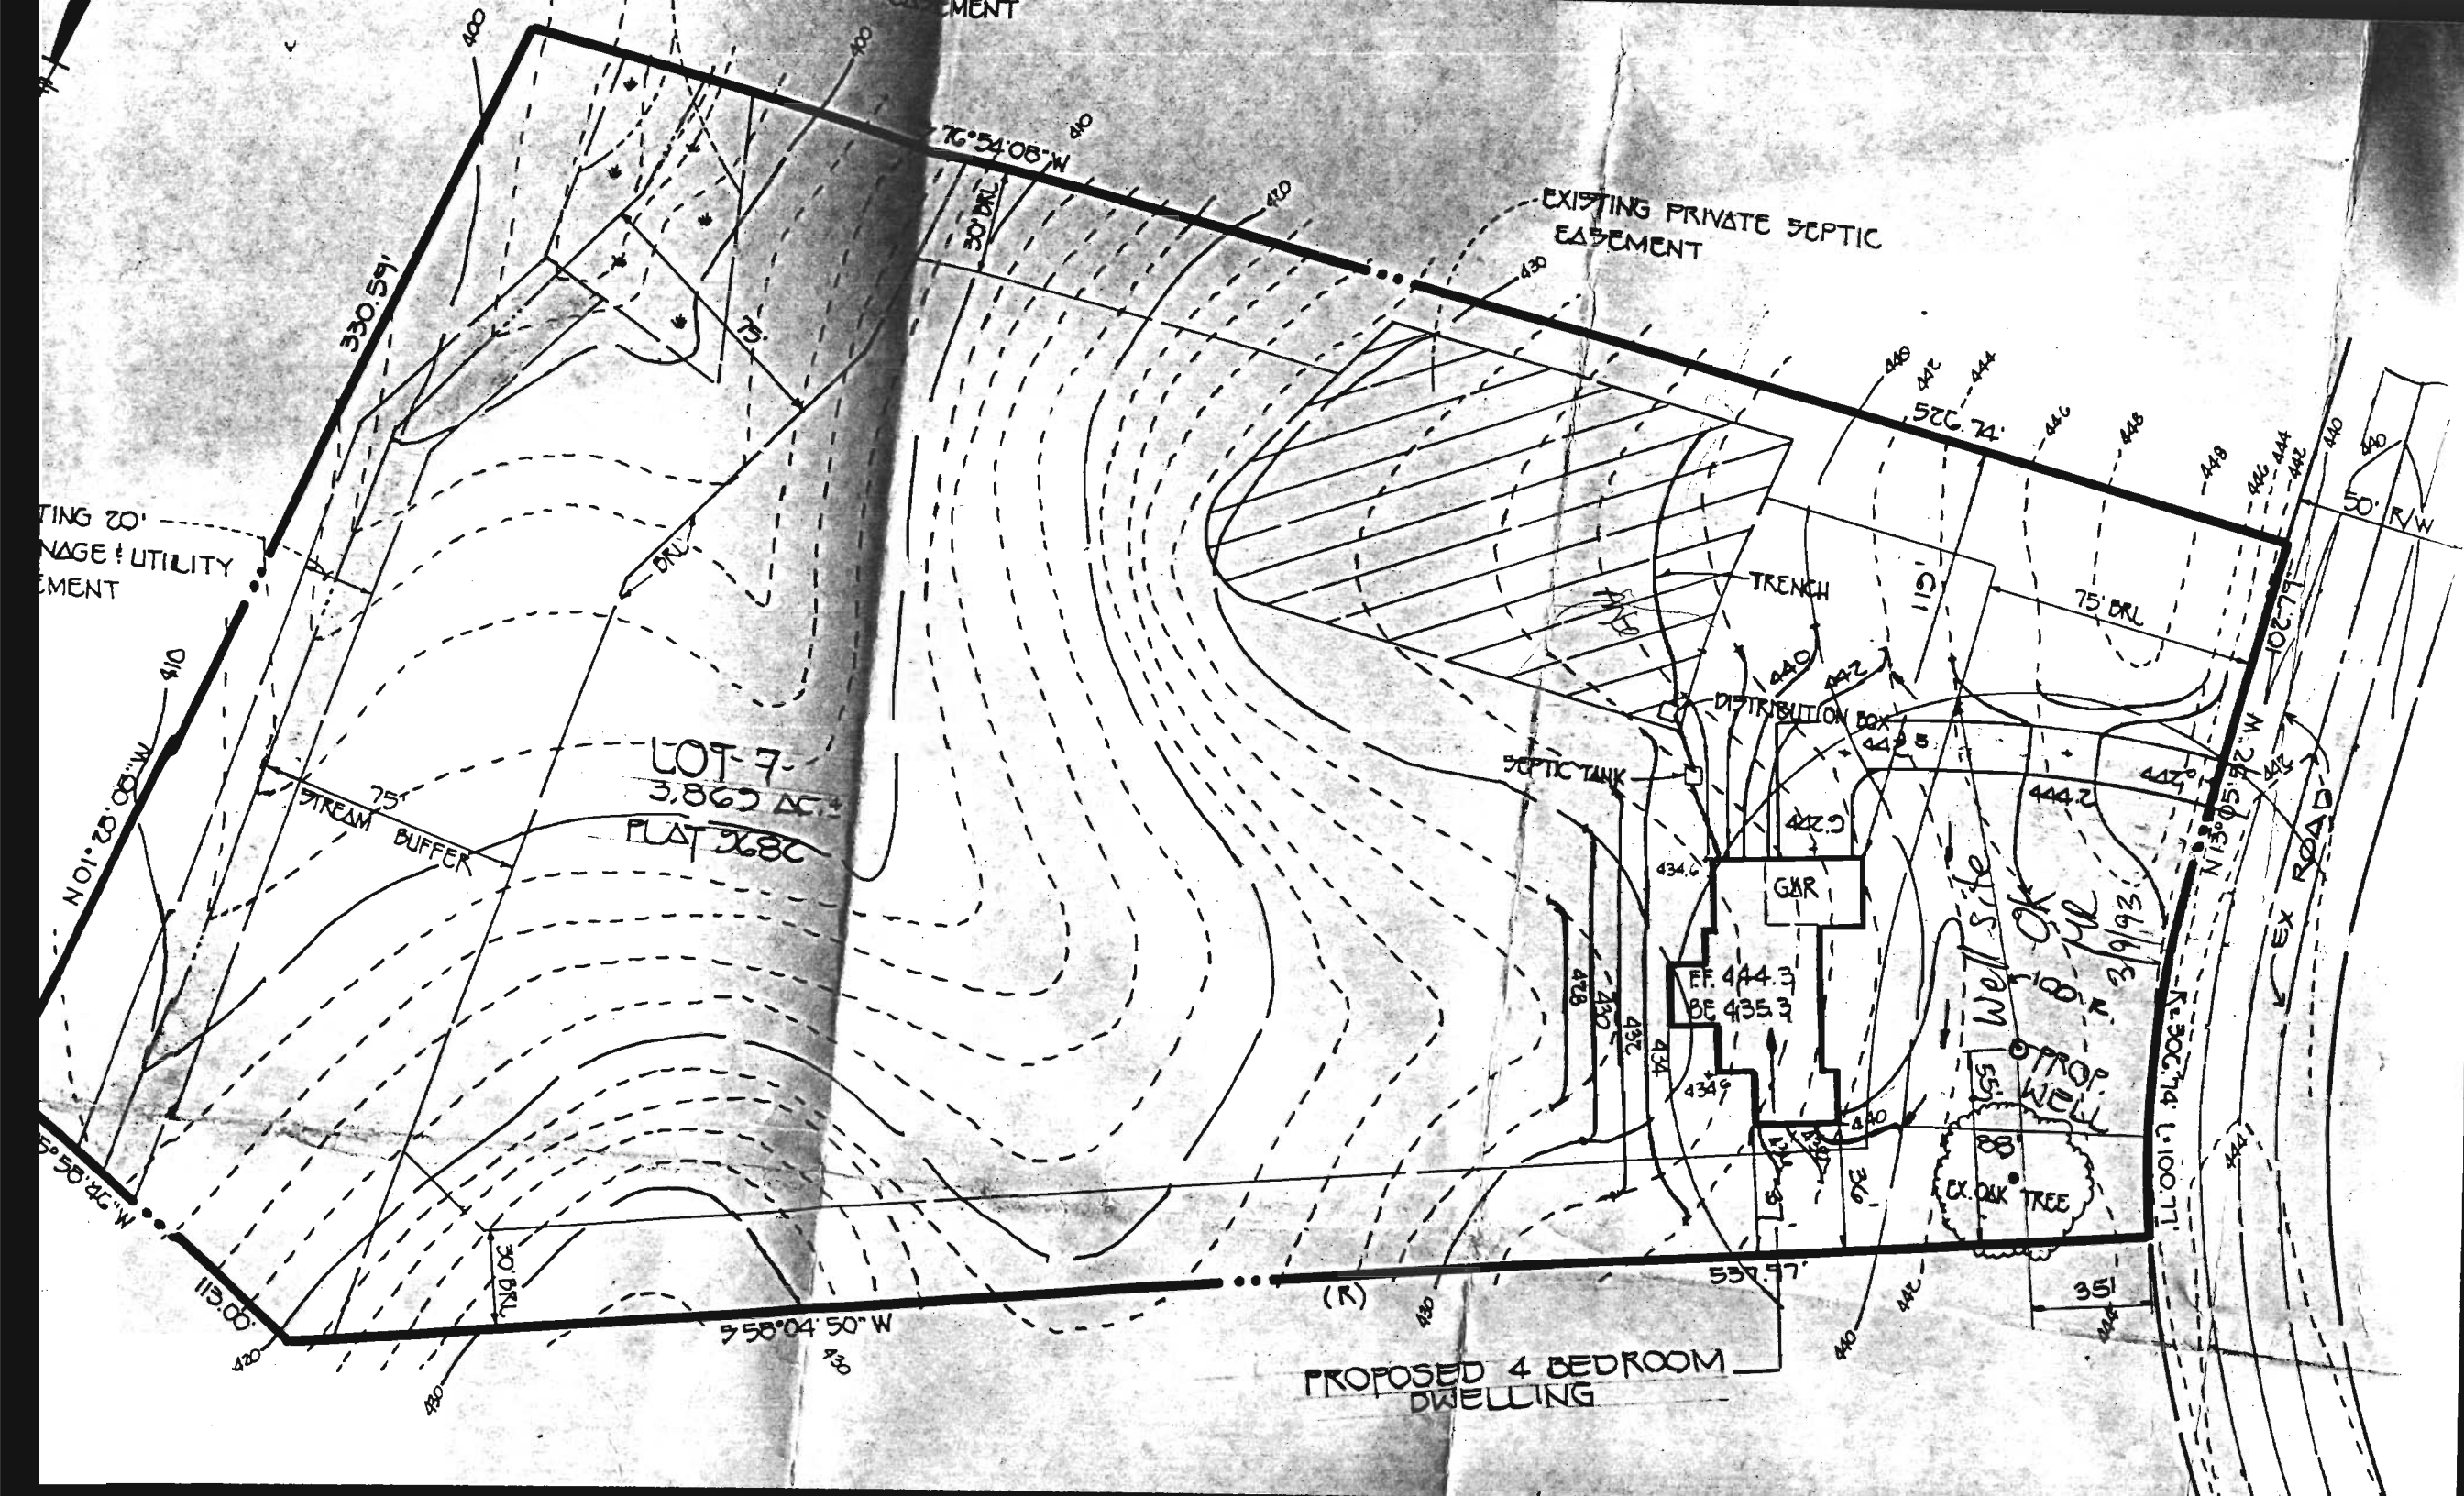

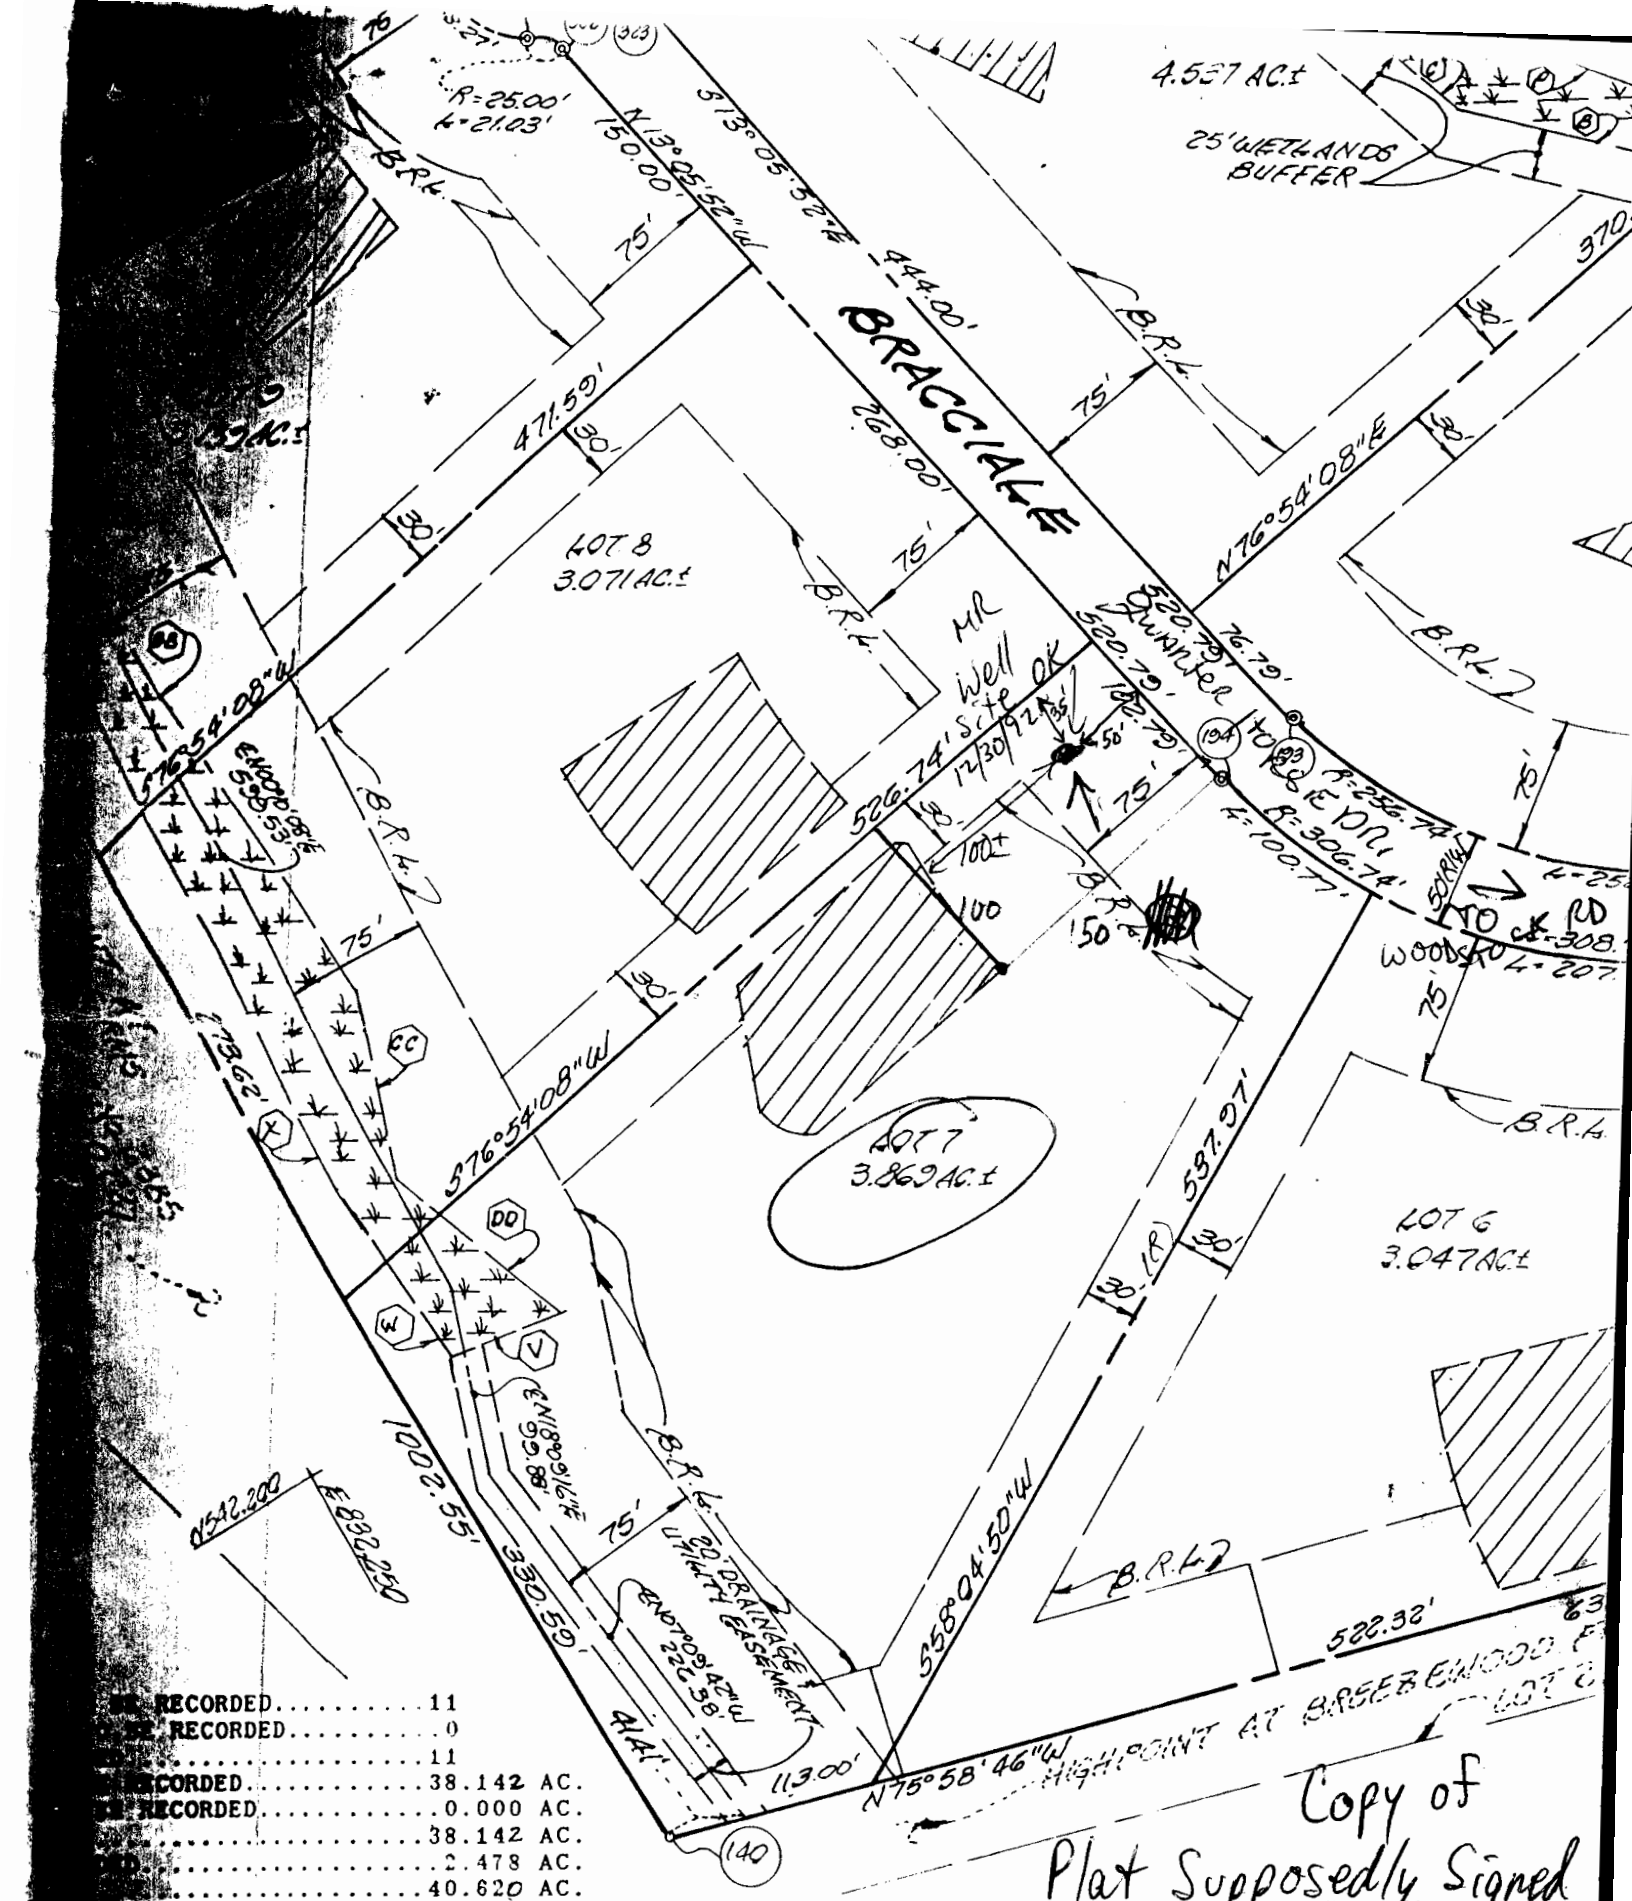

RECORDED	11
RECORDED	0
RECORDED	11
RECORDED	38.142 AC.
RECORDED	0.000 AC.
RECORDED	38.142 AC.
RECORDED	2.478 AC.
RECORDED	40.620 AC.

Copy of  
Plat Supposedly Signed

SEWERAGE  
DEPARTMENT.

**OWNER'S CERTIFICATE**  
WE, BRIAN KNAUFF, T.E. WISMATT CONSTRUCTION AND ASSOCIATES BY PATRICK CRE  
GENERAL PARTNER, VINCENT A. BRACCIALE, JR., AND TERESA BRACCIALE, OWNERS OF  
THE PROPERTY SHOWN AND DESCRIBED HEREON, HEREBY ADOPT THIS PLAN OF  
SUBDIVISION, AND IN CONSIDERATION OF THE APPROVAL OF THIS FINAL PLAT BY THE  
DEPARTMENT OF PLANNING AND ZONING, ESTABLISH THE MINIMUM BUILDING  
RESTRICTION LINE AND GRANT UNTO HOWARD COUNTY, MARYLAND, ITS SUCCESSORS  
AND ASSIGNS (1) THE RIGHT TO LAY, CONSTRUCT AND MAINTAIN SEWERS, DRAINAGE  
SYSTEMS AND SERVICES IN AND UNDER

Left on woodstock  
1/4 mile PARKSIDE Sub  
Granter Horse DR,