

7/25/73
final inspection

off 7-25-73
18775

PERMIT

SEWAGE DISPOSAL SYSTEM

MARYLAND STATE DEPARTMENT OF HEALTH

HOWARD COUNTY

ELLICOTT CITY

DISTRICT 4th

DATE 7/23/73

INDEXED

Jack Fyock

IS PERMITTED TO INSTALL ☒ ALTER ☐

ADDRESS Ten Oaks Road, Glenelg, Md.

PHONE 286-2939

A SEWAGE DISPOSAL SYSTEM LOCATED AT

SUBDIVISION Warfield Estates

ROAD 3408 Shady Lane

LOT 2B, Sect. 2

PROPERTY OWNER Maple Hill Farm Associates

ADDRESS 9300 Fontana Avenue, Seabrook, Md. 20801

SPECIFICATIONS 3 bedrooms

DRAIN FIELD DEPTH FEET, BOTTOM AREA SQ. FT.

SEEPAGE PITS ABSORBENT SIDE-WALL AREA SQ. FT.

SEPTIC TANK CAPACITY GALLONS

FOR GARBAGE GRINDER, INCREASE DISPOSAL AREA 22% & TANK CAPACITY 50%

OTHER DRY WELL 120 sq. ft. sidewall area below inlet. Dry well inlet to be no deeper than 3 ft. and bottom of dry well to be no deeper than 11 ft. Place the dry well 68 ft. from the back lot line and 51 ft. from the right side of the lot as seen when facing the lot from Shady Lane. Trench - 100 ft. long - 9 ft. deep - 6 ft. stone. Call for inspection of trench before gravel is installed.

NOTE: ALL PIPE FROM HOUSE TO DRY WELL MUST BE CAST IRON.

PERMIT VOID AFTER THREE YEARS.

NOTE: INSTALL STAND PIPE ON SEPTIC TANK AND DRY WELL.


PLANS APPROVED BY Raymond Hodges DATE 10/7/71

FILL SEPTIC TANK AND DISTRIBUTION BOX WITH WATER BEFORE CALLING FOR AN INSPECTION. COVER NO WORK UNTIL INSPECTED AND APPROVED.

NEITHER THE HOWARD COUNTY COMMISSIONERS NOR THE HEALTH DEPARTMENT IS RESPONSIBLE FOR THE SUCCESSFUL OPERATION OF ANY SYSTEM.

14811

INSPECTOR DATE SYSTEM APPROVED

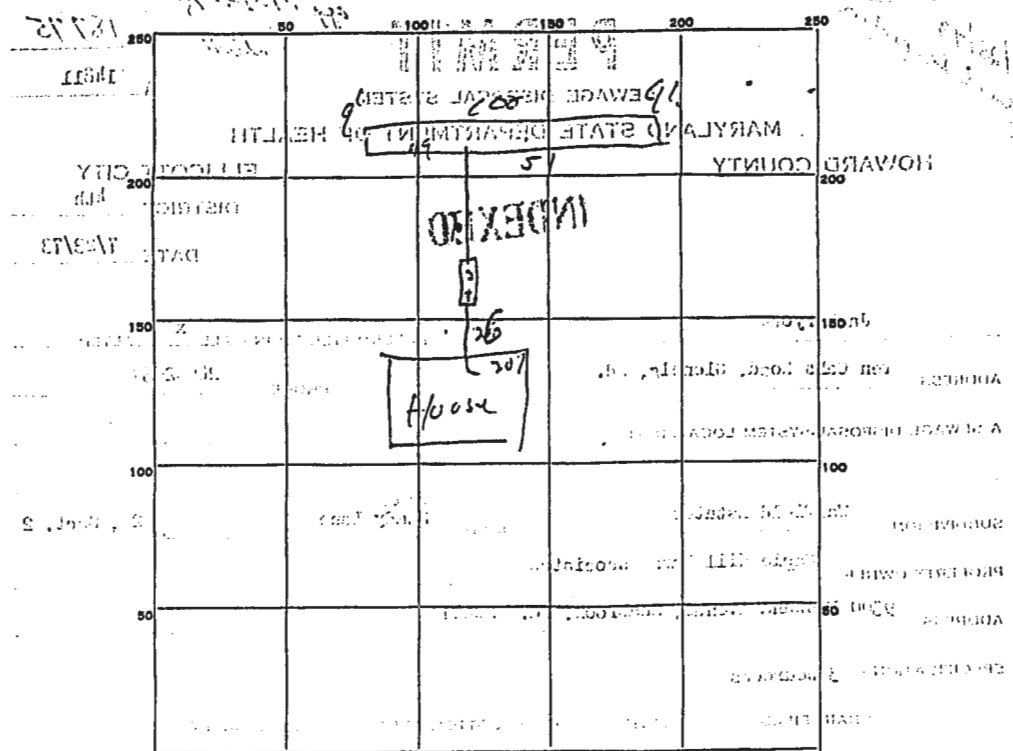

INDICATE NORTH - NAME ADJOINING ROADWAY AS BASE LINE.

PERMIT CARD OK

SEPTIC TANK, LEVEL OK CLEANOUTS OK

DISTRIBUTION BOX, LEVEL OK

TILE FIELD, DEPTH 9 FT. TRENCH WIDTH 2 FT.

GRAVEL DEPTH 7 IN. TOTAL LENGTH 100 FT.

NUMBER OF TRENCHES 1 TOTAL BOTTOM AREA 0.00

SEEPAGE PITS, INSIDE DIAMETER 18 IN. DEPTH BELOW INLET 1 FT.

ABSORBENT AREA 600 SQ. FT. ing hunk

REMARKS 7/21/73 OK to put gravel in trench

DATE SYSTEM APPROVED 7/25/73 INSPECTOR Jim Messing