



APPLICATION

FOR PERCOLATION TESTING AND SITE EVALUATION

TEST DATE(S) _____ TEST TIME _____

AGENCY REVIEW: _____

35164
A/P
DATE 4-20-11

DO NOT WRITE ABOVE THIS LINE

I HEREBY APPLY FOR THE NECESSARY TESTING/EVALUATION PRIOR TO ISSUANCE OF SEWAGE DISPOSAL SYSTEM PERMIT(S) TO:

CHECK AS NEEDED:

- ☐ CONSTRUCT NEW SEPTIC SYSTEM(S)
☒ REPAIR/ADD TO AN EXISTING SEPTIC SYSTEM
☐ REPLACE AN EXISTING SEPTIC SYSTEM

CHECK AS NEEDED:

- ☐ NEW STRUCTURE(S)
☐ ADDITION TO AN EXISTING STRUCTURE
☐ REPLACE AN EXISTING STRUCTURE

CHECK ONE:

- ☐ CREATE NEW LOT(S)
☐ BUILD ON AN EXISTING LOT IN A SUBDIVISION
☐ BUILD ON AN EXISTING PARCEL OF RECORD

IS THE PROPERTY WITHIN 2500' OF ANY RESERVOIR?

- ☐ YES
☒ NO

THE TYPE OF STRUCTURE IS: 3

- ☒ RESIDENTIAL WITH _____ PROPOSED BEDROOMS IN THE COMPLETED STRUCTURE (NOTE **UNKNOWN** IF APPROPRIATE)
☐ COMMERCIAL (PROVIDE DETAIL OF NUMBERS AND TYPES OF EMPLOYEES/ CUSTOMERS ON ACCOMPANYING PLAN)
☐ INSTITUTIONAL/GOVERNMENT (PROVIDE DETAIL OF NUMBERS AND TYPES OF EMPLOYEES/USERS ON ACCOMPANYING PLAN)

PROPERTY OWNER(S) Dennis M. Pagel

DAYTIME PHONE _____ CELL _____ FAX _____

MAILING ADDRESS 3408 Shady Lane Glenwood MD 21738
STREET CITY/TOWN STATE ZIP

APPLICANT Ronnie Deep J.M. Contracting LLC

DAYTIME PHONE 443-277-7526 CELL Same FAX 410-552-5815

MAILING ADDRESS 425 O Brought Rd Sykesville MD 21284
STREET CITY/TOWN STATE ZIP

APPLICANT'S ROLE: DEVELOPER BUILDER BUYER RELATIVE/FRIEND REALTOR CONSULTANT

Installer

PROPERTY LOCATION

SUBDIVISION/PROPERTY NAME

LOT NO.

PROPERTY ADDRESS 3408 Shady Lane Glenwood MD 21738
STREET TOWN/POST OFFICE

TAX MAP PAGE(S) _____ GRID _____ PARCEL(S) _____ PROPOSED LOT SIZE _____

AS APPLICANT, I UNDERSTAND THE FOLLOWING: THE SYSTEM INSTALLED SUBSEQUENT TO THIS APPLICATION IS ACCEPTABLE ONLY UNTIL PUBLIC SEWERAGE IS AVAILABLE. THIS APPLICATION IS COMPLETE WHEN ALL APPLICABLE FEES AND A SUITABLE SITE PLAN HAVE BEEN RECEIVED. I ACCEPT THE RESPONSIBILITY FOR COMPLIANCE WITH ALL M.O.S.H.A. AND "MISS UTILITY" REQUIREMENTS. APPROVAL IS BASED UPON SATISFACTORY REVIEW OF A PERC CERTIFICATION PLAN. TEST RESULTS WILL BE MAILED TO APPLICANT.

[Signature]
SIGNATURE OF APPLICANT

HOWARD COUNTY HEALTH DEPARTMENT, BUREAU OF ENVIRONMENTAL HEALTH, WELL AND SEPTIC PROGRAM
7178 COLUMBIA GATEWAY DRIVE COLUMBIA, MARYLAND 21046 (410) 313-2640 FAX (410) 313-2648
TDD (410) 313-2323 TOLL FREE 1-877-4MD-DHMH

shady Ln

Four line

Ex. House

HO-78-0210

De JK

4

5

510
S.A.

14' 7"

↓
So mass me,
slightly flexible,
slightly sticky,
5% shot change.

~~new section 401~~

1

Old Track
(Footed)

Possible
Thruway
Location

RECEIVED

APR 19 2011 SILVARIAN K. Wolf BACKHOE R. Hedges OTHERS Wood F.

HOWARD COUNTY BEACH INDETH. 2' INLET DEPTH 4' MAX. BOT DEPTH 9' EFFECTIVE SW

3BR $\rightarrow$ 450 sq ft

APPLICATION

SEWAGE DISPOSAL TESTING

MARYLAND STATE DEPARTMENT OF HEALTH

HOWARD COUNTY

A 14811

P _____

ELLICOTT CITY

DISTRICT 4

DATE 9/16/69

TO: THE COUNTY HEALTH OFFICER
ELLICOTT CITY, MARYLAND

I, HEREBY, APPLY FOR THE NECESSARY TESTS IN ORDER TO CONSTRUCT (OR RECONSTRUCT) A SEWAGE DISPOSAL SYSTEM.

PROPERTY OWNER: Maple Hill Farms Associates

ADDRESS: 9300 Fontana Ave., Seabrook, Md. 20801

Any questions call:

PHONE Mr. Silbermann

243-2584

PROPERTY LOCATION: On corner of

SUBDIVISION: W. A. ...

LOT NO: 2, Sec. 1

ROAD AND DESCRIPTION: Shady Lane

OCCUPANT: _____

PHONE: _____

PERSON TO CONSTRUCT SYSTEM: _____

ADDRESS: _____

PHONE: _____

SIZE OF LOT: 1601' x 2681' x 1481' x 2681'

TYPE BLDG. 3 or 4

NUMBER OF BEDROOMS

IF NOT SINGLE RESIDENCE DESCRIBE: _____

SIGNATURE OF APPLICANT: /s/ MacClintock & Huster

APPROVED BY: _____

FOR: _____

(KIND OF SYSTEM)

DATE: _____

REJECTED BY: _____

FOR: _____

(KIND OF SYSTEM)


DATE: _____

HOLD PENDING FURTHER TESTS: ☒

DATE: _____

REASONS FOR REJECTION OR HOLDING: _____

THIS IS NOT A PERMIT

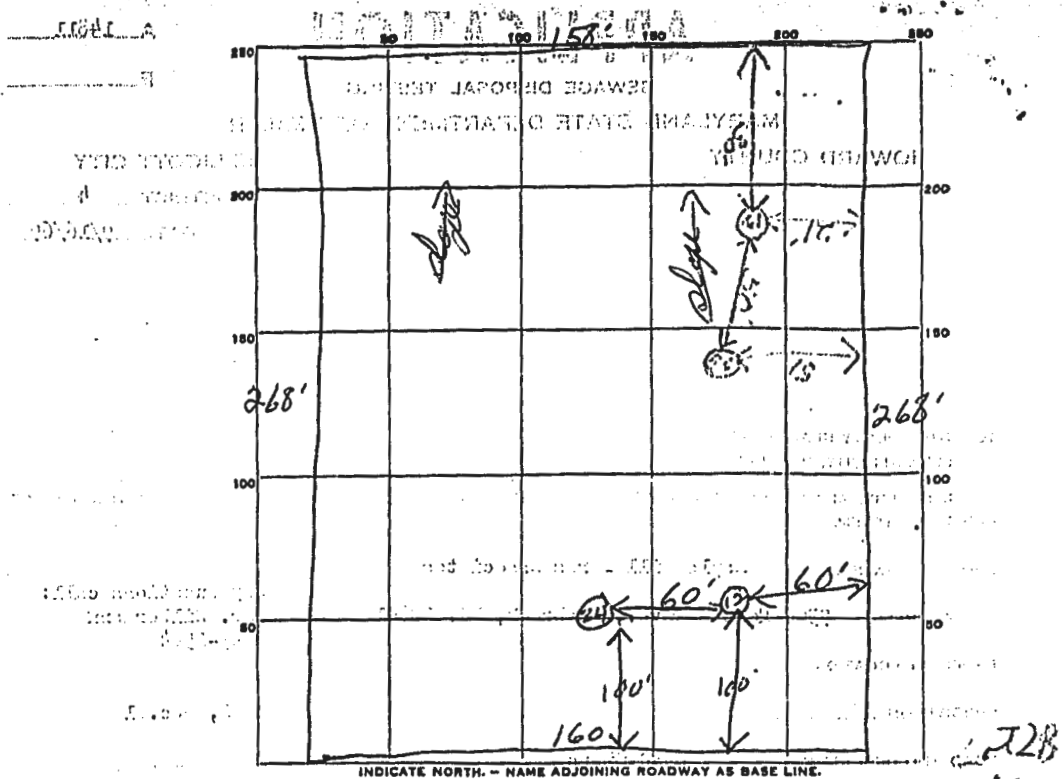

Shady Lane

DATE	TEST NO.	DEPTH	PRE-WET		TEST - 1" DROP		TIME	
			START	STOP	START	STOP		
9/25/69	1	10'	245	15 minutes	still on pump			
	2	5'	245	242	242	252	10 min	
	3	10'	302	slow no pump				
	4	5'	302	slow				
	5	10'	1102	1102	1104	1102	2 min	
	6	30'	1102	1102	1102	1106	3 min	
	7	11'	1112	1115	1115	1130	15 min	
	8	3'	1105	1114	1114	1122	13 min	

total 33 min
5 min AV

SOIL AUGER FINDING.

TESTED BY

REMARKS:

REMARKS: ~~12 ft Clay Water 11 ft~~ Re Perculation