

6/1/71
if possible

off 6-2-71
shy

PERMIT

SEWAGE DISPOSAL SYSTEM

MARYLAND STATE DEPARTMENT OF HEALTH

HOWARD COUNTY

ELLICOTT CITY

DISTRICT 4

DATE 5/25/71

INDEXED

Jack Fyock IS PERMITTED TO INSTALL X ALTER

ADDRESS Tan Oaks Road, Glenelg, Md. PHONE 286-2939

A SEWAGE DISPOSAL SYSTEM LOCATED AT

SUBDIVISION Warfield Estates ROAD Shady Lane LOT 5, Sec. 1

PROPERTY OWNER Stephen T. Walker 725-2103

ADDRESS

SPECIFICATIONS - 4 bedrooms

DRAIN FIELD DEPTH FEET, BOTTOM AREA SQ. FT.

SEEPAGE PITS ABSORBENT SIDE-WALL AREA SQ. FT.

SEPTIC TANK CAPACITY 1,200 GALLONS

FOR GARBAGE GRINDER, INCREASE DISPOSAL AREA 22% & TANK CAPACITY 50%.

OTHER Dry well - 500 sq. ft. - Locate dry well on right rear side of lot.

43' from right lot line and 98' from rear lot line. Inlet 4 1/2 ft. below
original grade. Maximum depth 10 ft. from original grade.

NOTE: CALL PIPE FROM HOUSE TO SEPTIC TANK MUST BE CAST IRON.


PERMIT VOID AFTER THREE YEARS.

PLANS APPROVED BY Palmer Wine/Frommelt DATE 5/25/71

FILL SEPTIC TANK AND DISTRIBUTION BOX WITH WATER BEFORE CALLING FOR AN INSPECTION. COVER NO WORK UNTIL INSPECTED AND APPROVED.

NEITHER THE HOWARD COUNTY COMMISSIONERS NOR THE HEALTH DEPARTMENT IS RESPONSIBLE FOR THE SUCCESSFUL OPERATION OF ANY SYSTEM.

A-14808

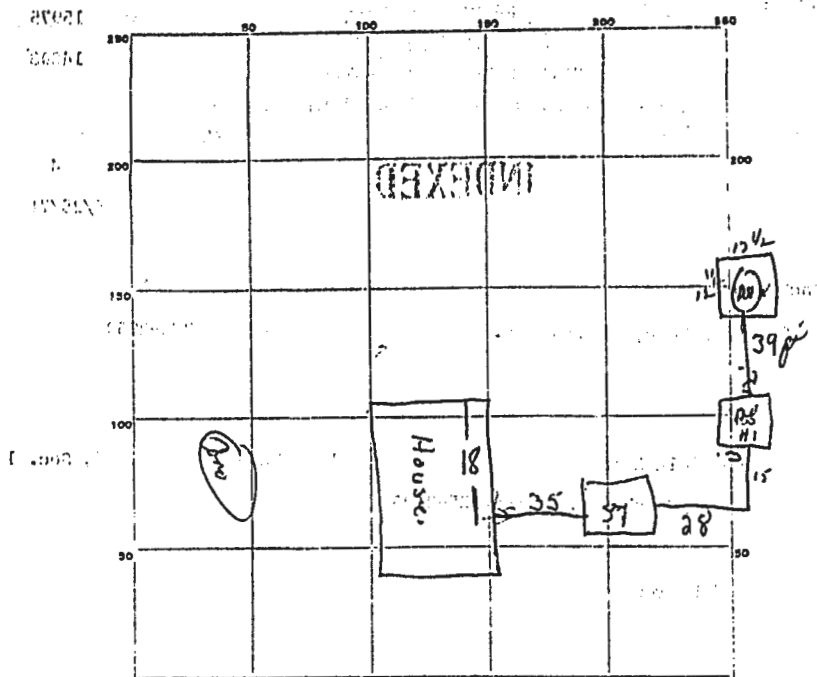

PERMIT CARD OK

SEPTIC TANK, LEVEL OK CLEANOUTS OK

DISTRIBUTION BOX, LEVEL _____

TILE FIELD, DEPTH _____ FT. TRENCH WIDTH _____ FT.

GRAVEL DEPTH _____ IN. TOTAL LENGTH _____ FT.

NUMBER OF TRENCHES _____ TOTAL BOTTOM AREA _____

SEEPAGE PITS, INSIDE DIAMETER _____ FT. DEPTH BELOW INLET _____ FT.

ABSORBENT AREA _____ SQ. FT.

REMARKS 6-2-71 permit DW #1 = 50 ft x depth below 5 ft 27.5 sq ft 5.50 sq ft
" " " = 50 ft " " 5 1/2 27.5 sq ft

DATE SYSTEM APPROVED 6-2-71 INSPECTOR [Signature]