

APPLICATION

PERCOLATION TESTING

A 38116

P _____

HOWARD COUNTY HEALTH DEPARTMENT
BUREAU OF ENVIRONMENTAL HEALTH
P.O. BOX 476 ELLICOTT CITY, MARYLAND 21043
TELEPHONE: 461-9933

DISTRICT _____

DATE 11/28/86

TO: THE COUNTY HEALTH OFFICER
ELLICOTT CITY, MARYLAND

I, HEREBY, APPLY FOR THE NECESSARY TEST IN ORDER TO CONSTRUCT (OR RECONSTRUCT) A SEWAGE DISPOSAL SYSTEM.

PROPERTY OWNER Springhill Associates - c/o Stanley Katz & Associates, Inc.

ADDRESS 11 Warren Road, Baltimore, MD 21208 PHONE (301) 484-4100

PROSPECTIVE BUYER N/A

ADDRESS _____ PHONE _____

PROPERTY LOCATION:

SUBDIVISION Meadowood LOT NO. 10 X 75

ROAD AND DESCRIPTION Henryton Road - approximately 4000' north of Tunnel Road
Howard County, Maryland (1213 Shady Creek Rd)

TAX MAP 10 PARCEL # 139

SIZE OF LOT 3+ Acres TYPE BLDG. Single Family

BLDG. PERMIT SIGNED

AND RETURNED 12/24/86

Serial # 90057-570

Single Family

(SINGLE FAMILY DWELLING OR COMMERCIAL)

THE SYSTEM INSTALLED UNDER THIS APPLICATION IS ACCEPTABLE ONLY UNTIL PUBLIC FACILITIES BECOME AVAILABLE. I FULLY UNDERSTAND THE

FEE CONNECTED WITH THE FILING OF THIS PERC TEST APPLICATION IS NON-REFUNDABLE UNDER ANY CIRCUMSTANCES. I ALSO AGREE TO COMPLY

WITH ALL M.O.S.H.A. REQUIREMENTS IN TESTING THIS LOT.

SIGNATURE OF APPLICANT Mike Sedgwick

APPROVED BY B. Nylan FOR SHALLOW ONLY DATE 12/29/87

REJECTED BY C. W. ... FOR _____ DATE 2/16/87

HOLD PENDING FURTHER TESTS _____ DATE _____

REASONS FOR REJECTION OR HOLDING 12/17/86 PERC. SATISFACTORY; HOLD FOR SUBDIVISION PLAT. S.A.M.

12/16/87 PLAT IN CORRECT - RE-LOCATE ALL HOLES, CW

4' BUFFER ZONE NOT ESTABLISHED.


THIS IS NOT A PERMIT

A38116

①②

SOIL PROFILE

4" A-3
Yellow Br
Silt loam
L90% clay
10-15%
Foss
3' TM/BL
SANDY
Silt loam
Highly
micaceous
40%
GI
10.5' HARD
BOTTOM

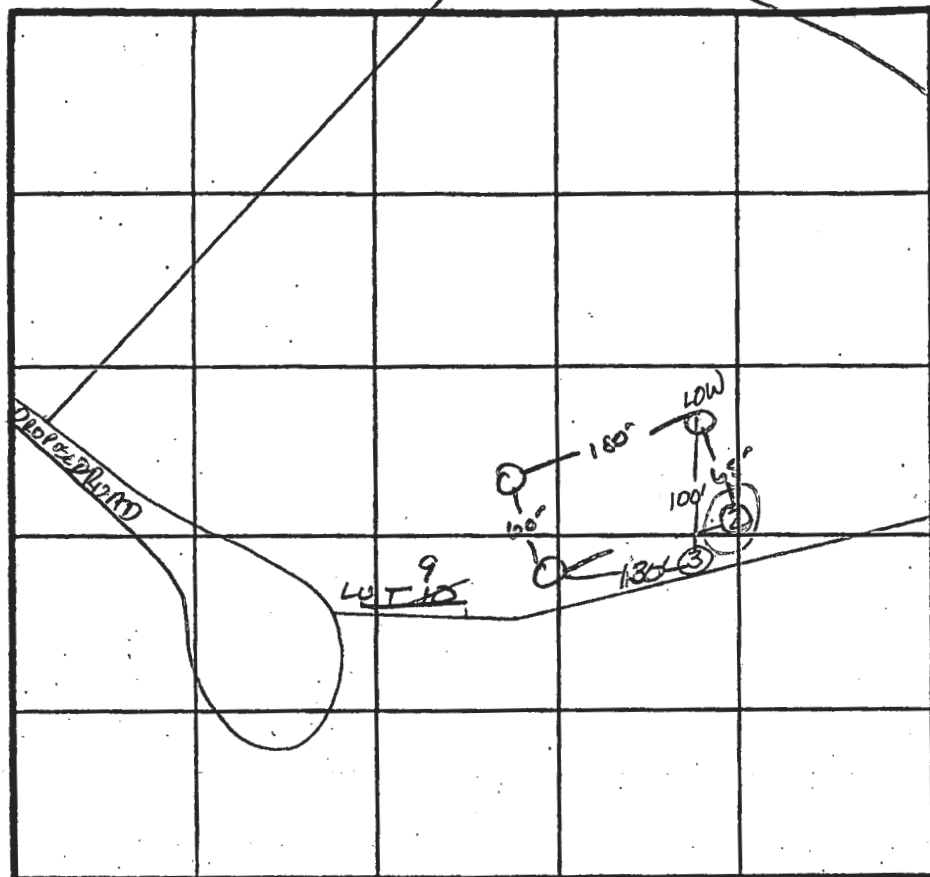

X Perc
2 min
180
160 A/BL
INLET 3'
BOTTOM 5'

INDICATE NORTH - NAME ADJOINING ROADWAY AS BASE LINE.

↓ TO HENRY TON RD.

DATE	TEST NO.	DEPTH	PRE-WET		TEST - 1" DROP		TIME
			START	STOP	START	STOP	
14/7/84	1 S	3.5' 10.5'	10:48	10:49	10:49	10:50	1 min
	2 V	STRUCTURED	SAPPHIRE - MICASCHIST AT 6'-7'				
	3 S	3.5' 11.5'	10:53	10:54	10:54	10:55	1 min
	4 S	4' 8'	11:31	11:32	11:32	11:34	2 min
	4 M		11:30	11:31	11:31	11:32	1 min
	4 V	12' UNIFORM SOIL Below 3'					
	5 V	12' UNIFORM SOIL below 3'					

REMARKS

Shallow Syst. only / Issues Slightly Diff. than P&T

TYPE OF SOIL

Glenelg

TESTED BY

S. Abel

ALSO PRESENT

Pyke & Co. joined (S)