

COUNTY

B 1 <div style="border: 1px solid black; padding: 2px; display: inline-block;">3057</div> <small>(THIS NUMBER IS TO BE PUNCHED IN COLS. 3-6 ON ALL CARDS)</small>	SEQUENCE NO. (MDE USE ONLY)	STATE OF MARYLAND PERMIT TO DRILL WELL please print or type	STATE PERMIT NUMBER <div style="border: 1px solid black; padding: 2px; display: inline-block;">H0-93-0300</div> <small>fill in this form completely</small>
Date Received (APA) <div style="border: 1px solid black; padding: 2px; display: inline-block;">09/01/96</div> OWNER INFORMATION <div style="border: 1px solid black; padding: 2px; display: inline-block;">DAVIDSON</div> <div style="border: 1px solid black; padding: 2px; display: inline-block;">SHAME</div> <small>15 Last Name Owner First Name</small> <div style="border: 1px solid black; padding: 2px; display: inline-block;">1330 SCHAFFERSVILLE</div> <div style="border: 1px solid black; padding: 2px; display: inline-block;">44 RD</div> <small>36 Street or RFD 55</small> <div style="border: 1px solid black; padding: 2px; display: inline-block;">MT AIRY</div> <div style="border: 1px solid black; padding: 2px; display: inline-block;">MD 21771</div> <small>57 Town 70 State 72 Zip 76</small>		B 3 LOCATION OF WELL <div style="border: 1px solid black; padding: 2px; display: inline-block;">HOWARD</div> <small>8 COUNTY 21</small> <div style="border: 1px solid black; padding: 2px; display: inline-block;">23 SUBDIVISION</div> <div style="border: 1px solid black; padding: 2px; display: inline-block;">42</div> <small>SECTION 44 46 LOT 48 50</small> <div style="border: 1px solid black; padding: 2px; display: inline-block;">MT AIRY</div> <div style="border: 1px solid black; padding: 2px; display: inline-block;">MD 21771</div> <small>52 NEAREST TOWN 71</small> MILES FROM TOWN (enter 0 if in town) <div style="border: 1px solid black; padding: 2px; display: inline-block;">4</div> <div style="border: 1px solid black; padding: 2px; display: inline-block;">MI</div> <small>73 76 77 78</small>	
DRILLER INFORMATION CIRCLE: MSD/MGD/MWD <div style="border: 1px solid black; padding: 2px; display: inline-block;">Joseph L. Mayo</div> <div style="border: 1px solid black; padding: 2px; display: inline-block;">24</div> <small>Driller's Name 77 License No. 80</small> <div style="border: 1px solid black; padding: 2px; display: inline-block;">Joseph L. Mayo Well Drilling</div> <small>81 Firm Name</small> <div style="border: 1px solid black; padding: 2px; display: inline-block;">5512 Ridge Rd. Mt. Airy Md. 21771</div> <small>82 Address</small> <div style="border: 1px solid black; padding: 2px; display: inline-block;">Joseph L. Mayo</div> <div style="border: 1px solid black; padding: 2px; display: inline-block;">3/30/96</div> <small>83 Signature Date</small>		B 4 DIRECTION OF WELL FROM TOWN (CIRCLE BOX) ON WHICH SIDE OF ROAD (CIRCLE APPROPRIATE BOX) <div style="border: 1px solid black; padding: 2px; display: inline-block;">Shaffersville Road</div> <div style="border: 1px solid black; padding: 2px; display: inline-block;">30</div> <small>11 NEAR WHAT ROAD</small> ON WHICH SIDE OF ROAD (CIRCLE APPROPRIATE BOX) <div style="border: 1px solid black; padding: 2px; display: inline-block;">34</div> <div style="border: 1px solid black; padding: 2px; display: inline-block;">37</div> <small>34 36 37</small> DISTANCE FROM ROAD ENTER FT OR MI <div style="border: 1px solid black; padding: 2px; display: inline-block;">MI</div> <small>38 39</small> TAX MAP: BLK: PARCEL:	
B 2 WELL INFORMATION APPROX. PUMPING RATE (GAL. PER MIN.) <div style="border: 1px solid black; padding: 2px; display: inline-block;">5</div> <div style="border: 1px solid black; padding: 2px; display: inline-block;">0</div> <div style="border: 1px solid black; padding: 2px; display: inline-block;">0</div> <small>8 12</small> AVERAGE DAILY QUANTITY NEEDED (GAL. PER DAY) <div style="border: 1px solid black; padding: 2px; display: inline-block;">500</div> <div style="border: 1px solid black; padding: 2px; display: inline-block;">0</div> <div style="border: 1px solid black; padding: 2px; display: inline-block;">0</div> <div style="border: 1px solid black; padding: 2px; display: inline-block;">0</div> <small>14 20</small>		USE FOR WATER (CIRCLE APPROPRIATE BOX) <input checked="" type="radio"/> HOME (SINGLE OR DOUBLE HOUSEHOLD UNIT ONLY) <input type="radio"/> FARMING (LIVESTOCK WATERING & AGRICULTURAL IRRIGATION) <input type="radio"/> INDUSTRIAL, COMMERCIAL, STATE AND FEDERAL GOV. OTHER (REQUIRES APPROPRIATION PERMIT) <input type="radio"/> PUBLIC OR PRIVATE WATER COMPANY (REQUIRES APPROPRIATION PERMIT AND STATE HEALTH DEPARTMENT APPROVAL) <input type="radio"/> TEST, OBSERVATION, MONITORING (MAY REQUIRE APPROPRIATION PERMIT)	
APPROXIMATE DEPTH OF WELL <div style="border: 1px solid black; padding: 2px; display: inline-block;">290</div> <div style="border: 1px solid black; padding: 2px; display: inline-block;">0</div> <div style="border: 1px solid black; padding: 2px; display: inline-block;">0</div> FEET <small>24 28</small> APPROXIMATE DIAMETER OF WELL <div style="border: 1px solid black; padding: 2px; display: inline-block;">6</div> INCH <small>NEAREST INCH</small>		NOT TO BE FILLED IN BY DRILLER HEALTH DEPARTMENT APPROVAL <div style="border: 1px solid black; padding: 2px; display: inline-block;">HOWARD</div> <div style="border: 1px solid black; padding: 2px; display: inline-block;">A-31820</div> <small>COUNTY NAME COUNTY NO.</small> STATE SIGNATURE _____ INSERT S _____ DATE ISSUED <div style="border: 1px solid black; padding: 2px; display: inline-block;">09/01/96</div> <div style="border: 1px solid black; padding: 2px; display: inline-block;">Blk. Jay</div> <div style="border: 1px solid black; padding: 2px; display: inline-block;">4/1/97</div> <small>43 48 CO SIGNATURE EXP. DATE</small> NORTH GRID <div style="border: 1px solid black; padding: 2px; display: inline-block;">540000</div> EAST GRID <div style="border: 1px solid black; padding: 2px; display: inline-block;">760000</div> <small>50 55 57 63</small>	
METHOD OF DRILLING (circle one) BORED (or Augered) JETTED Jetted & DRIVEN <small>30 37</small> <div style="border: 1px solid black; padding: 2px; display: inline-block;">AIR-ROTARY</div> <div style="border: 1px solid black; padding: 2px; display: inline-block;">AIR-PERCussion</div> <div style="border: 1px solid black; padding: 2px; display: inline-block;">ROTARY (Hydraulic Rotary)</div> <div style="border: 1px solid black; padding: 2px; display: inline-block;">CABLE</div> <div style="border: 1px solid black; padding: 2px; display: inline-block;">REVERSE-ROTARY</div> <div style="border: 1px solid black; padding: 2px; display: inline-block;">Drive-POINT</div> <small>other</small>		SHOW MAJOR FEATURES OF BOX & LOCATE WELL WITH AN X SOURCES OF DRILLING WATER 1. WELL 2. 3. WRITE THE BOX NUMBER FROM THE MAP HERE <div style="border: 1px solid black; padding: 2px; display: inline-block;">E 760</div> <div style="border: 1px solid black; padding: 2px; display: inline-block;">N 540</div> <small>000 000</small>	
REPLACEMENT OR DEEPEMED WELLS (CIRCLE APPROPRIATE BOX) <input type="radio"/> THIS WELL WILL NOT REPLACE AN EXISTING WELL <input checked="" type="radio"/> THIS WELL WILL REPLACE A WELL THAT WILL BE ABANDONED AND SEALED <small>39</small> <input checked="" type="radio"/> THIS WELL WILL REPLACE A WELL THAT WILL BE USED AS A STANDBY-CONTACT LOCAL APPROVING AUTHORITY FOR POLICY ON STANDBY WELLS <input type="radio"/> THIS WELL WILL DEEPEMED AN EXISTING WELL PERMIT NUMBER OF WELL TO BE REPLACED OR DEEPEMED (IF AVAILABLE) <div style="border: 1px solid black; padding: 2px; display: inline-block;">41</div> <div style="border: 1px solid black; padding: 2px; display: inline-block;">52</div>		DRAW A SKETCH BELOW SHOWING LOCATION OF WELL IN RELATION TO NEARBY TOWNS AND ROADS AND GIVE DISTANCE FROM WELL TO NEAREST ROAD JUNCTION <div style="border: 1px solid black; padding: 2px; display: inline-block;">N Mt. Airy</div> <div style="border: 1px solid black; padding: 2px; display: inline-block;">Md.</div> <div style="border: 1px solid black; padding: 2px; display: inline-block;">144</div> 	
Not to be filled in by driller (MDE OR COUNTY USE ONLY) APPROP. PERMIT NUMBER <div style="border: 1px solid black; padding: 2px; display: inline-block;">54</div> <div style="border: 1px solid black; padding: 2px; display: inline-block;">GAP</div> <div style="border: 1px solid black; padding: 2px; display: inline-block;">63</div> FORCE <div style="border: 1px solid black; padding: 2px; display: inline-block;">G3</div> WRITE INITIALS IN BOX PERMIT No. <div style="border: 1px solid black; padding: 2px; display: inline-block;">H0-93-0300</div> <small>67 68 70 71 72 73 74 75 76 77 78 79</small>			
SPECIAL CONDITIONS <small>NOTE - APPROVING AUTHORITIES SHOULD USE SEPARATE SHEET IF NEEDED -</small>			

3/12/96
meet driller 1:00
3/29/96
Meet Driller (J. Mayne)
at site 3:PM

SITE INSPECTION SHEET

OWNER: Shane B. Davidson CO-OWNER

DATE REQUESTED: March 12, 1993

ADDRESS: 1330 Schaffersville Road

DRILLER: Joseph Mayne

410-795-4450


WELL TAG # _____

(BUS DRIVER)

COUNTY # _____

PROPOSAL: Replacement well site inspection.

LOCATION DIAGRAM

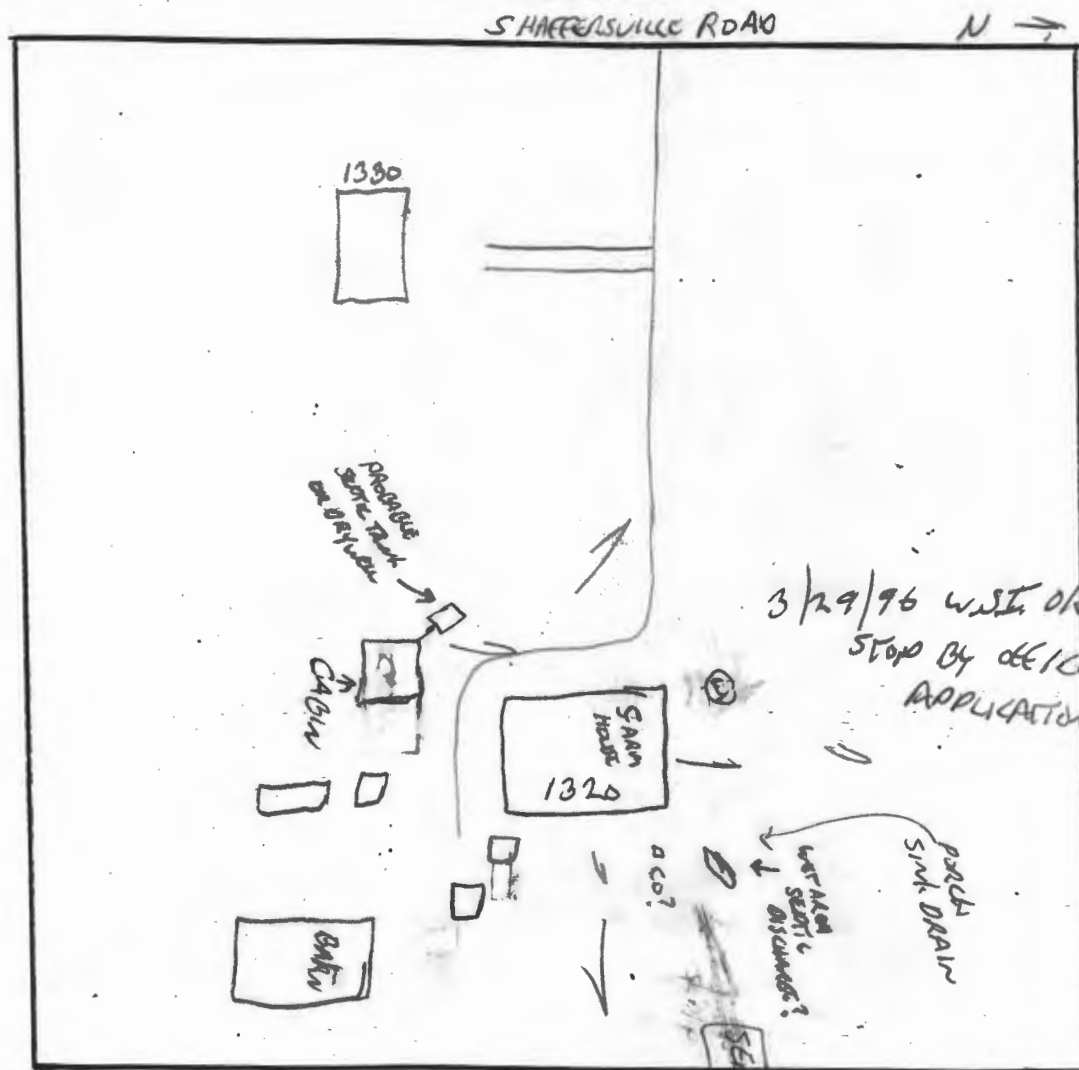

COMMENTS: DRILLER REPORTS WELL TO BE EX 1320 - OLD FARM HOUSE - NO ONE

HOME. 301-829-1093 FRED PROBST

(TENANT) 301-365-3000 - WORK @ BETHERDA FIREDEPT

DATE: _____

INSPECTOR: _____